


SECTION SUBDIVISION SURVEY
 Sec. 34, T.18S, R.26E. W.M.
 Scale: 1" = 600' Sept., 1962

Book "1" Page 138

#48904

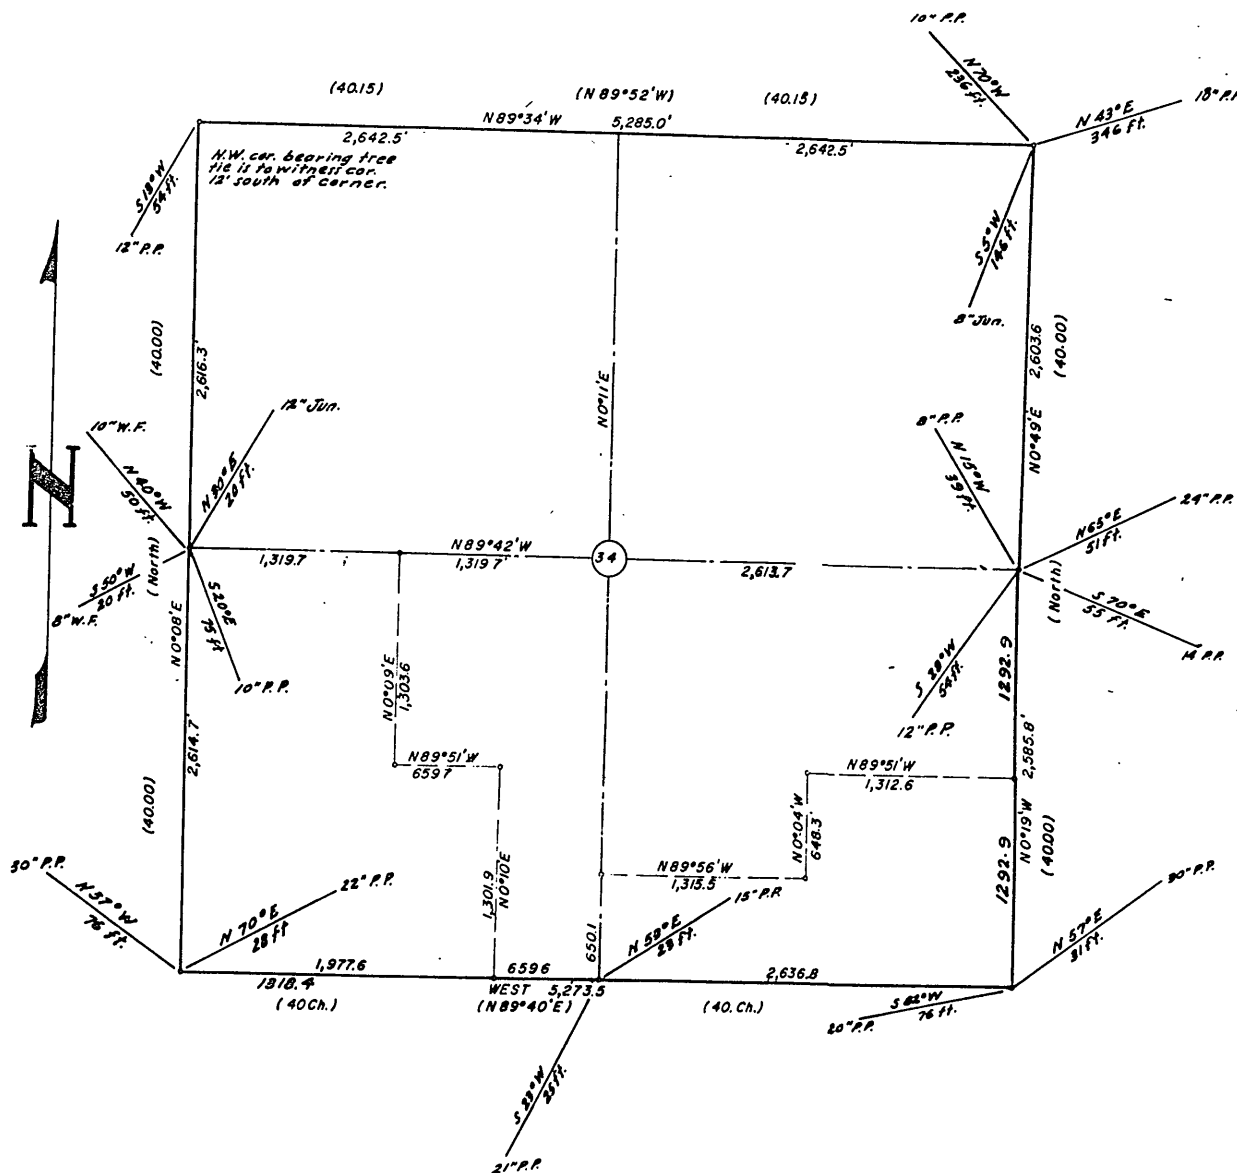

NOTE:

- Indicates iron pipe with brass cap set this survey.
- () Original Notes

I, L. C. Stratton do hereby certify that this map was made from notes taken during an actual survey.

