


WIND CREEK CADASTRAL SURVEY FOR OCHOCO NATIONAL FOREST

SECTIONS 15, 16, 21 & 22, T15S, R26E
WILLAMETTE MERIDIAN
GRANT COUNTY, OREGON
CONTRACT NO. 53-04H1-D-7949N

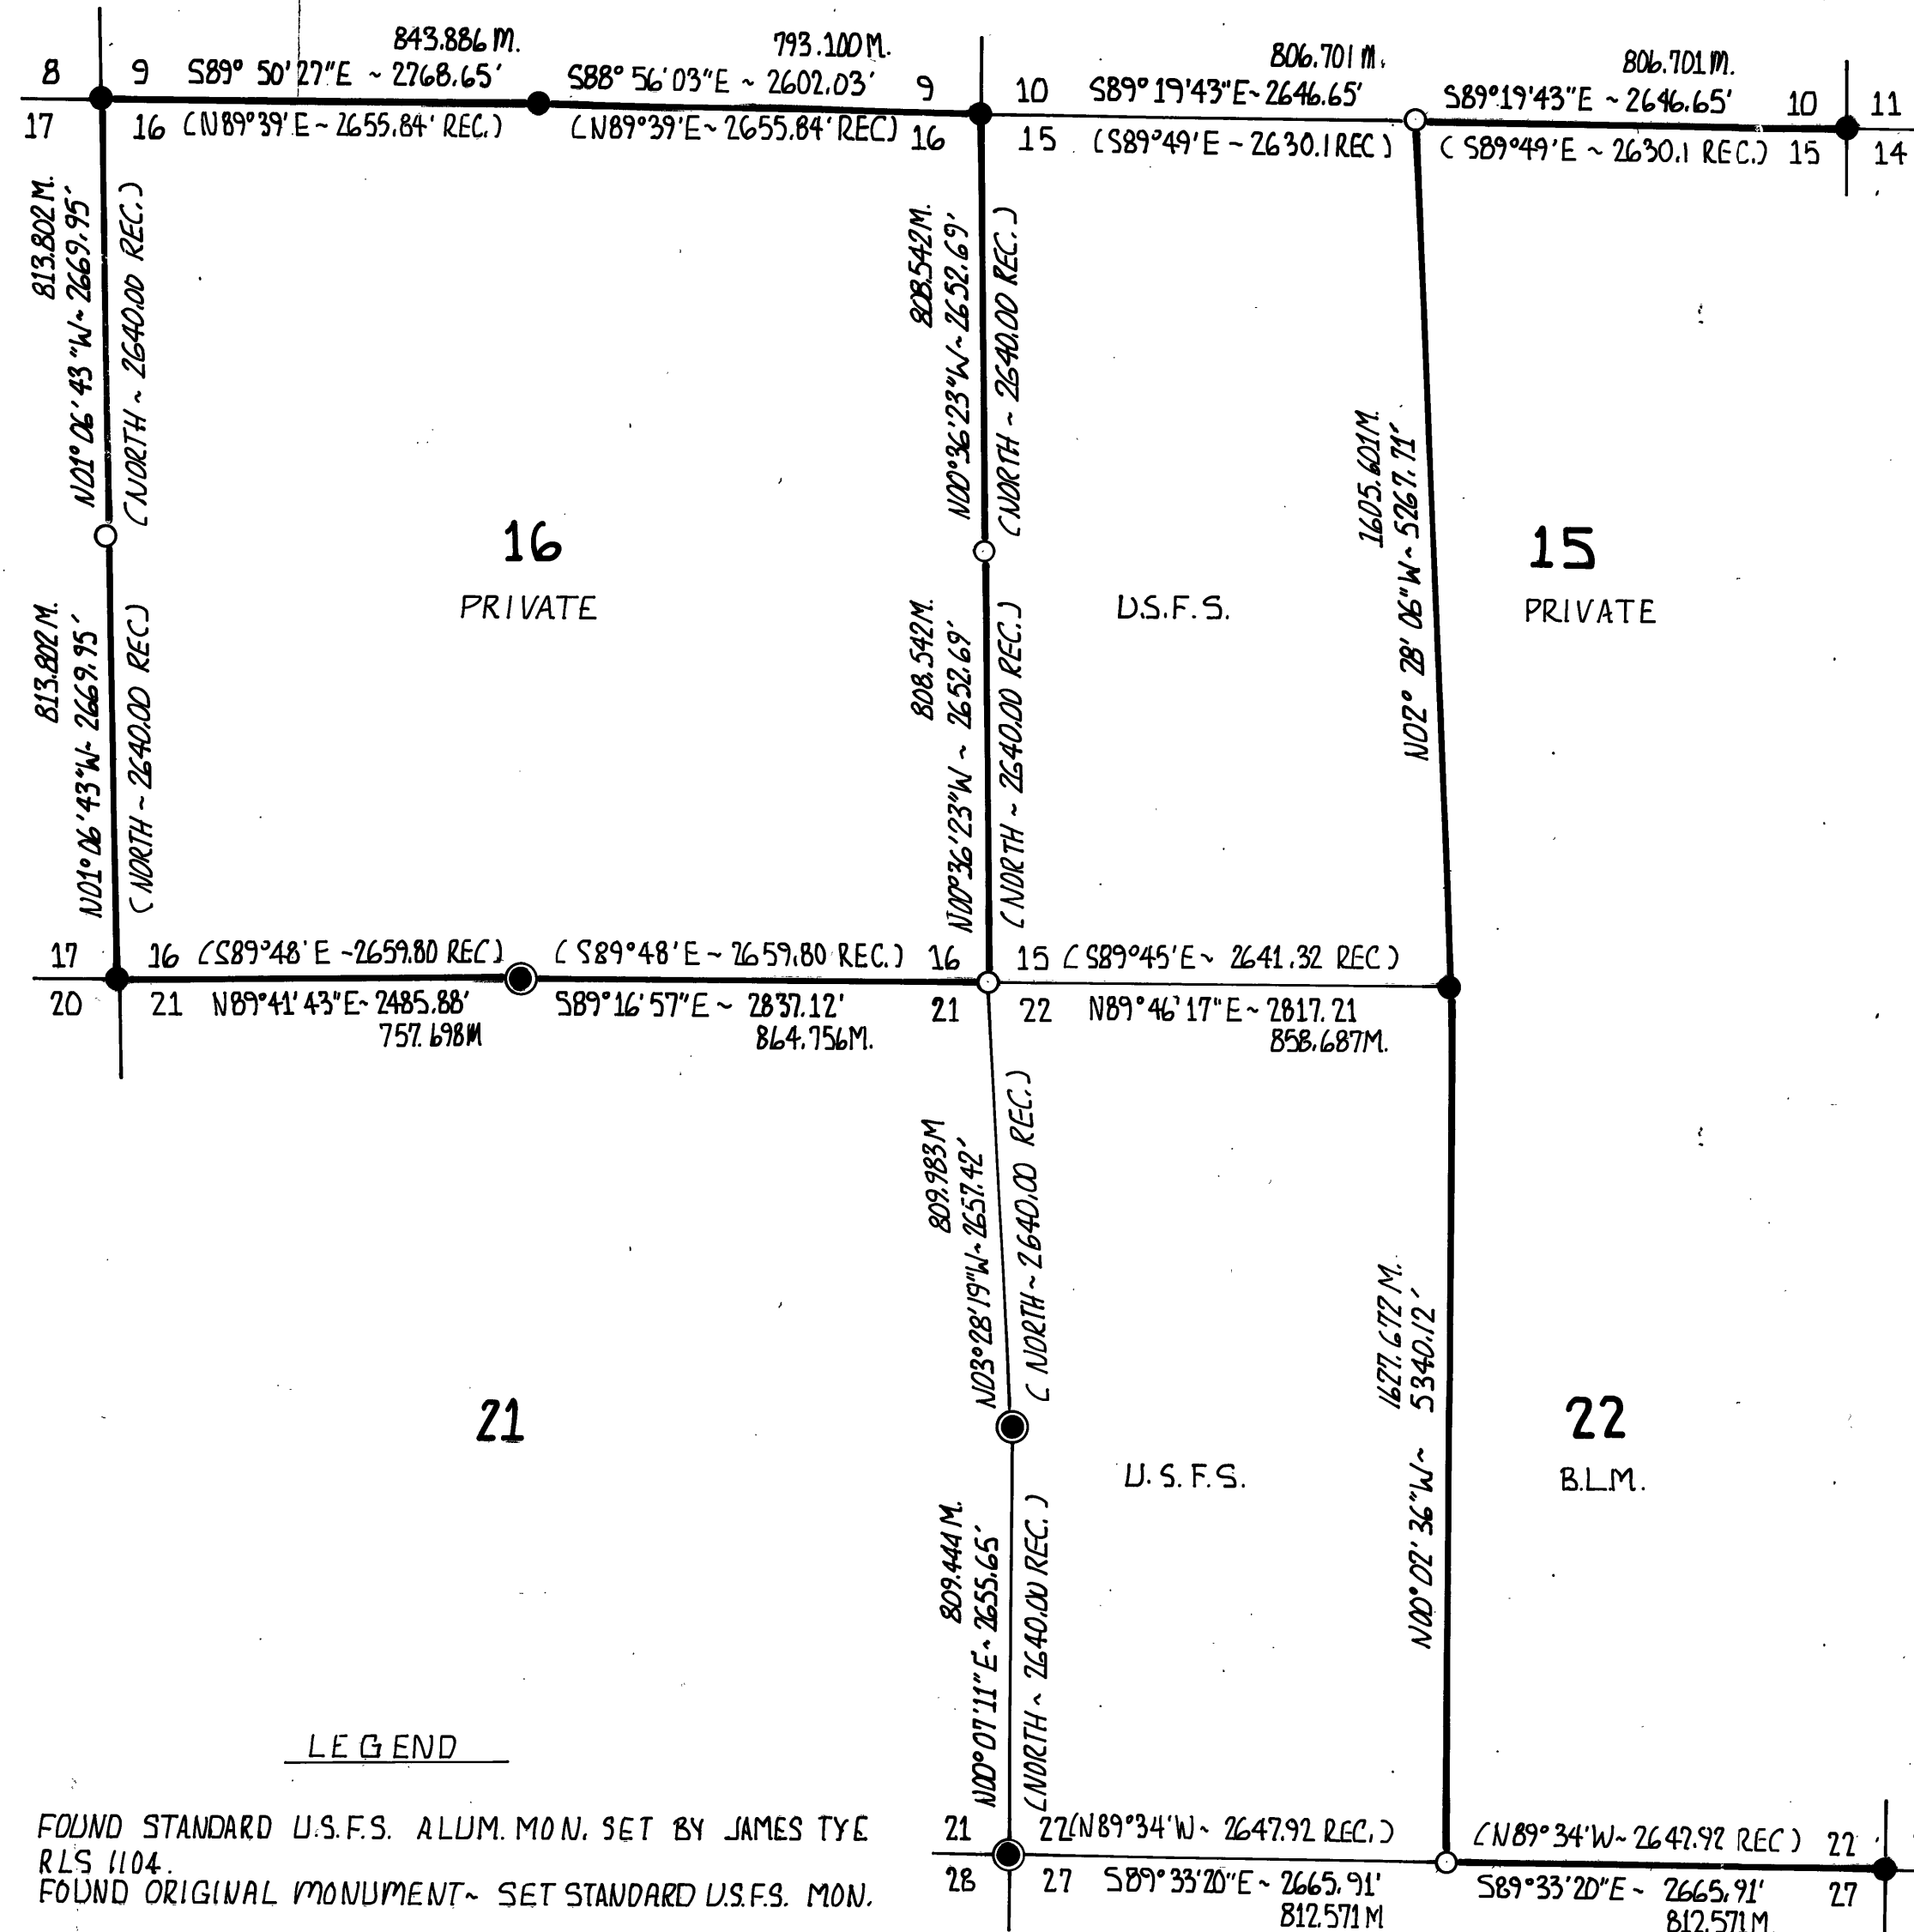

LEGEND

- FOUND STANDARD U.S.F.S. ALUM. MON. SET BY JAMES TYE RLS 1104.
- FOUND ORIGINAL MONUMENT - SET STANDARD U.S.F.S. MON.
- SET STANDARD U.S.F.S. ALUM. MON. BY P.P.P. MEAS.
- U.S.F.S. BOUNDARY LINE POSTED.



CERTIFICATE OF SURVEY

"I, H. LEON KENNEDY, A REGISTERED SURVEYOR IN THE STATE OF OREGON, HEREBY CERTIFY THAT THIS PLAT AND THE NOTES HEREON, OR ATTACHED, ARE A CORRECT REPRESENTATION OF A SURVEY I PERFORMED DURING AUGUST-SEPTEMBER, 1980 FOR THE U.S. FOREST SERVICE, IN ACCORDANCE WITH THE STATUTES OF THE STATE OF OREGON AND WITH THE ARTICLES OF MY CONTRACT."


H. Leon Kennedy

CST. H. LEON KENNEDY
REGISTERED LAND SURVEYOR
OREGON LICENSE #981

RECEIVED AND
FILED

FEB 25 1981

OFFICE OF COUNTY SURVEYOR
Attest: *Carol Wright*

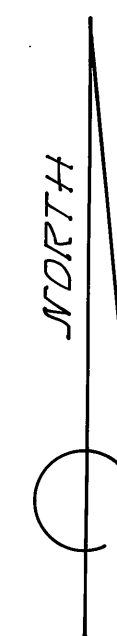

BASIS OF BEARINGS ~ SOLAR OBSERVATION

SCALE IN FEET
0 500 1000 2000

SCALE IN METERS
0 100 200 500

1 METER = 3.280833 FEET

SURVEY METHOD ~ RANDOM TRAVERSE WITH THEODOLITE, 300' TAPE AND ELECTRONIC DISTANCE METER.

HISTORY OF SURVEYS

ORIGINAL SURVEY PERFORMED BY MARK A. FULLERTON UNDER G.L.O. CONTRACT No. 395 DATED MAY 25, 1881.

U.S.F.S. FORM RG-7100-57 ARE ON FILE WITH COUNTY SURVEYOR.