



T.16 S., R 26 E. W.M.

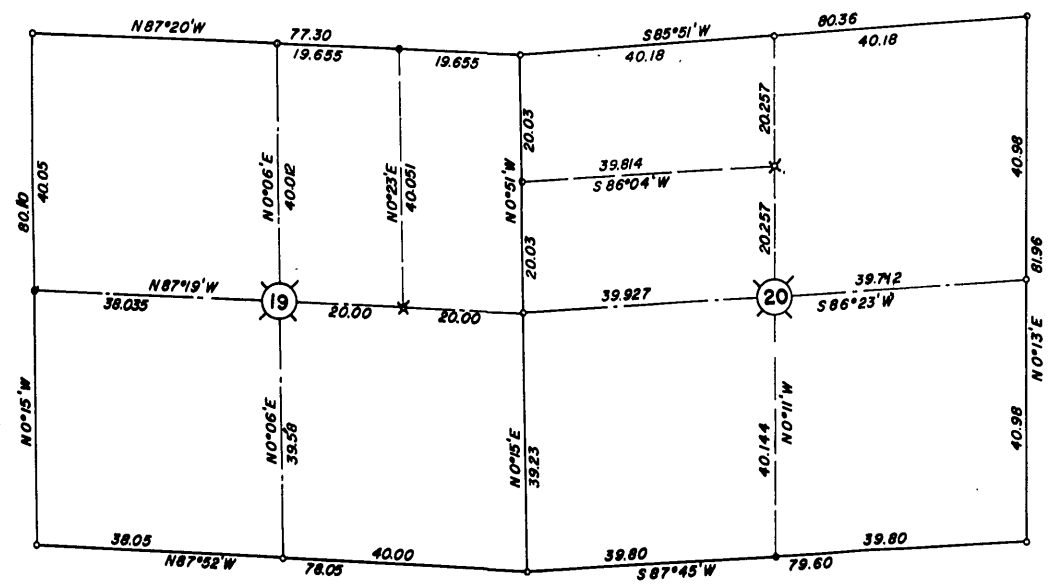

LEGEND
X represents set this survey

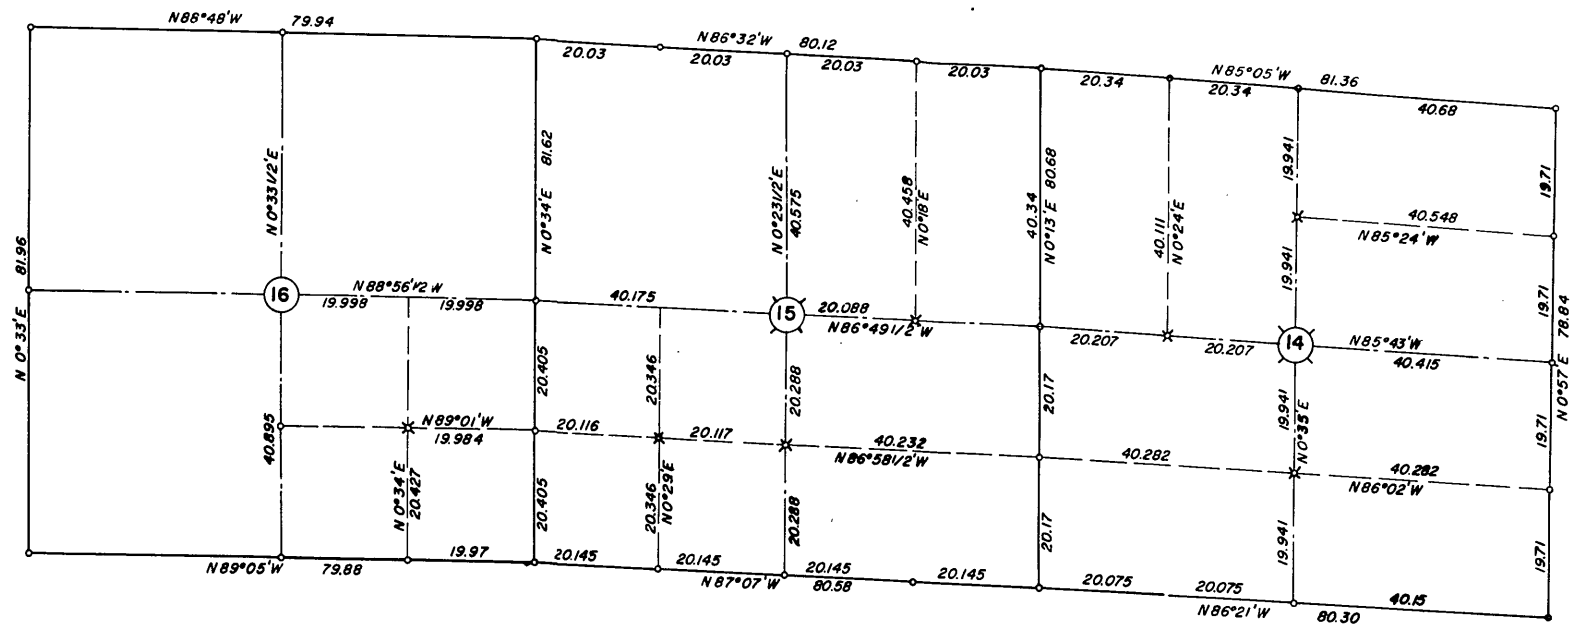

I, L. C. Stratton do hereby certify that this map was made from notes taken during an actual survey of the area represented on this map.

DEPARTMENT OF AGRICULTURE
U. S. FOREST SERVICE
OCHOCO NATIONAL FOREST
Scale: 1" = 1,000'
Aug, 1962
L. C. Stratton, Eng'r. Prineville, Ore.



Book "1" Page 123

#48903