


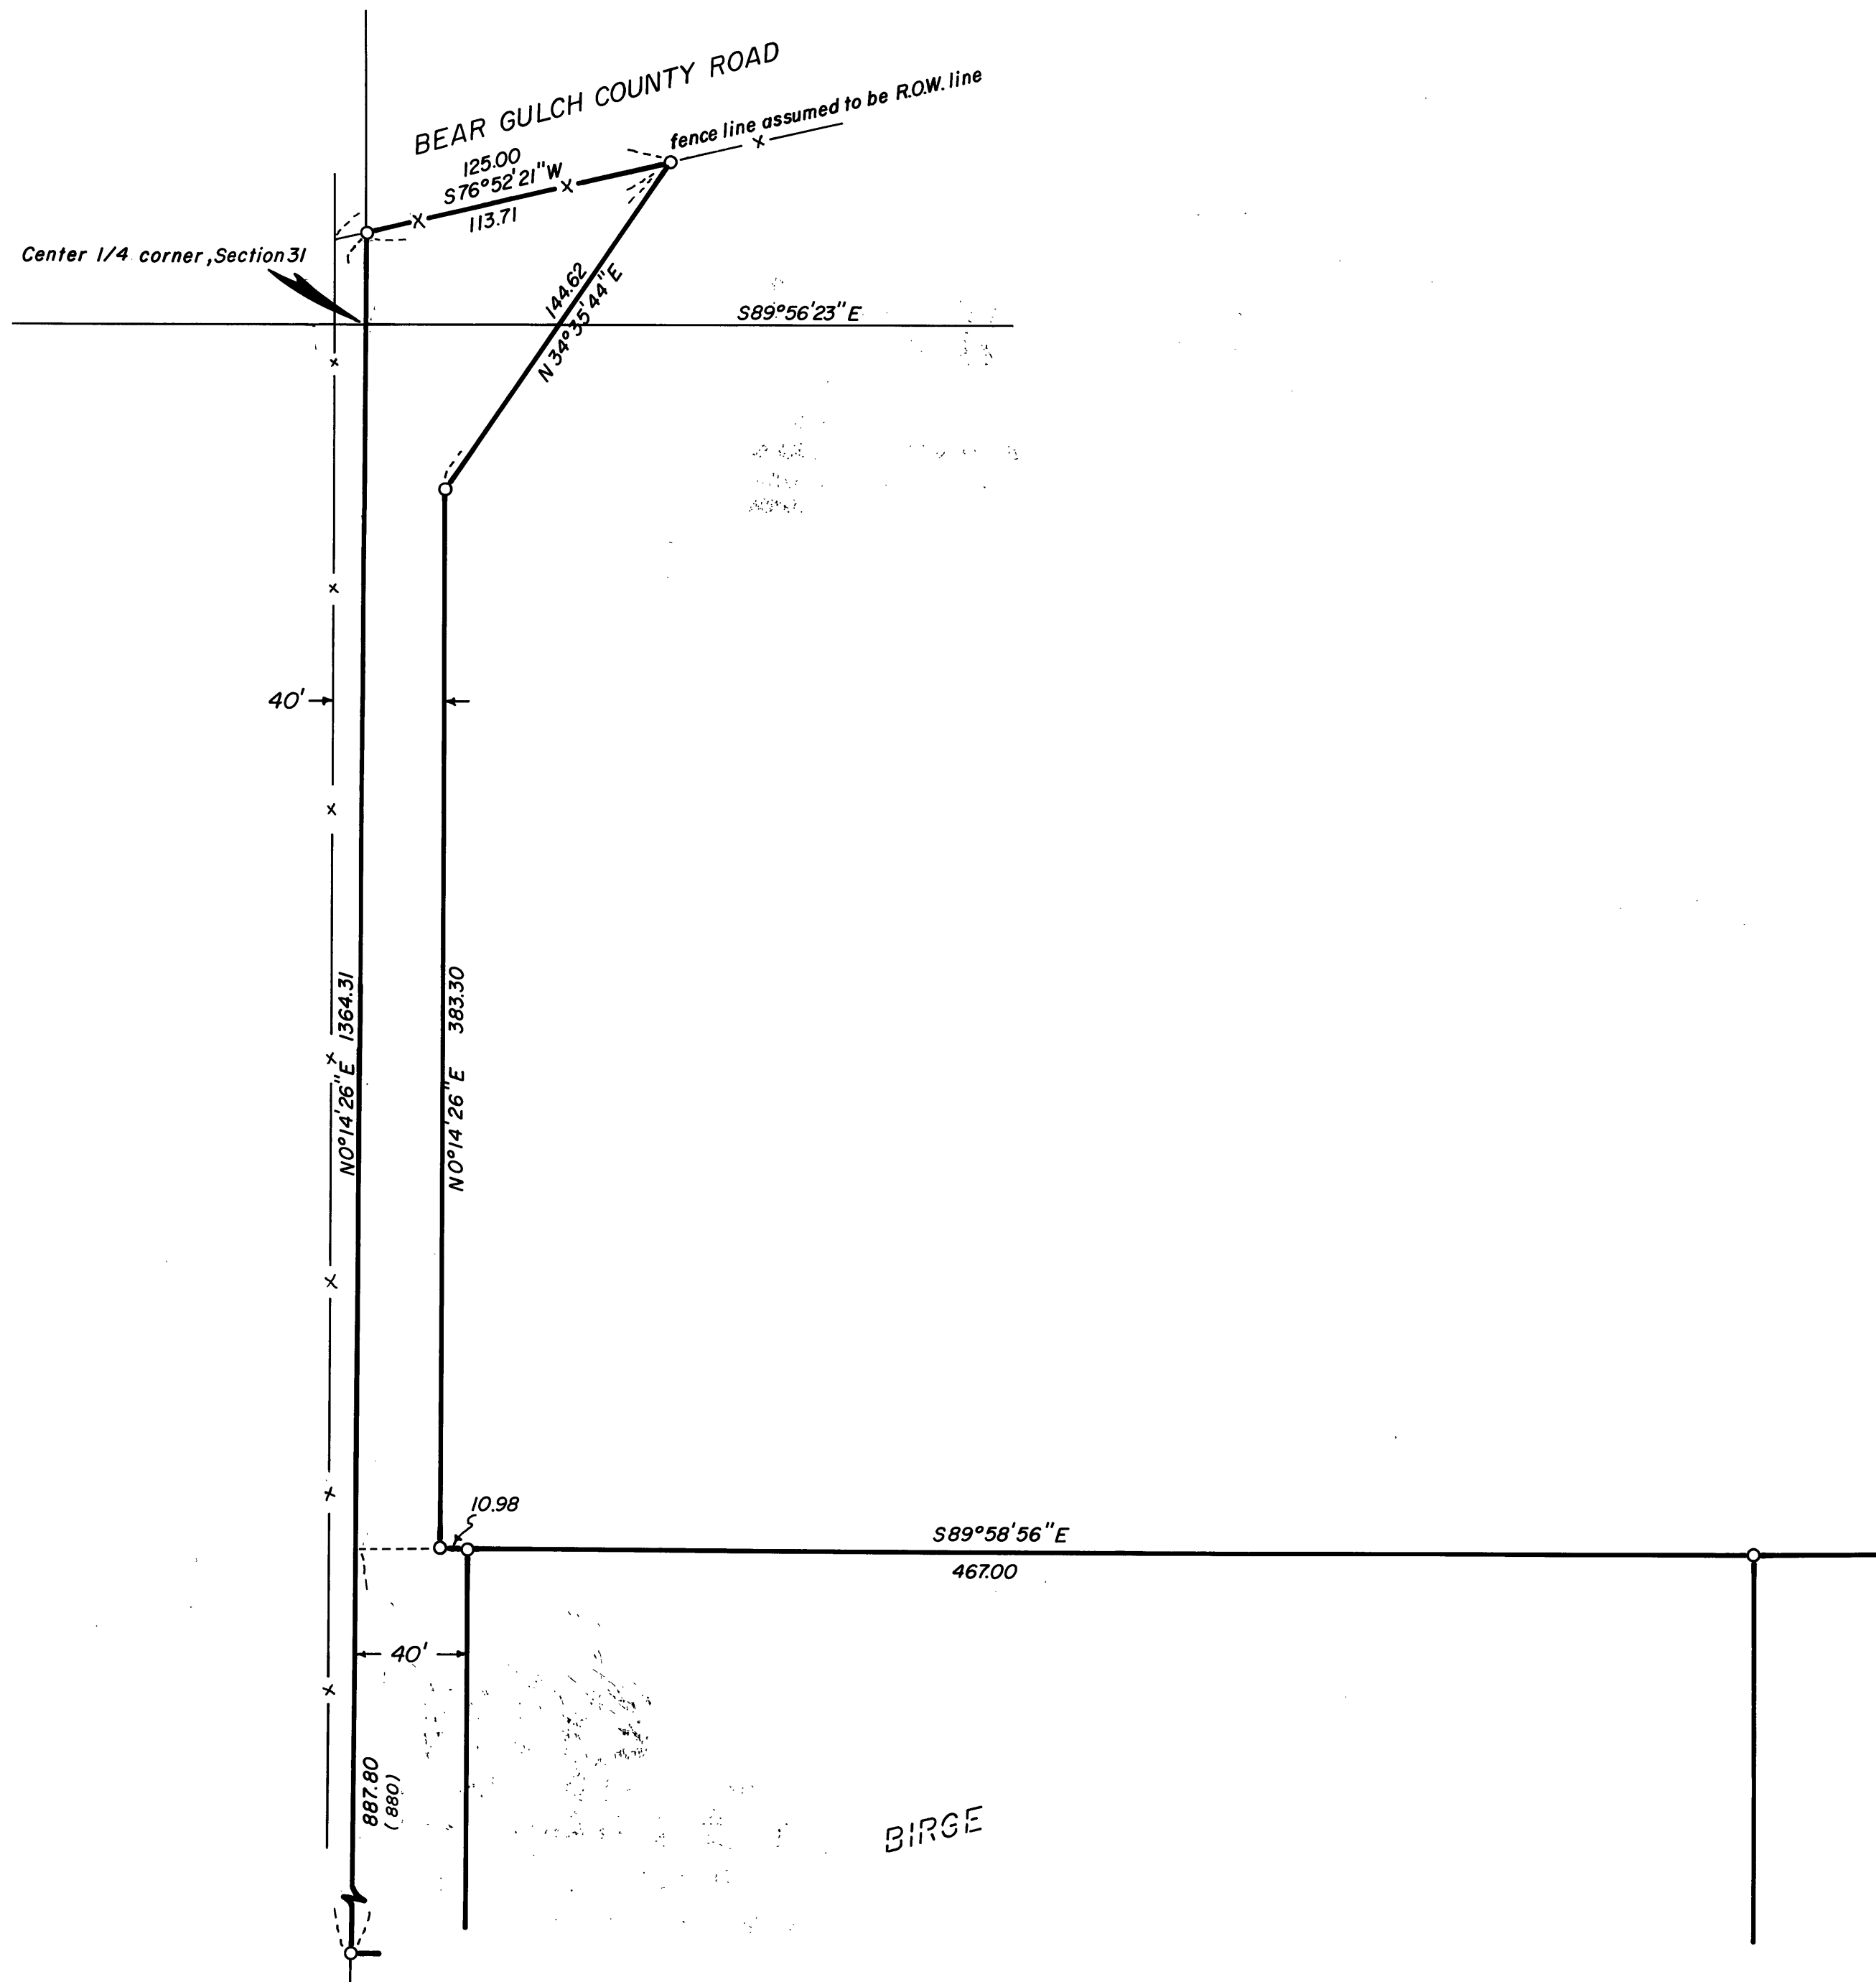

BASIS OF BEARINGS
SOLAR OBSERVATION

LEGEND

- Set 5/8"X30" iron pin, with attached plastic cap, marked "B-G-A SURVEY MARKER"
- x- Fence

REGISTERED
PROFESSIONAL
LAND SURVEYOR

Robert D. Baggett
OREGON
JULY 12, 1983
ROBERT D. BAGETT
598

BAGETT - GRIFFITH & ASSOCIATES
John Day, Oregon

DETAIL SHEET

GRANT COUNTY, OREGON

SURVEYED FOR	Mrs. Jane Colescott	
SURVEYED BY	RDB, ARC & WAP	Jun.-Jul./81
Scale: 1"=50'	Drawn by: WAP	7/11/81