

MAP OF SURVEY  
LOCATED IN SECTIONS 3, 4, 9, 10, 15 & 16, T. 8 S.,  
R. 32 E., W.M., GRANT COUNTY, OREGON.  
FOR  
**THE U.S. FOREST SERVICE**  
REF. CONTRACT NO. 53-04R3-1-01164


BASIS OF BEARING: SOLAR OBSERVATION  
FOUND: ○ B.L.M. PIPE AND BRASS CAP 1968  
SET: ● 2"X30" FLANGED G.I.P. / 2 1/2" BRASS CAP

SCALE: 1" = 500 ft.  
METER: m = 3.28083333 ft.  
REF: FIELDBOOK 1 THRU 7, DEEP PUTNEY CADASTRAL  
SURVEY CONTRACT NO. 53-04R3-1-01164  
DATE: SURVEY BEGAN February 7, 1981  
COMPLETED April 4, 1981

FEET: 0 500 1000 1500  
METERS: 0 100 200 300 400

CONTRACT SURVEYOR'S CERTIFICATE:  
I, KURT C. WEAVER, A REGISTERED PROFESSIONAL LAND SURVEYOR IN  
THE STATE OF OREGON, HEREBY CERTIFY THAT THIS PLAT AND THE  
NOTES HEREON, OR ATTACHED, ARE A CORRECT REPRESENTATION OF  
A SURVEY PERFORMED BY ME OR UNDER MY DIRECTION DURING MARCH  
1981, AT THE REQUEST OF THE U.S.D.A. FOREST SERVICE, IN ACCO-  
RDANCE WITH THE STATUTES OF THE STATE OF OREGON AND WITH THE  
ARTICLES OF MY CONTRACT.

*Kurt C. Weaver*  
KURT C. WEAVER  
REGISTERED PROFESSIONAL LAND SURVEYOR  
OREGON LICENSE NO. 1679

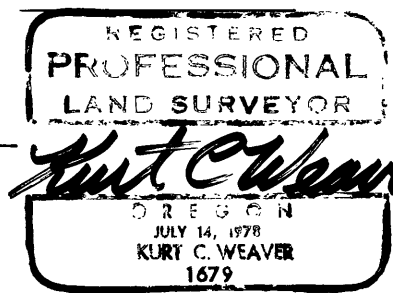

HISTORY:  
THE SUBDIVISION OF T.8S. R.32E. WAS DONE BY  
HERMAN D. GRADON UNDER G.L.O. CONTRACT NO. 499  
DATE 1884. ALL FOUND MONUMENTS SHOWN ARE  
1968 B.L.M. MONUMENTS WHICH ARE NOT OF  
PUBLIC RECORD.

PROCEDURE:  
ALL CONTROLLING CORNERS WERE ENCOMPASSED IN A SERIES OF CLOSED TRAVERSES MADE  
WITH A WILD T-2 THEODOLITE AND AN H.P. 3805A E.D.M. QUARTER CORNERS FOR NINE  
AND SIXTEEN, NINE AND TEN WERE RE-ESTABLISHED FROM ORIGINAL EVIDENCE. THE  
N.W. AND S.W. CORNERS OF SEC. 10 WERE SET BY DOUBLE PROPORTIONATE MEASUREMENT.  
THE SOUTH AND EAST 1/4 CORNERS OF SECTION 10 AND THE NORTH 1/4 CORNER OF SECTION 9 WERE SET  
BY SINGLE PROPORTION MEASUREMENT. PROPORTIONED CORNERS WERE SET ONLY AFTER A DILIGENT SEARCH  
WAS MADE FOR ORIGINAL EVIDENCE. SECTION 10 WAS SUBDIVIDED AS SHOWN HEREON AND THE HEAVY LINE  
IN SECTION 10 WAS MARKED AS THE NATIONAL FOREST PROPERTY BOUNDARY.



(Rec. N 89° 47' W 2651.88')  
N 89° 09' 53" W 2538.94' 773.870 m  
1/4 16

(Rec. S 0° 53' W 2640.0')  
N 1° 53' 22" W 2674.58'  
N 2° 17' 00" E 2654.69'  
(Rec. NORTH 2640.0')  
N 1° 03' 17" W 5306.06' 1617.290 m

(Rec. N 89° 59' W 2629.44')  
N 89° 19' 09" W 2611.86 796.096 m

(Rec. N 89° 59' W 2629.44')  
N 89° 52' 10" W 2679.61' 816.747 m

1630.900 m  
1345.17'  
5350.71'  
410.006 m  
1345.16'

N 89° 53' 52" E  
2643.09' 805.615 m

S 89° 39' 50" W 5081.74' 1548.918 m

S 01° 01' 51" W  
2660.36' 810.885 m

(Rec. N 89° 51' W 5291.88')  
S 89° 50' 24" W 5066.00' 1544.120 m  
2533.00' 772.059 m

1335.50' 407.061 m  
502° 36' 21" W 1335.50' 407.061 m  
(Rec. NORTH 5280.0')

2671.01' 814.126 m

RECEIVED AND  
FILED

AUG 11 1981

OFFICE OF COUNTY SURVEYOR

Attest: *Carole Wright*