



HISTORY
 THE SUBDIVISION OF T.8S., R.32E. WAS DONE BY HERMAN D. GRADON UNDER G.L.O. CONTRACT No. 499 DATE 1884. ALL FOUND MONUMENTS SHOWN ARE 1968 B.L.M. MONUMENTS WHICH ARE NOT OF PUBLIC RECORD.

PROCEDURE
 ALL CONTROLLING CORNERS WERE ENCOMPASSED IN A SERIES OF CLOSED TRAVERSES MADE WITH A WILD T-2 THEODOLITE AND AN H.P. 3805A E.D.M. THE PROPORTIONED CORNERS WERE SET ONLY AFTER EXTENSIVE SEARCH IN THE VICINITIES FAILED TO YIELD ORIGINAL EVIDENCE. THE SECTIONS WERE SUBDIVIDED AS SHOWN HEREON AND THE HEAVY LINES WERE MARKED AS THE NATIONAL FOREST PROPERTY BOUNDARY

RECEIVED AND FILED
 AUG 11 1981
 OFFICE OF COUNTY SURVEYOR
Robert D. Bagitt
 Co. CLK.




MAP OF SURVEY
 LOCATED IN SECTIONS 11 & 12 T.8S., R.32E.,
 W.M. GRANT COUNTY, OREGON
 FOR
THE U.S. FOREST SERVICE

REF. CONTRACT No. 53-04R3-1-01163
 Basis of bearing Solar Observation
 Found ● B.L.M. Pipe and brass cap 1968
 Set ○ 2" X 30" Flanged G.I.P. W/ 2 1/2" brass cap
 Scale 1" = 500'
 Meter m = 3.28083333 ft.
 Ref. : Fieldbooks 1 thru 7, Deep Putney cadastral survey contract No. 53-04R3-1-01163
 Date : Survey began FEBRUARY 9, 1981
 Completed APRIL 29, 1981

CONTRACT SURVEYOR'S CERTIFICATE
 I, KURT C. WEAVER, A REGISTERED PROFESSIONAL LAND SURVEYOR IN THE STATE OF OREGON, HEREBY CERTIFY THAT THIS PLAT AND THE NOTES HEREON, OR ATTACHED, ARE A CORRECT REPRESENTATION OF A SURVEY PERFORMED BY ME OR UNDER MY DIRECTION DURING APRIL 1981, AT THE REQUEST OF THE U.S.D.A. FOREST SERVICE, IN ACCORDANCE WITH THE STATUTES OF THE STATE OF OREGON AND WITH THE ARTICLES OF MY CONTRACT.

Kurt C. Weaver

KURT C. WEAVER
 REGISTERED PROFESSIONAL LAND SURVEYOR
 OREGON LICENSE No. 1679

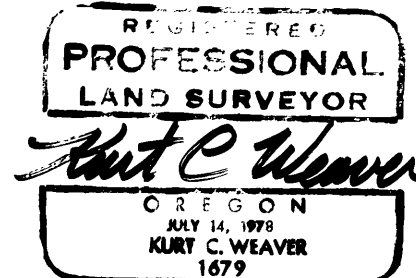

(Rec. NORTH 5280') 1610.115m
 (Rec. NORTH 2640') 264.126' 805.098m
 (Rec. NORTH 2640') 264.126' 805.098m
 (Rec. NORTH 5280') 1610.115m
 13 18
 24 19