


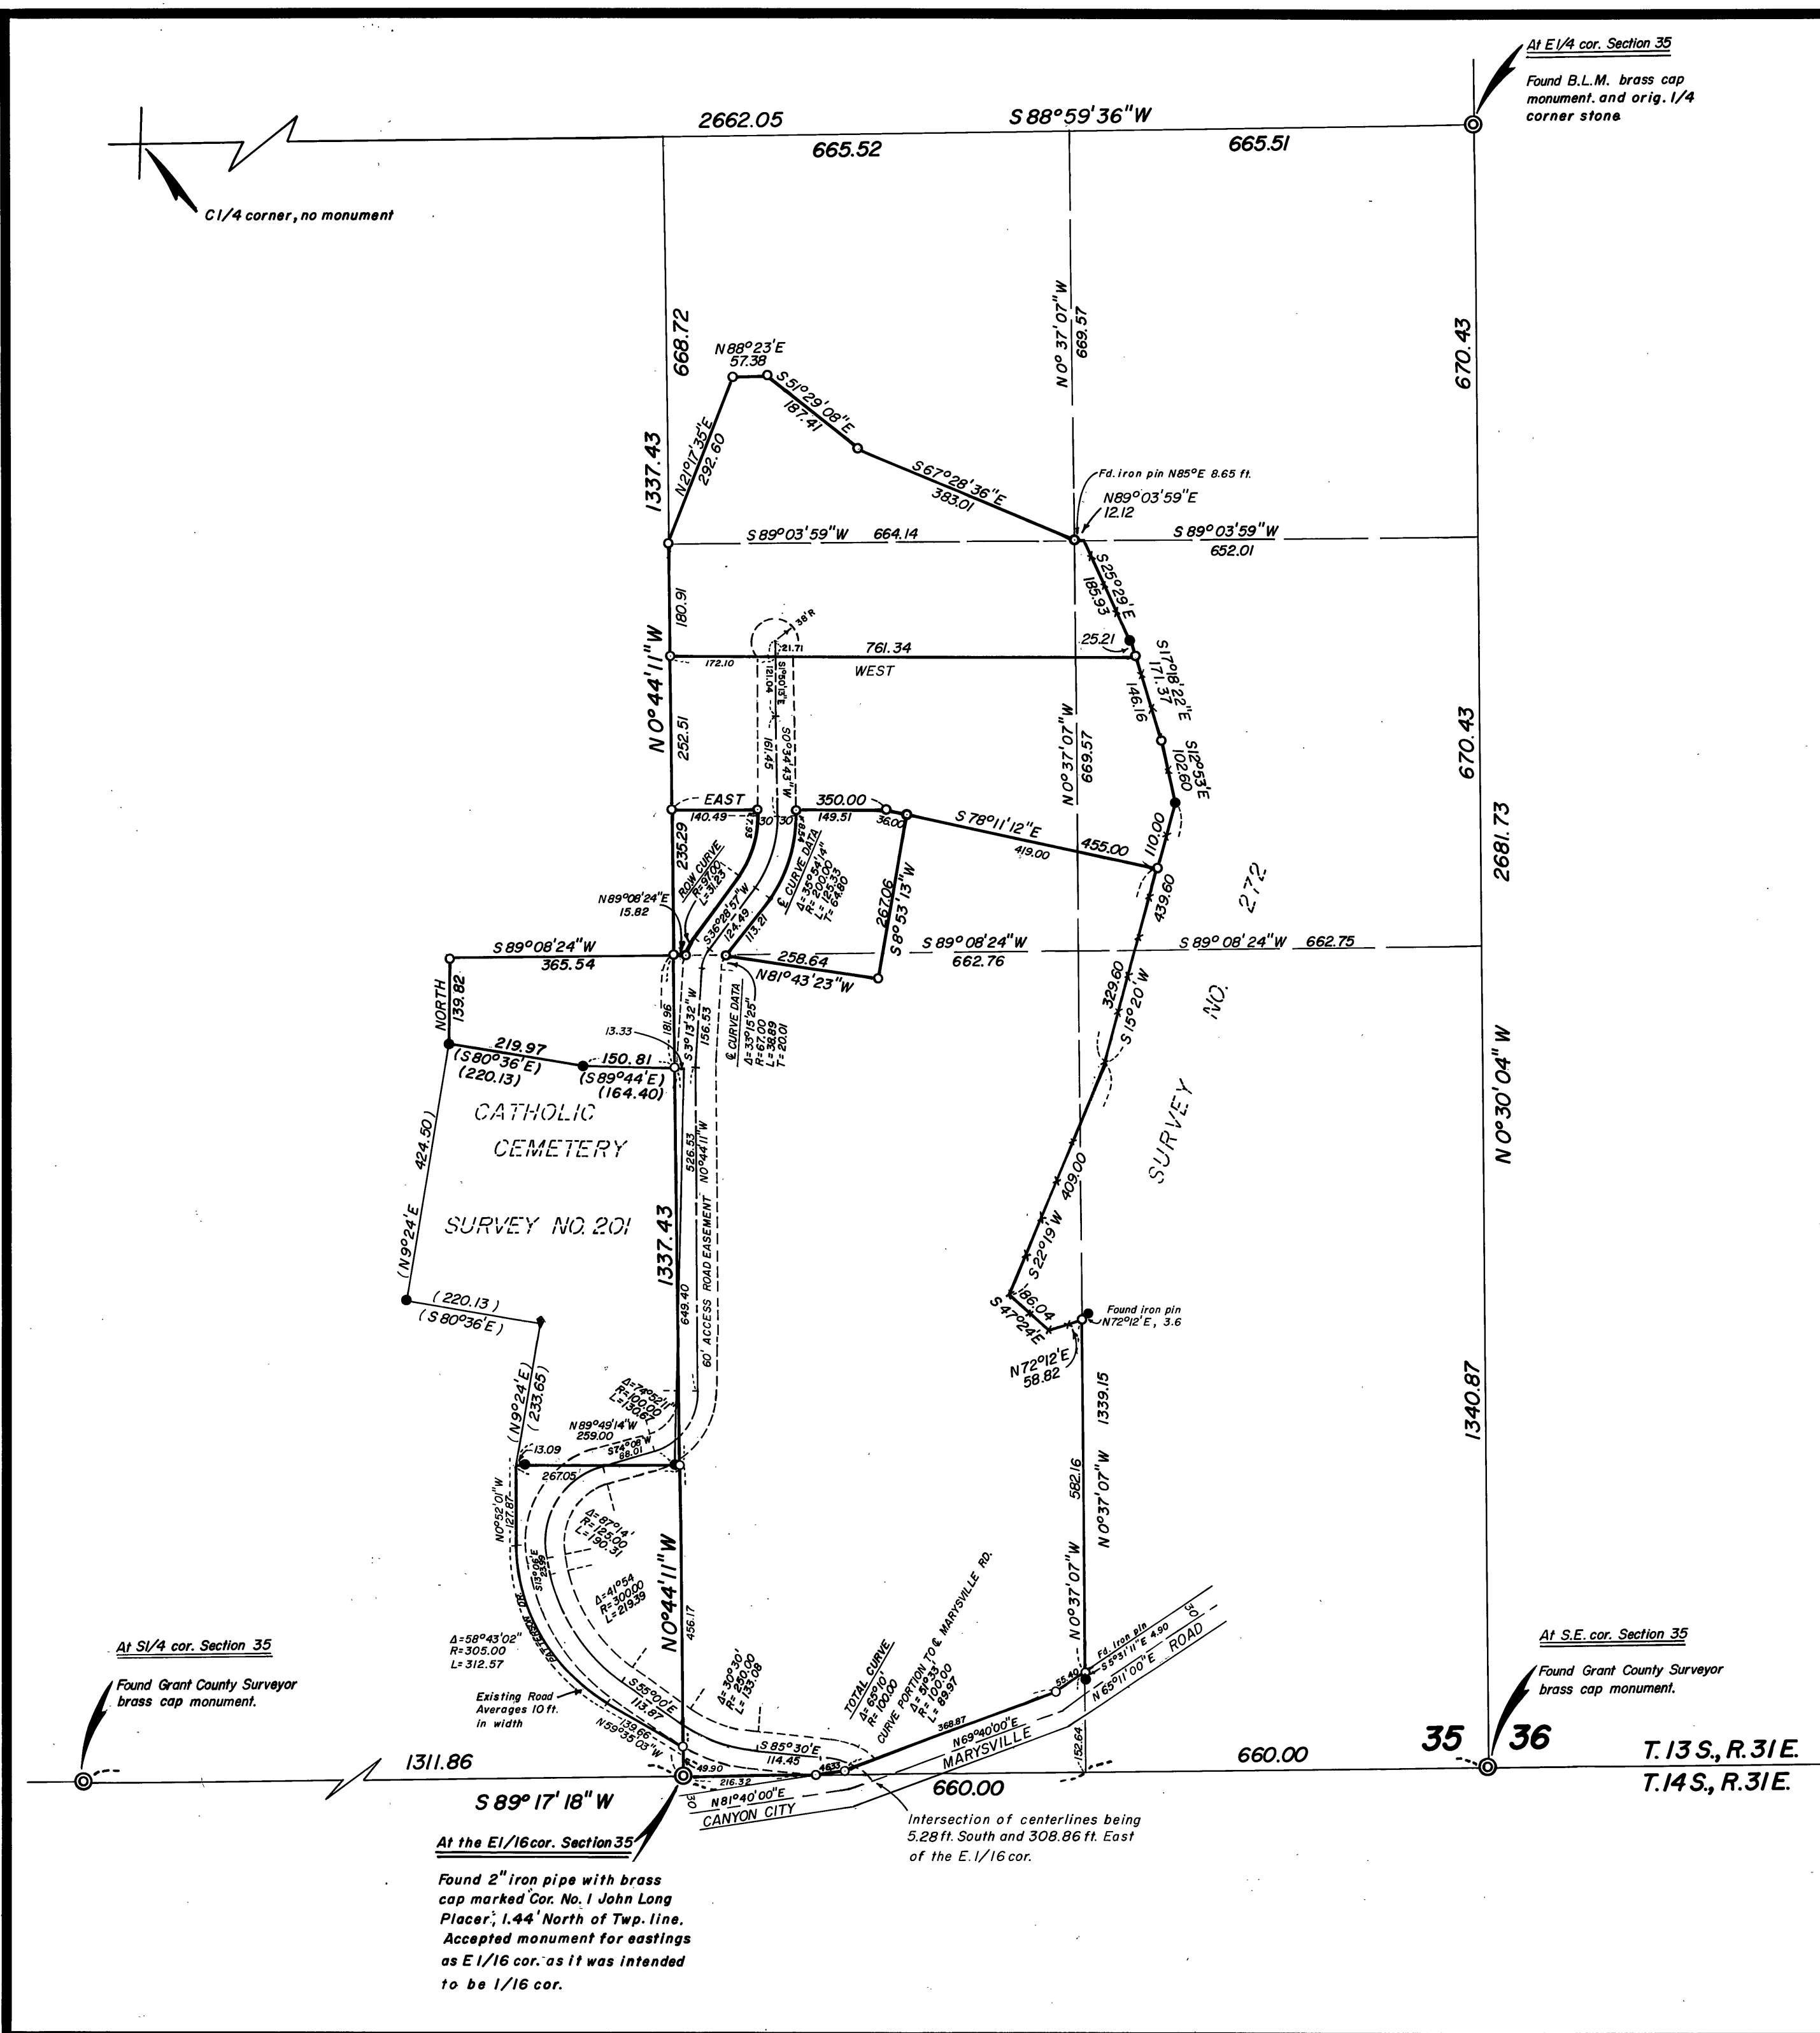

BASIS OF BEARINGS
SOLAR OBSERVATION

LEGEND

- Set 5/8"x30" iron pin with attached plastic cap marked B-G-A SURVEY MARKER
- ⊙ Found brass cap monument of record
- Found monument of record
- ◆ Found R.R. spike of record
- x- Fence
- () Record bearing and distance

REFERENCES

Map of Survey No.s 201, 272 & 361

NOTES:

1. See Map of Survey No. 361 for subdivision of Section 35, on which this Survey is based.
2. See attached Narrative

RECEIVED AND FILED

SEP 14 1981

DEPT. OF CLERK & SURVEYOR
Robert D. Bagett
Clerk

REGISTERED PROFESSIONAL LAND SURVEYOR
Robert D. Bagett
OREGON
JULY 12, 1963
ROBERT D. BAGETT
598

BAGETT - GRIFFITH & ASSOCIATES John Day, Oregon Map of Survey		
Tracts in the SE1/4 of Section 35 T13S, R31E, WM CANYON CITY GRANT COUNTY, OREGON		
SURVEYED FOR	JACK EASLEY & DAN RICE	
SURVEYED BY	R.D.B., G.L.E. & W.A.R.	Jan.- Aug. 1981
Scale: 1"= 200'	Drawn by: G.L.E. & W.A.R.	Mar.- Aug. 1981