



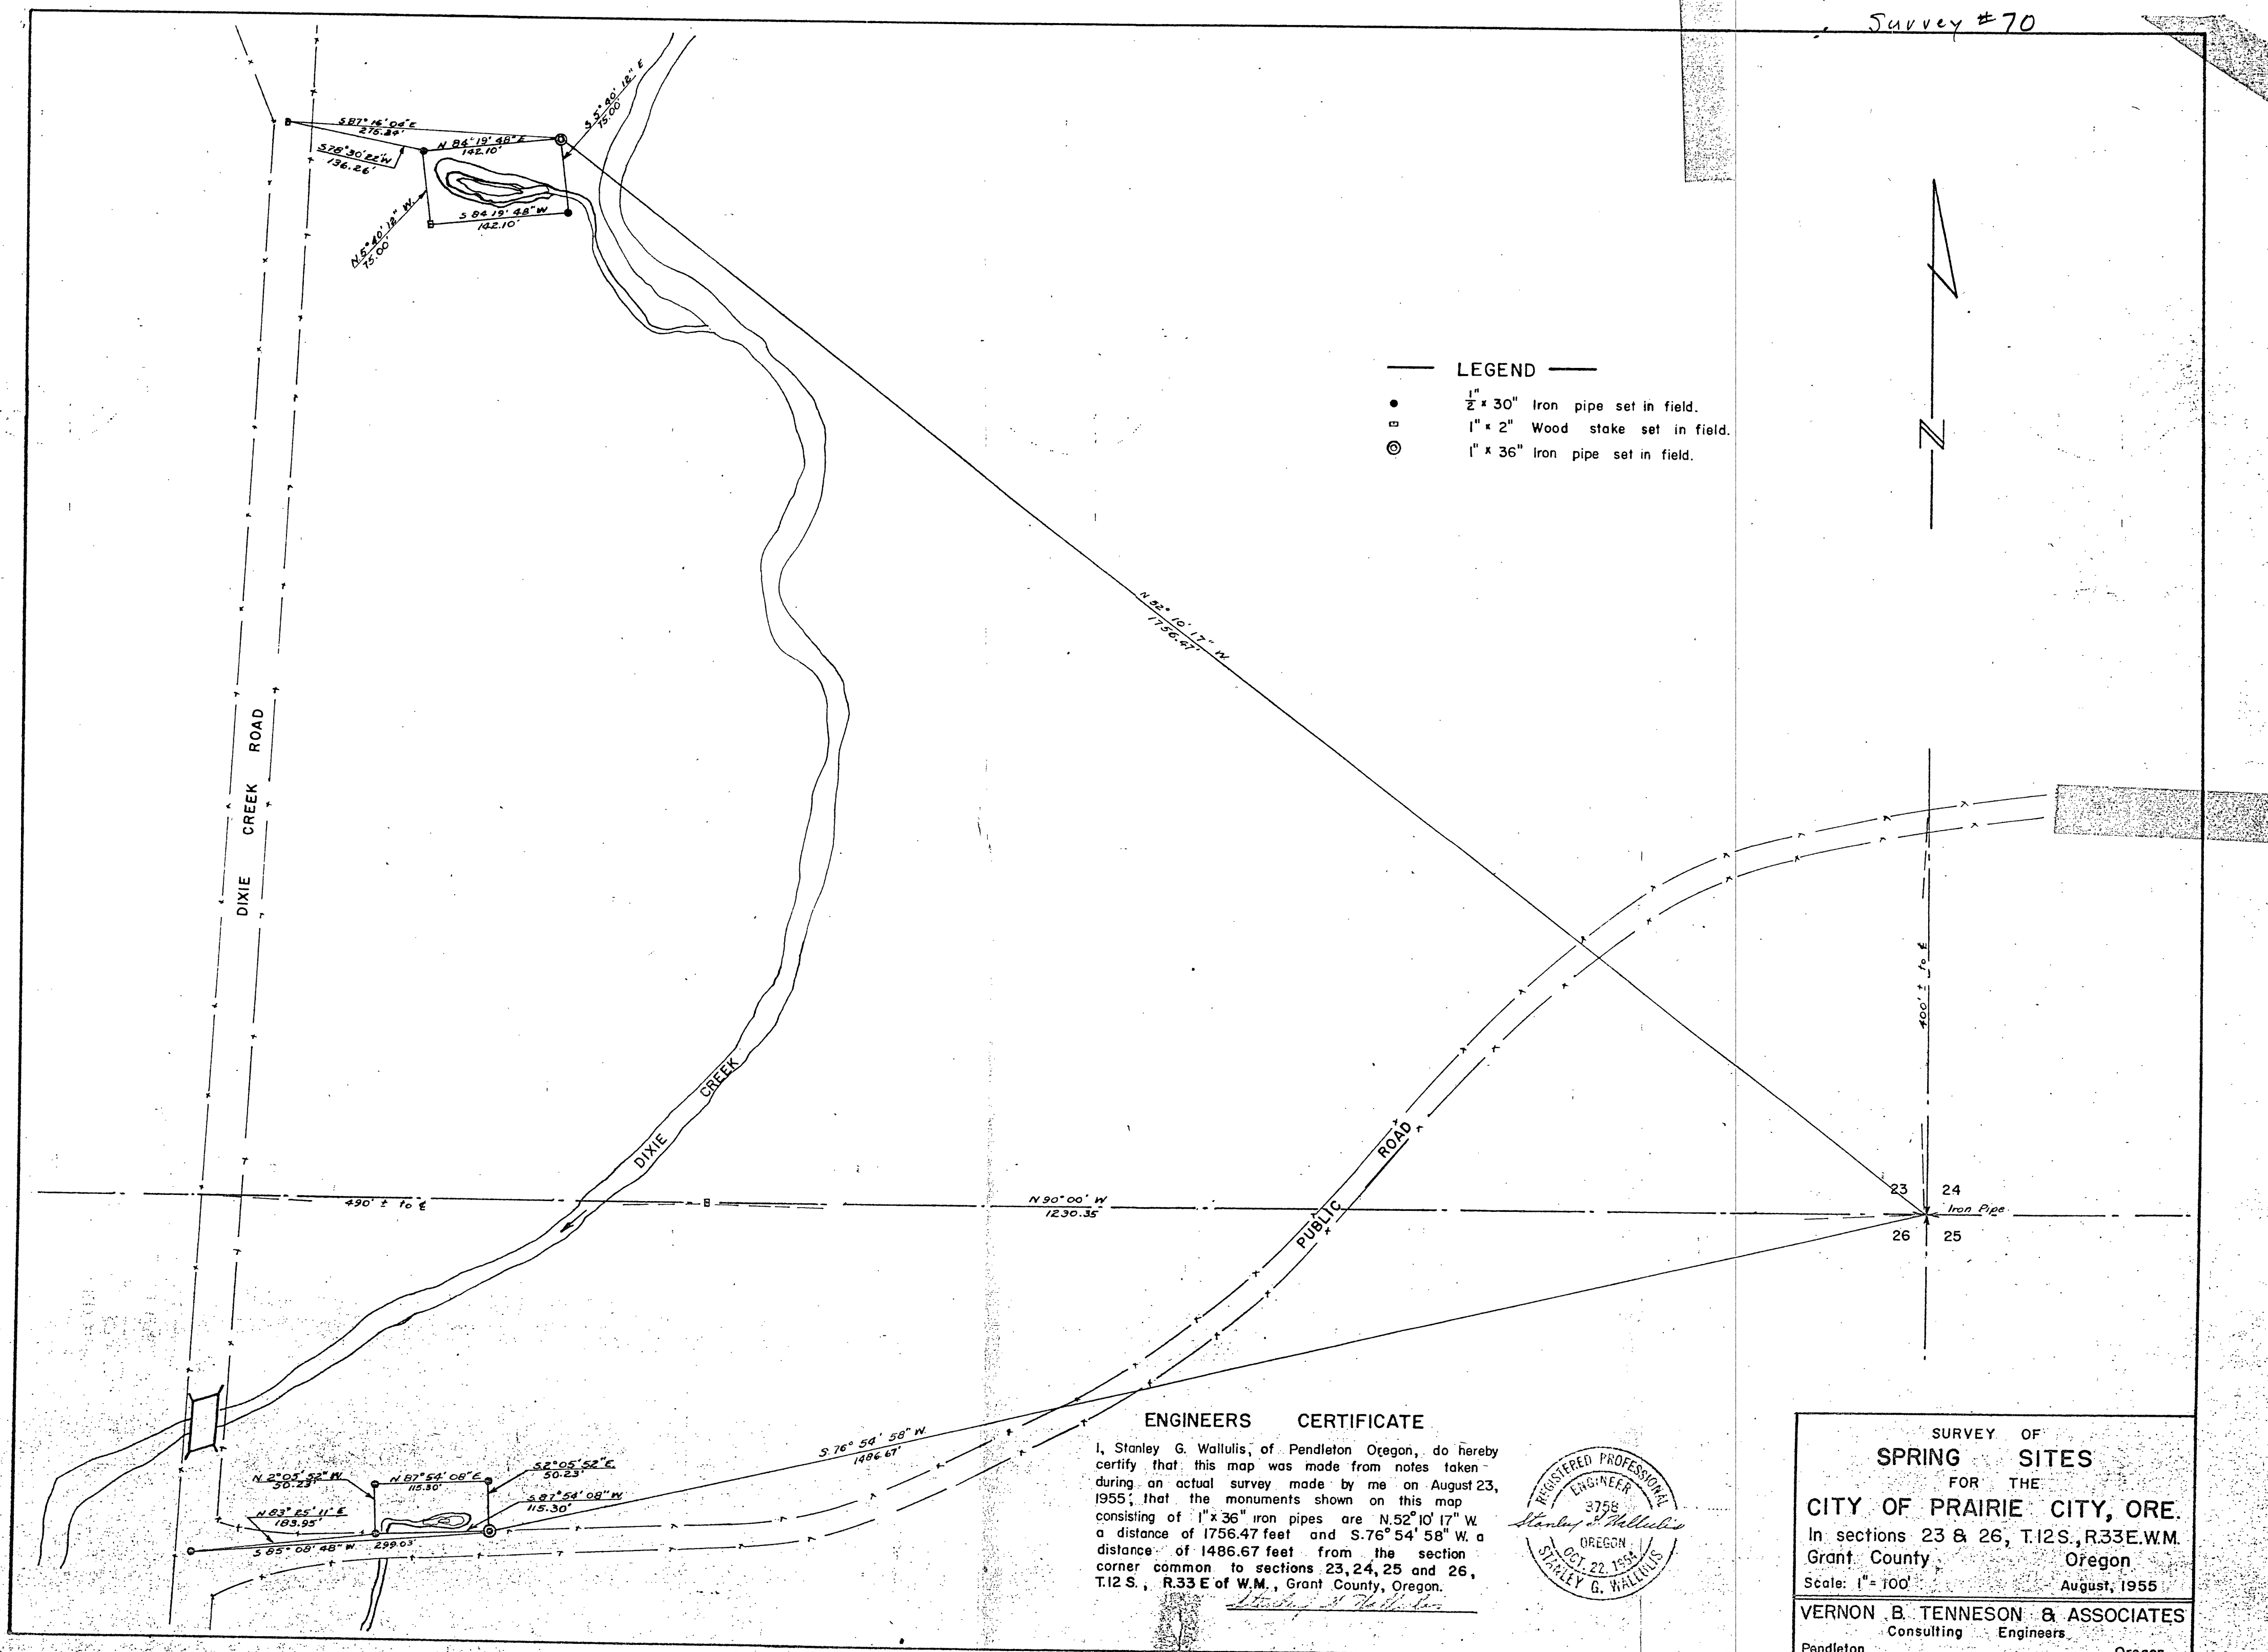

ENGINEERS CERTIFICATE

I, Stanley G. Wallulis, of Pendleton Oregon, do hereby certify that this map was made from notes taken during an actual survey made by me on August 23, 1955; that the monuments shown on this map consisting of 1"x36" iron pipes are N.52°10'17" W. a distance of 1756.47 feet and S.76°54'58" W. a distance of 1486.67 feet from the section corner common to sections 23,24,25 and 26, T.12 S. , R.33 E of W.M. , Grant County, Oregon.


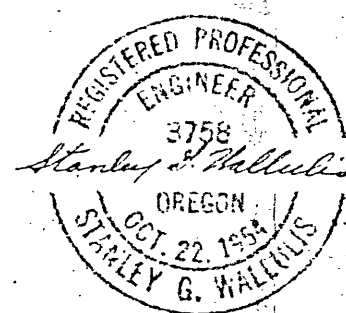

SURVEY OF SPRING SITES FOR THE

CITY OF PRAIRIE CITY, ORE.

In sections 23 & 26, T.12S., R.33E.W.M.
Grant County Oregon

Scale: 1" = 100'

August, 1955

VERNON B. TENNESON & ASSOCIATES
Consulting Engineers
Pendleton Oregon