



U. S. FOREST SERVICE
CRANE PRAIRIE CADASTRAL SURVEY

MALHEUR NATIONAL FOREST GRANT COUNTY, OREGON

SECTIONS 25 and 36, T16S, R34E, W.M.


CONTRACT NUMBER 53-04H1-1-8537N

SEPTEMBER 1981

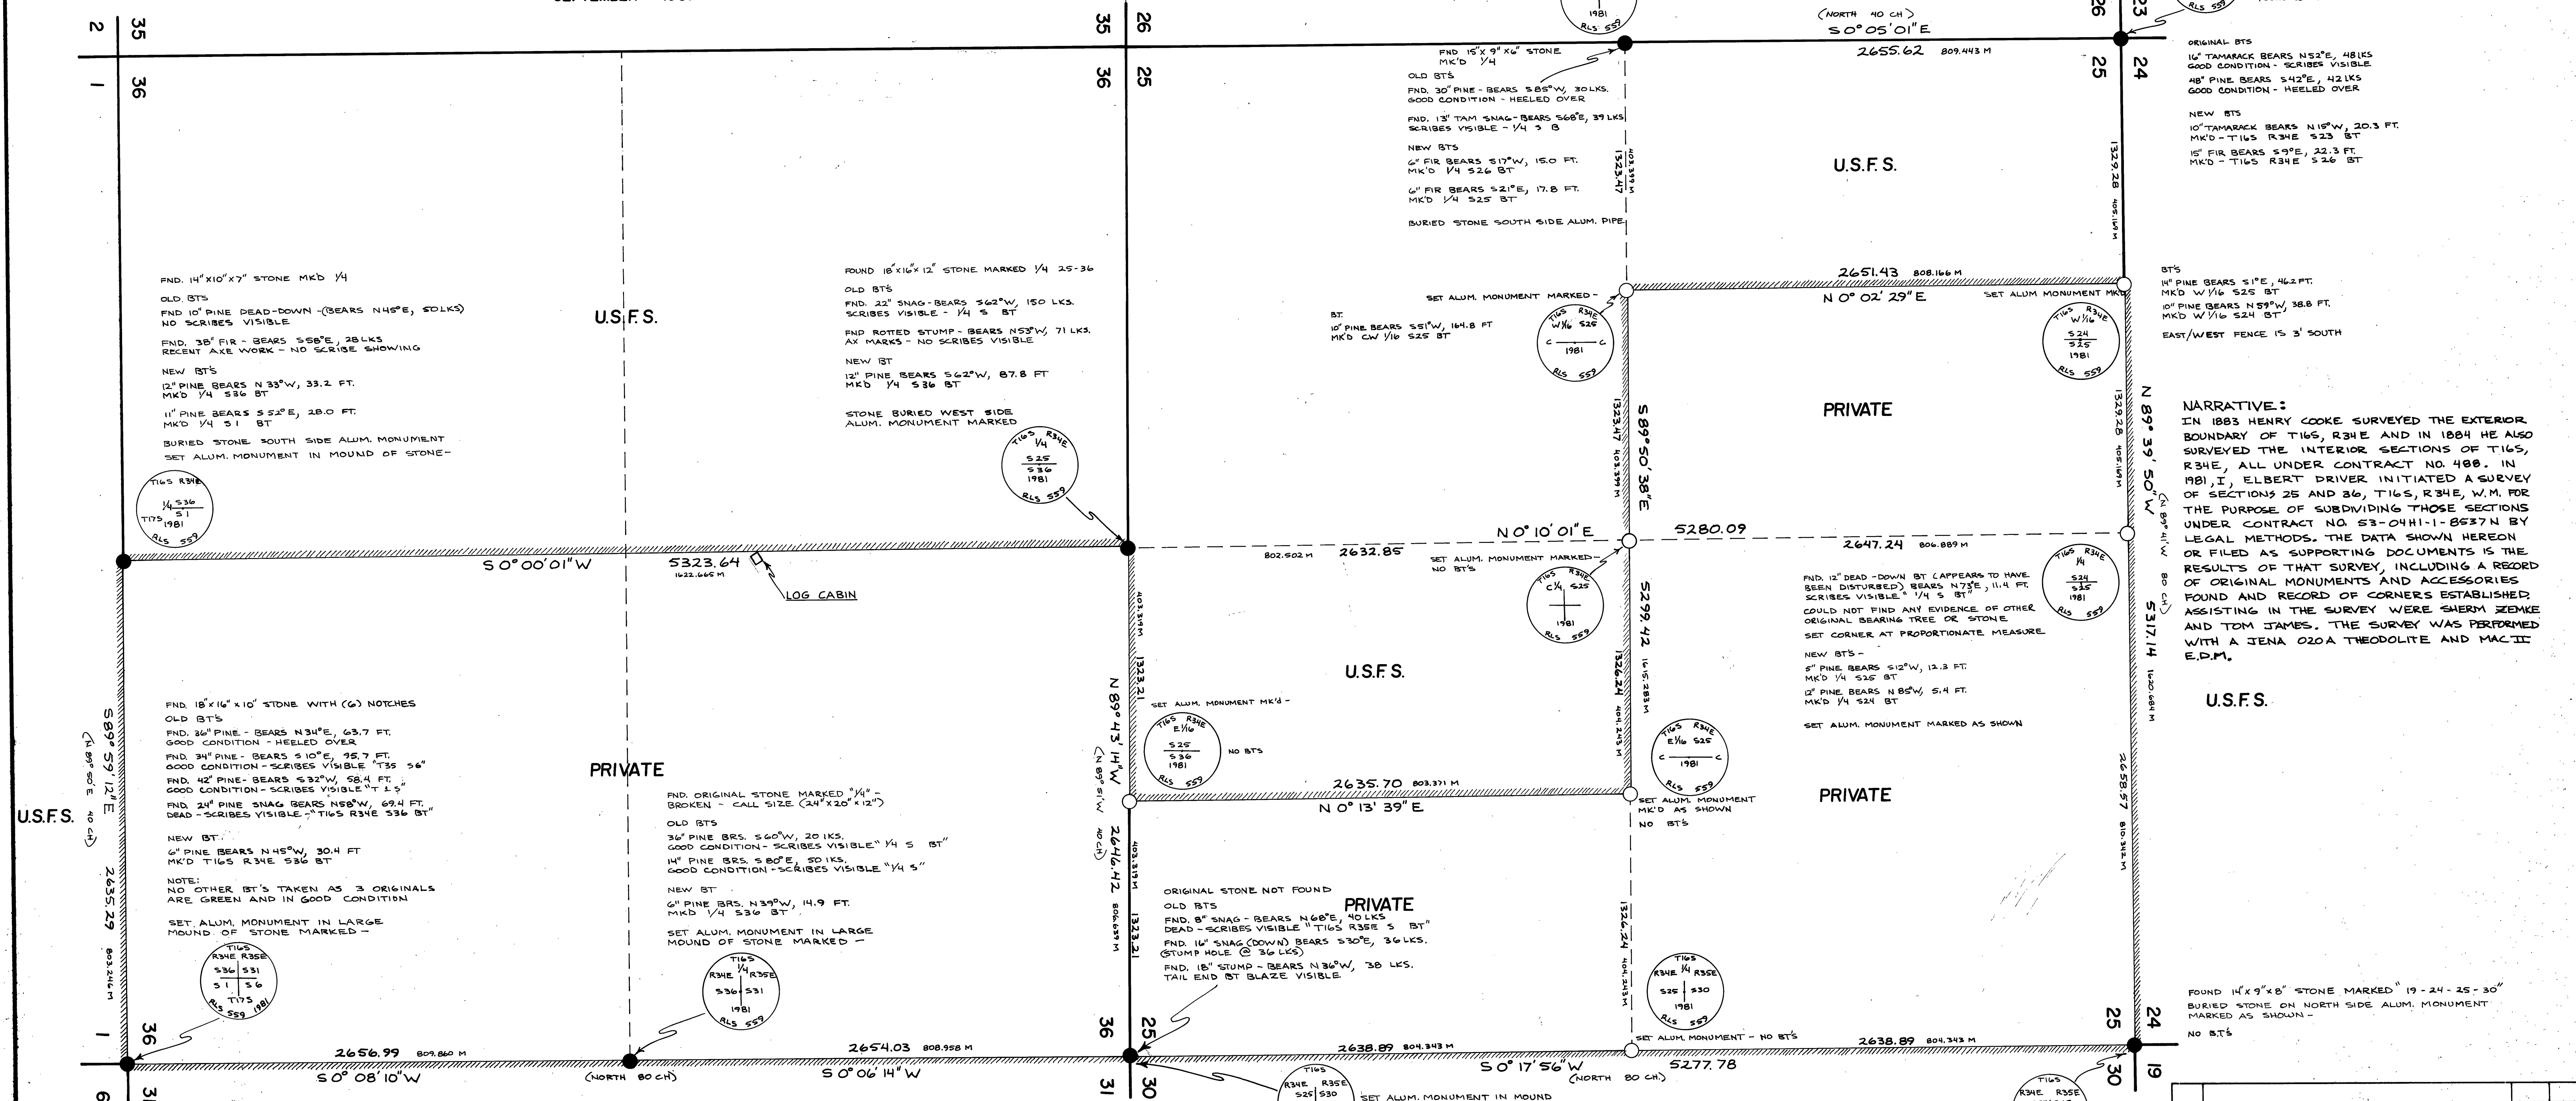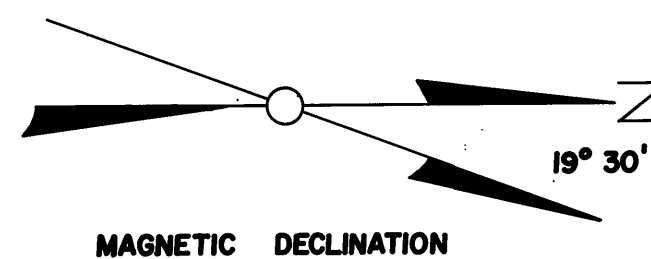

LEGEND

- CORNER MONUMENT FOUND
- CORNER MONUMENT SET - 2" x 30" ALUM. PIPE WITH 2 1/2" CAP
- ===== PROPERTY LINE POSTED WITH 6" STEEL POSTS AND U.S.F.S. PROPERTY BOUNDARY SIGNS 54-2 ATTACHED
- () RECORD GLO DATA
- BASIS OF BEARING - SOLAR OBSERVATION
- B.T. DISTANCES - SIDE AND CENTER
- B.T. BEARINGS - CENTER OF SCRIBED FACE
- B.T.'S MARKED WITH - B.T. TAG, BRASS DISC-LS 559, SIGN 54-4 RED PAINT BAND AND SCRIBED FACE

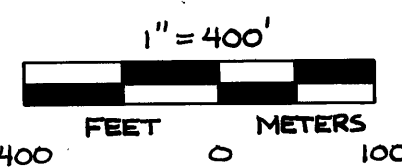

U.S.F.S.

CERTIFICATION:

I, ELBERT DRIVER, REGISTERED PROFESSIONAL LAND SURVEYOR IN THE STATE OF OREGON, HEREBY CERTIFY THAT THIS PLAT AND THE NOTES HEREON OR ATTACHED ARE A CORRECT REPRESENTATION OF A SURVEY I MADE DURING SEPTEMBER, 1981 FOR THE U.S. FOREST SERVICE, IN ACCORDANCE WITH THE STATUTES OF THE STATE OF OREGON AND WITH THE ARTICLES OF OUR CONTRACT.

Elbert Driver
ELBERT DRIVER R.L.S. 559

REGISTERED
PROFESSIONAL
LAND SURVEYOR

OREGON
JANUARY 2, 1962
ELBERT DRIVER
559

ORIGINAL

RECEIVED AND
FILED

OCT 21 1981

OFFICE OF COUNTY SURVEYOR

Robert R. Hargis

Attest: *Coral Hargis*

Grant Co., OR

DESIGNED:	PROJ. NO.	SHT. OF
DRAWN: <i>SSZ</i>	CHN'D:	FILE NO.

MAP OF SURVEY NO. 701