


Map of Survey in Section 7, T.16 S. R.30 E., W.M. Grant County, Oregon

96 Caddastal Survey

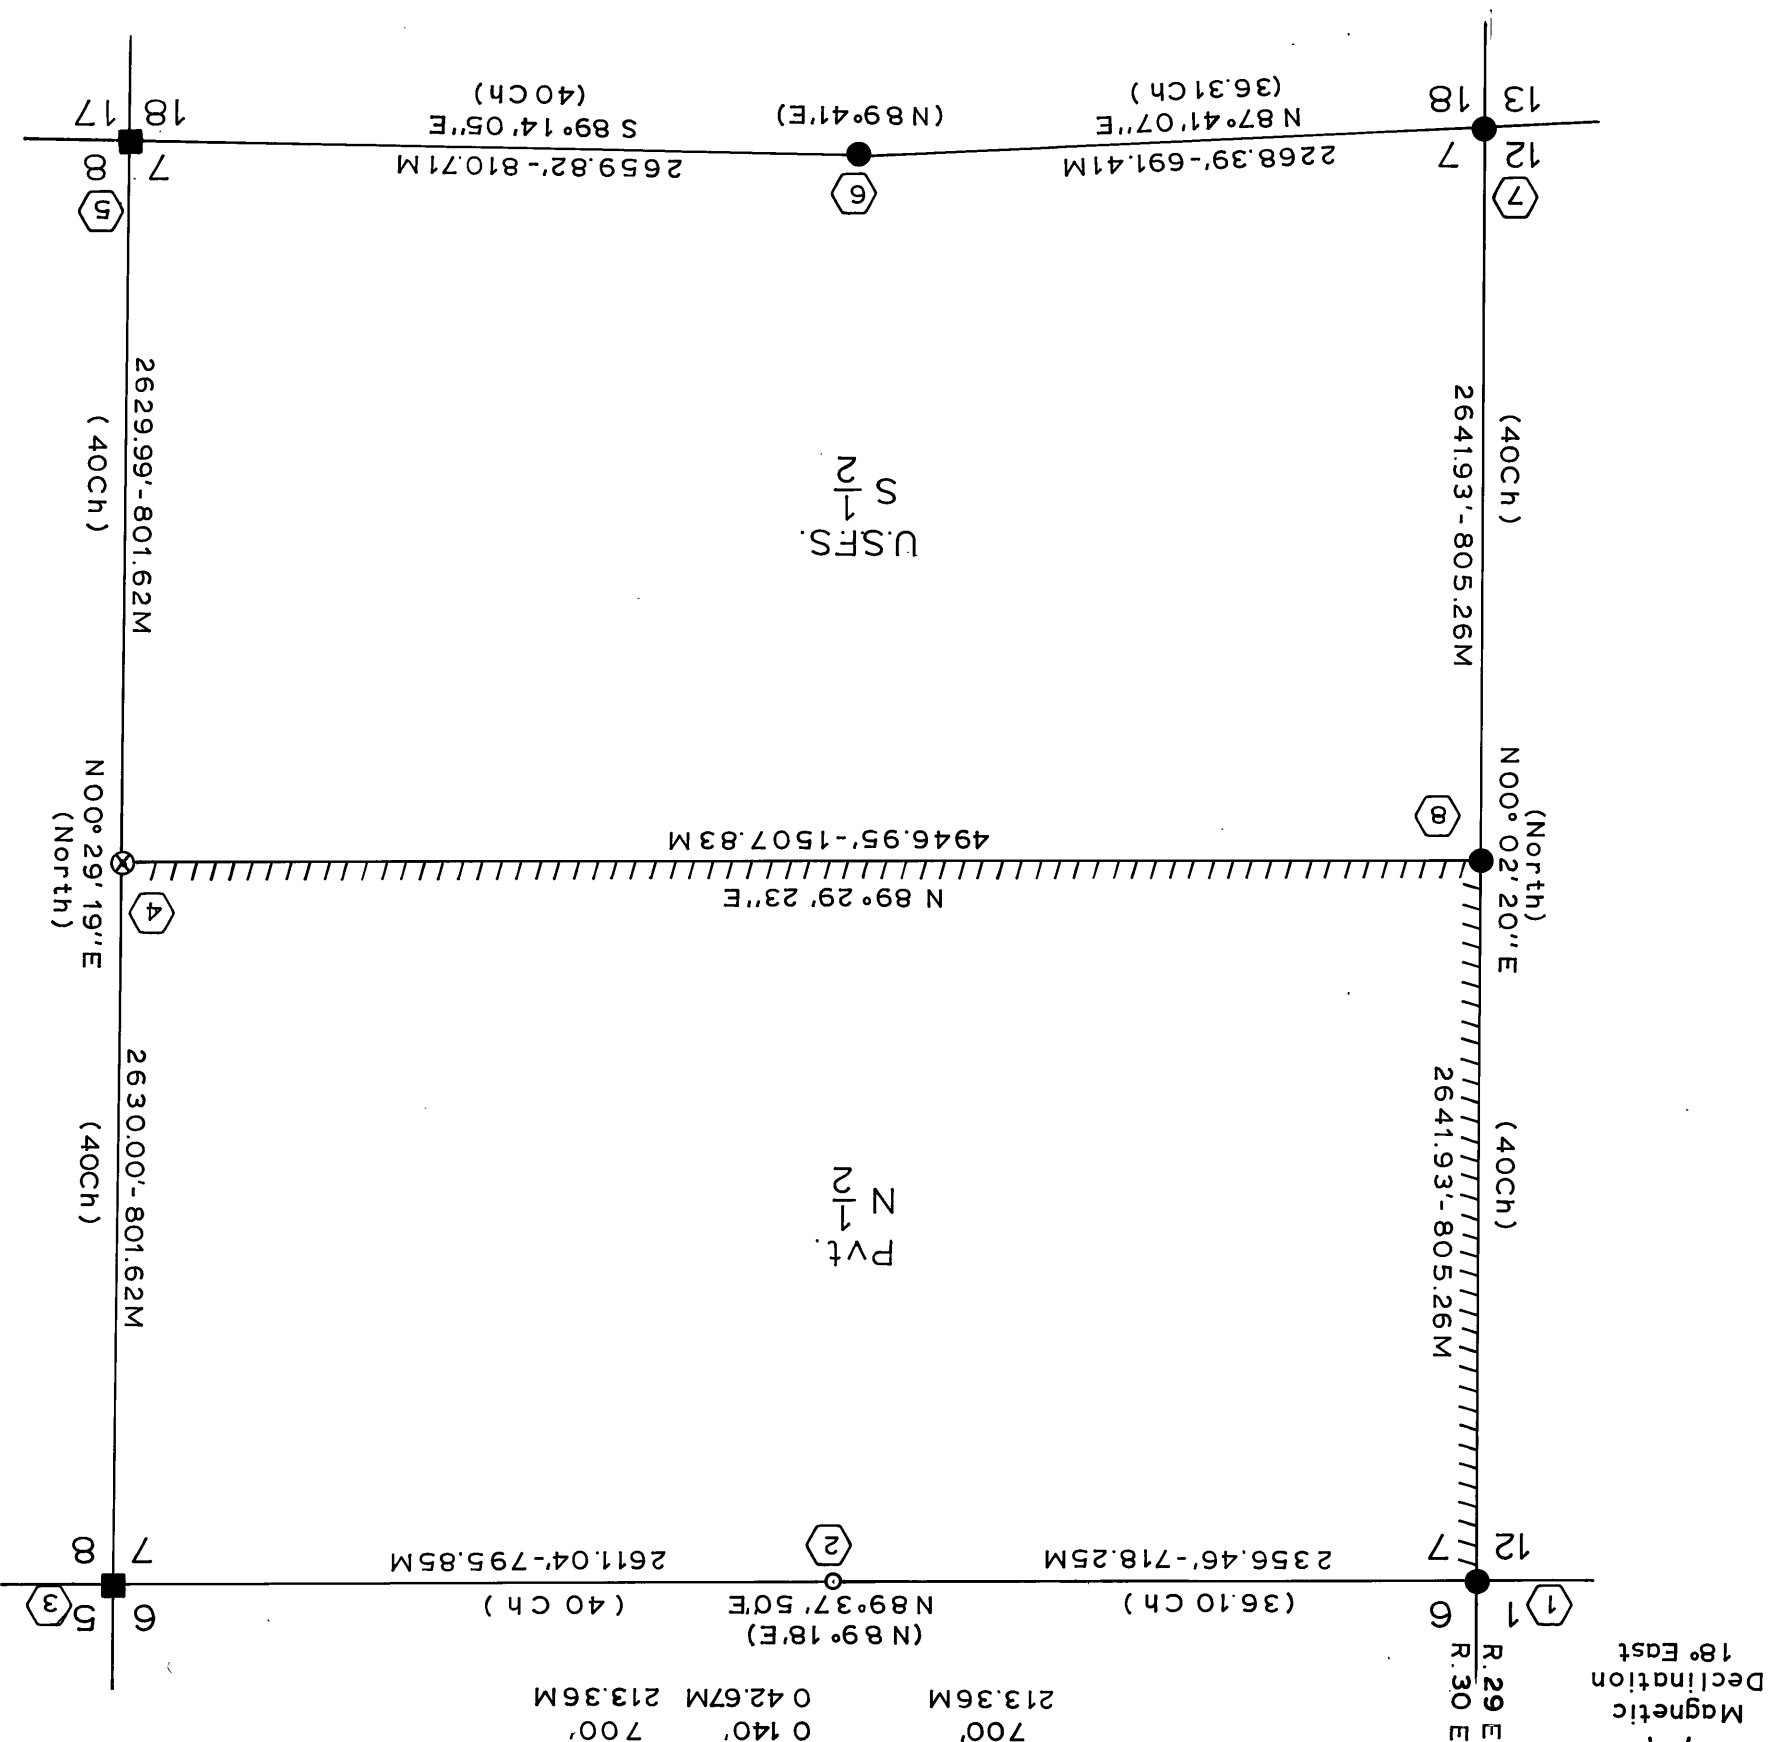

Note
Bearings based on solar observation.
All corners have a steel fence post, with appropriate signs, 3-5 ft. from monument.
All bearing trees and monuments are marked as per BLM Manual of Instructions, 1973, except B.T.'s also have a red band painted breast high and a brass tag, stamped RLS, 1964, in lower blaze and monuments are stamped RLS, 1964.
All original stones found were buried alongside of new monument.

- ① Fd: 12"x12"x5" stone with 5 notches south in m.o.s. Set: AR 24" in ground in m.o.s. Comp. decl. 18° East.
Ret: 7" R.B.T. N 02° W 36.3 ft.
7" D.B.T. N 56° E 39.5 ft.
7" R.B.T. S 76 1/2° W 9.3 ft.
9" D.B.T. S 32° E 29.5 ft.
- ② Fd: No evidence of original corner. Corner position established by single proportionate measurement.
No monument set.
- ③ and ⑤ Fd: No evidence of original corners. Corner position established by double proportionate measurement during survey of section 8. No monument set.
- ④ Fd: AR, RLS, 1964, 1981. Comp. decl. 18° East.
Ret: 9" F.R.B.T. S 63° W 12.6 ft.
6" F.R.B.T. N 84° E 39.7 ft.
- ⑥ Fd: No evidence of original post.
Ret: 23" R.B.T. S 10° E 65 ft. (S 10° E 65 ft.) with scribbling visible "S B."
Set: AR 25" in ground in m.o.s. Comp. decl. 18° East.
Ret: 7" R.B.T. N 79° W 15.9 ft.
9" F.R.B.T. S 29° E 18.5 ft.
- ⑦ Fd: 24"x8"x4" stone with 4 notches south and 2 notches north. Stone broken in 3 places.
Ret: 31" R.B.T. S 05° E 25 ft. (S 05° E 25 ft.) scribbling visible but not readable.
20" R.B.T. S 78° W 33.6 ft. (S 85° W 84 ft.) snag with scribbling visible "S 13 T 16 R 29"
Set: AR 20" in ground in m.o.s. Comp. decl. 18° East.
Ret: 9" F.R.B.T. N 17° W 26.7 ft.
3" Mountain Mahogany B.T. East 39.1 ft.
11" F.R.B.T. S 47° W 37.8 ft.
- ⑧ Fd: No evidence of original corner.
Set: By single proportionate measurement, an AR 24" in ground. Comp. decl. 18° East.
Ret: 11" R.B.T. N 38° W 241.2 ft.
11" Lodgepole Pine B.T. S 71° E 95.6 ft.

FILED
NOV 6 1981
OFFICE OF COUNTY SURVEYOR
GRANT COUNTY, OREGON

Surveyed for: U.S. Forest Service
Contract No. 53-04H1-0-8252N
Surveyed by: Sundet and Associates
P.O. Box 1228
Lakeview, Oregon
Ph. No. 503-947-3293
Date : 1980-1981
Drawing No. 177

REGISTERED
PROFESSIONAL
LAND SURVEYOR
Carl E. Sundet
Oregon License No. 1664
JULY 14, 1978
OREGON
CARL E. SUNDET
1964

"I, Carl E. Sundet, a registered land surveyor in the State of Oregon, hereby certify that this plat and the notes hereon, or attached, are a correct representation of a survey I performed during 1980-81, for the U.S.F.S., in accordance with the statutes of the State of Oregon and with the articles of my contract."
Registered Land Surveyor
Oregon License No. 1664
Carl E. Sundet

History

The west boundary of T.16 S. R.30 E., W.M. was run by Bamford Robb under contract no. 357, dated 1880.
The interiors of T.16 S. R.30 E., W.M. were run by S.W. Lackland under contract no. 357, dated 1880.
No surveys of record have been performed in this section since that time.

- Legend**
- AP - 2 1/2"x30" aluminum pipe with 3 1/4" aluminum cap
 - Monuments found
 - - Corners monumented this survey
 - - No monument set
 - - No monument set
 - () - Record bearing and/or distance
 - m.o.s. - mound of stone
 - Ref - Reference
 - lks - links
 - B.T. - Bearing Tree
 - Fd. - Found
 - Ch. - Chains
 - M - Meters
 - PR - Ponderosa Pine
 - DF - Douglas Fir
 - LLL - Property line posted