
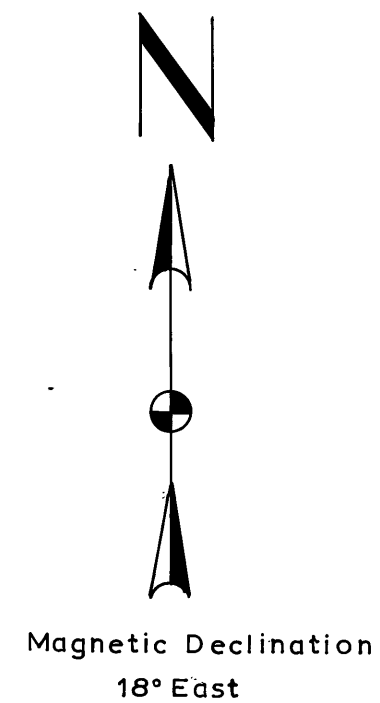


Map of Survey in Section 8, T. 16 S. R. 30 E., W.M. Grant County, Oregon

96 Cadastral Survey

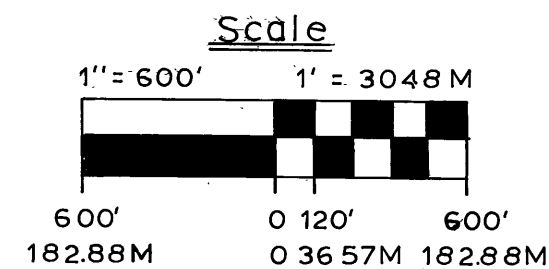

Legend

- AP - 2 1/2" X 30" aluminum pipe with 3 1/4" aluminum cap
- ⊗ - Monuments found
- - Corners monumented this survey
- () - Record bearing and/or distance
- m.o.s. - mound of stone
- Ref. - Reference
- lks - links
- B.T. - Bearing Tree
- Fd. - Found
- Ch - Chains
- M - Meters
- PP - Ponderosa Pine
- Jun - Juniper
- L.P. - Lodgepole Pine
- DF - Douglas Fir
- USFS - U.S. Forest Service
- Pvt. - Private
- - No monument set
- /// - Property line posted

History

The west exterior boundary of T. 16 S. R. 30 E. was executed by Bamford Robb under contract no. 357, dated 1880. The interiors were run by S.W. Lackland also under contract no. 357 dated 1880.

Subsequently, some corners have been remonumented and perpetuated by R.L.S. 1664 in 1981.

No surveys of record have been performed within this section since that time.

"I, Carl E. Sundet, a registered land surveyor in the State of Oregon, hereby certify that this plat and the notes hereon, or attached, are a correct representation of a survey I performed during 1980-1981, for the U.S. Forest Service, in accordance with the statutes of the State of Oregon and with the articles of my contract."

Carl E. Sundet

Carl E. Sundet
Registered Land Surveyor
Oregon License No. 1664

REGISTERED
PROFESSIONAL
LAND SURVEYOR

Carl E. Sundet
OREGON
JULY 14, 1978
CARL E. SUNDET
1664

Surveyed for: U.S. Forest Service
Contract No. 53-04H1-0-8252N

Surveyed by: Sundet and Associates
P.O. Box 1228
Lakeview, Oregon
Ph. No. 503-947-3293

Date: 1980-1981

Drawing No. 174

Sheet 1 of 2