


96 Cadastral Survey

Scale

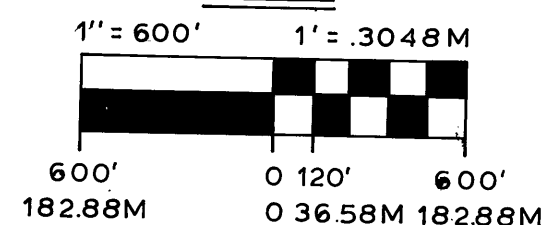

- Legend

AP - 2 1/2" X 30" aluminum pipe with 3 1/4" aluminum cap

⊗ - Monuments found

- - Corners monumented this survey

() - Record bearing and/or distance

m.o.s. - mound of stone

Ref. - Reference

lks - links

B.T. - Bearing Tree

Fd. - Found

Ch - Chains

M - Meters

P.P. - Pondero

Jun - Juniper

L.P. - Lodigano

D.F. - Douglas Fir

U.S.F.S. - U.S. Forest Service

Pvt. - Private

■ - No monument set

//// - Property line pos

Property line posted

History

The interiors of T. 16 S. R. 30 E. were run by S.W. Lackland under contract no. 357, dated 1880.

Subsequently, some corners have been remonumented and perpetuated by R.L.S. 1805 in 1979 and by R.L.S. 1664 in 1980-1981.

No surveys of record have been performed within this section since that time.

"I, Carl E. Sundet, a registered land surveyor in the State of Oregon, hereby certify that this plat and the notes hereon, or attached, are a correct representation of a survey I performed during 1980-1981, for the U.S. Forest Service, in accordance with the statutes of the State of Oregon and with the articles of my contract."

Carl E. Sundet

— Carl E. Sundet
Registered Land Surveyor
Oregon License No. 1664

REGISTERED
PROFESSIONAL
LAND SURVEYOR

Carl E. Sundet
OREGON
JULY 14, 1978
CARL E. SUNDET
1664

Surveyed for: U.S. Forest Service
Contract No. 53-04H1-0-8252N

Surveyed by: Sundet and Associates
P.O.Box 1228
Lakeview, Oregon
Ph.No. 503-947-3293

Date : 1980-1981

Drawing No. 160

Sheet 1 of 2