
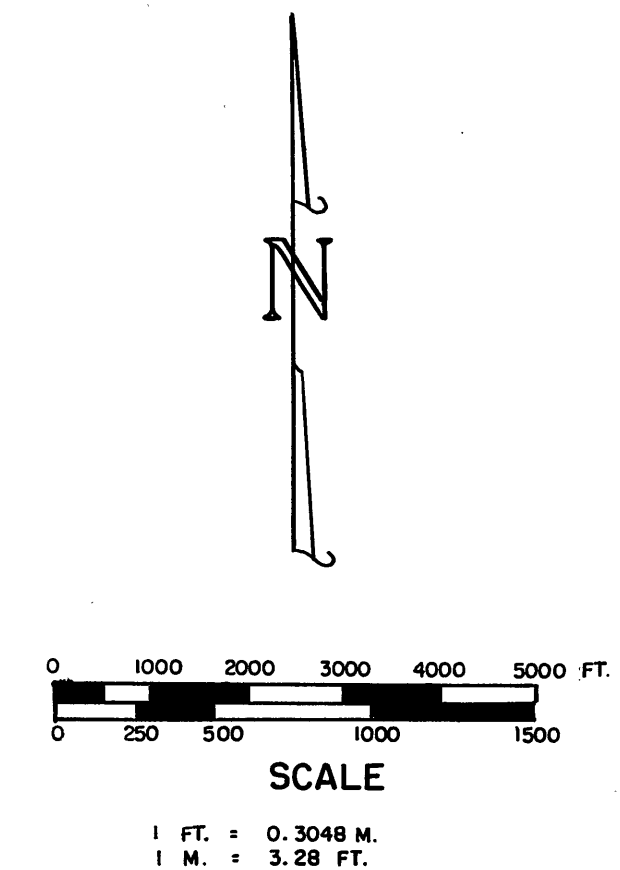


TOWNSHIP 16 & 17 SOUTH, RANGE 28 & 29 EAST, W.M.
GRANT COUNTY, OREGON

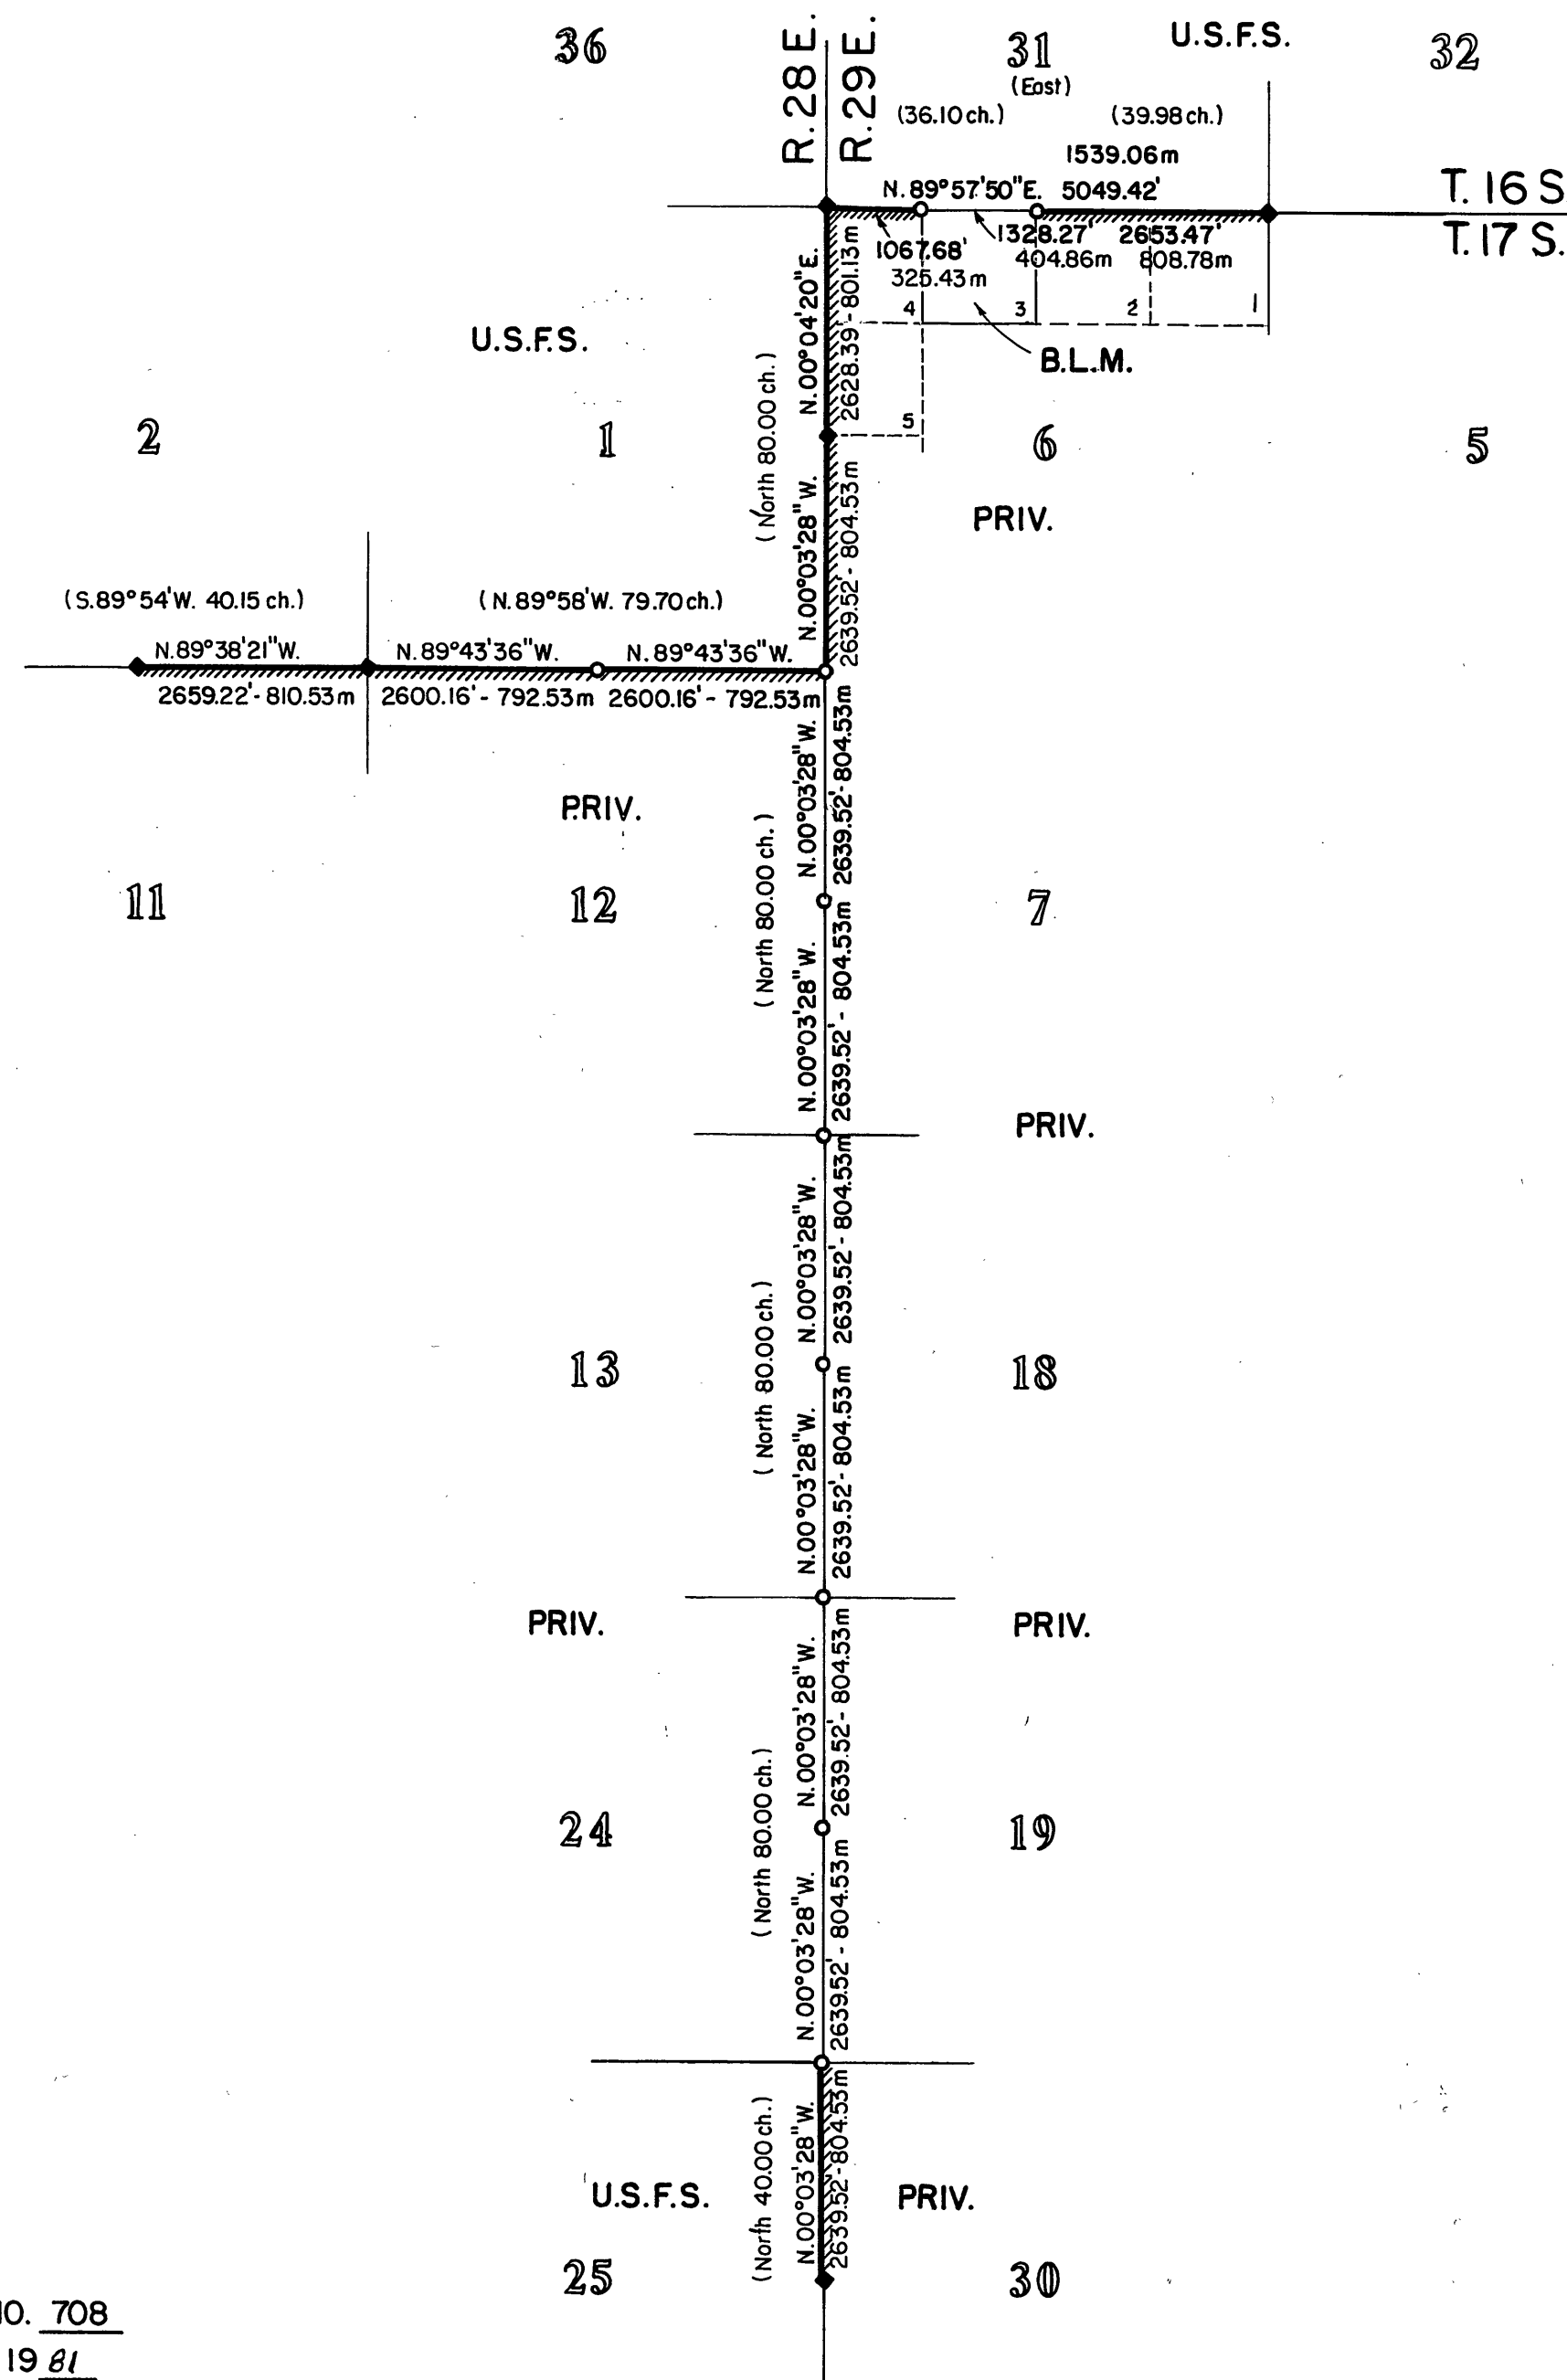

LEGEND

- ◆ ORIGINAL G.L.O. CORNER FOUND AND MONUMENTED.
- MONUMENT SET.
- () DISTANCE AND/OR BEARING OF RECORD.
- ===== PROPERTY LINE POSTED.
- m METERS
- ch. CHAINS
- U.S.F.S. DENOTES LANDS ADMINISTERED BY THE U.S. DEPT. OF AGRICULTURE, FOREST SERVICE.

NOTES

1. Bearings based on solar observations.
2. Original G.L.O. Surveys:
 - T. 16S., R. 28E., Extentors
 - T. 17S., R. 28E., " Robb & Eckelsdn, Cont. No. 366, dated Aug. 18, 1880.
 - T. 17S., R. 29E., " - Retracement - Samuel W. Lackland, Cont. No. 384, dated Mar. 29, 1881.
 - T. 16S., R. 28E., " - Retracement - Samuel W. Lackland, Cont. No. 384, dated Mar. 29, 1881.
 - T. 17S., R. 28E., Subdivisions - Henry W. Cooke, Cont. No. 427, dated Dec. 15, 1881.
3. For complete description corners see attached "Certified Record of Land Corner Monumentation" sheets, and Narrative filed with this plat.

CERTIFICATION

"I, CHARLES F. PALMER, a registered land surveyor in the State of Oregon, hereby certify that this plat and the notes hereon, or attached, are a correct representation of a survey I performed during Sept./Oct. 1981, for the U.S. Forest Service, in accordance with the statutes of the State of Oregon and the articles of my contract (No. 53-04H1-1-8439 N).

Charles F. Palmer 12/15/81
CHARLES F. PALMER, P.L.S.
Oregon License No. 1287

GRANT COUNTY SURVEY NO. 708

FILED Dec 18, 19 81

BY: Robert D. Baggett

Attest: Carole Wright, Co. clk.

	U.S.D.A. Forest Service		Malheur National Forest	
	SURVEY PLAT			
	Boundary Survey - Three Piece Cadastral - BUNTON Section			
	Scale: 1" = 2000'	Date: NOVEMBER 1981	Job: 603	
Dsn: -	Drn: C.F.P.	Sht. No. 2		
Ckd: C.F.P.	M.A. Palmer & Sons ENGINEERING & SURVEYING 254 N. Alder - Box 61 Burns, Oregon 97720		of 2	