


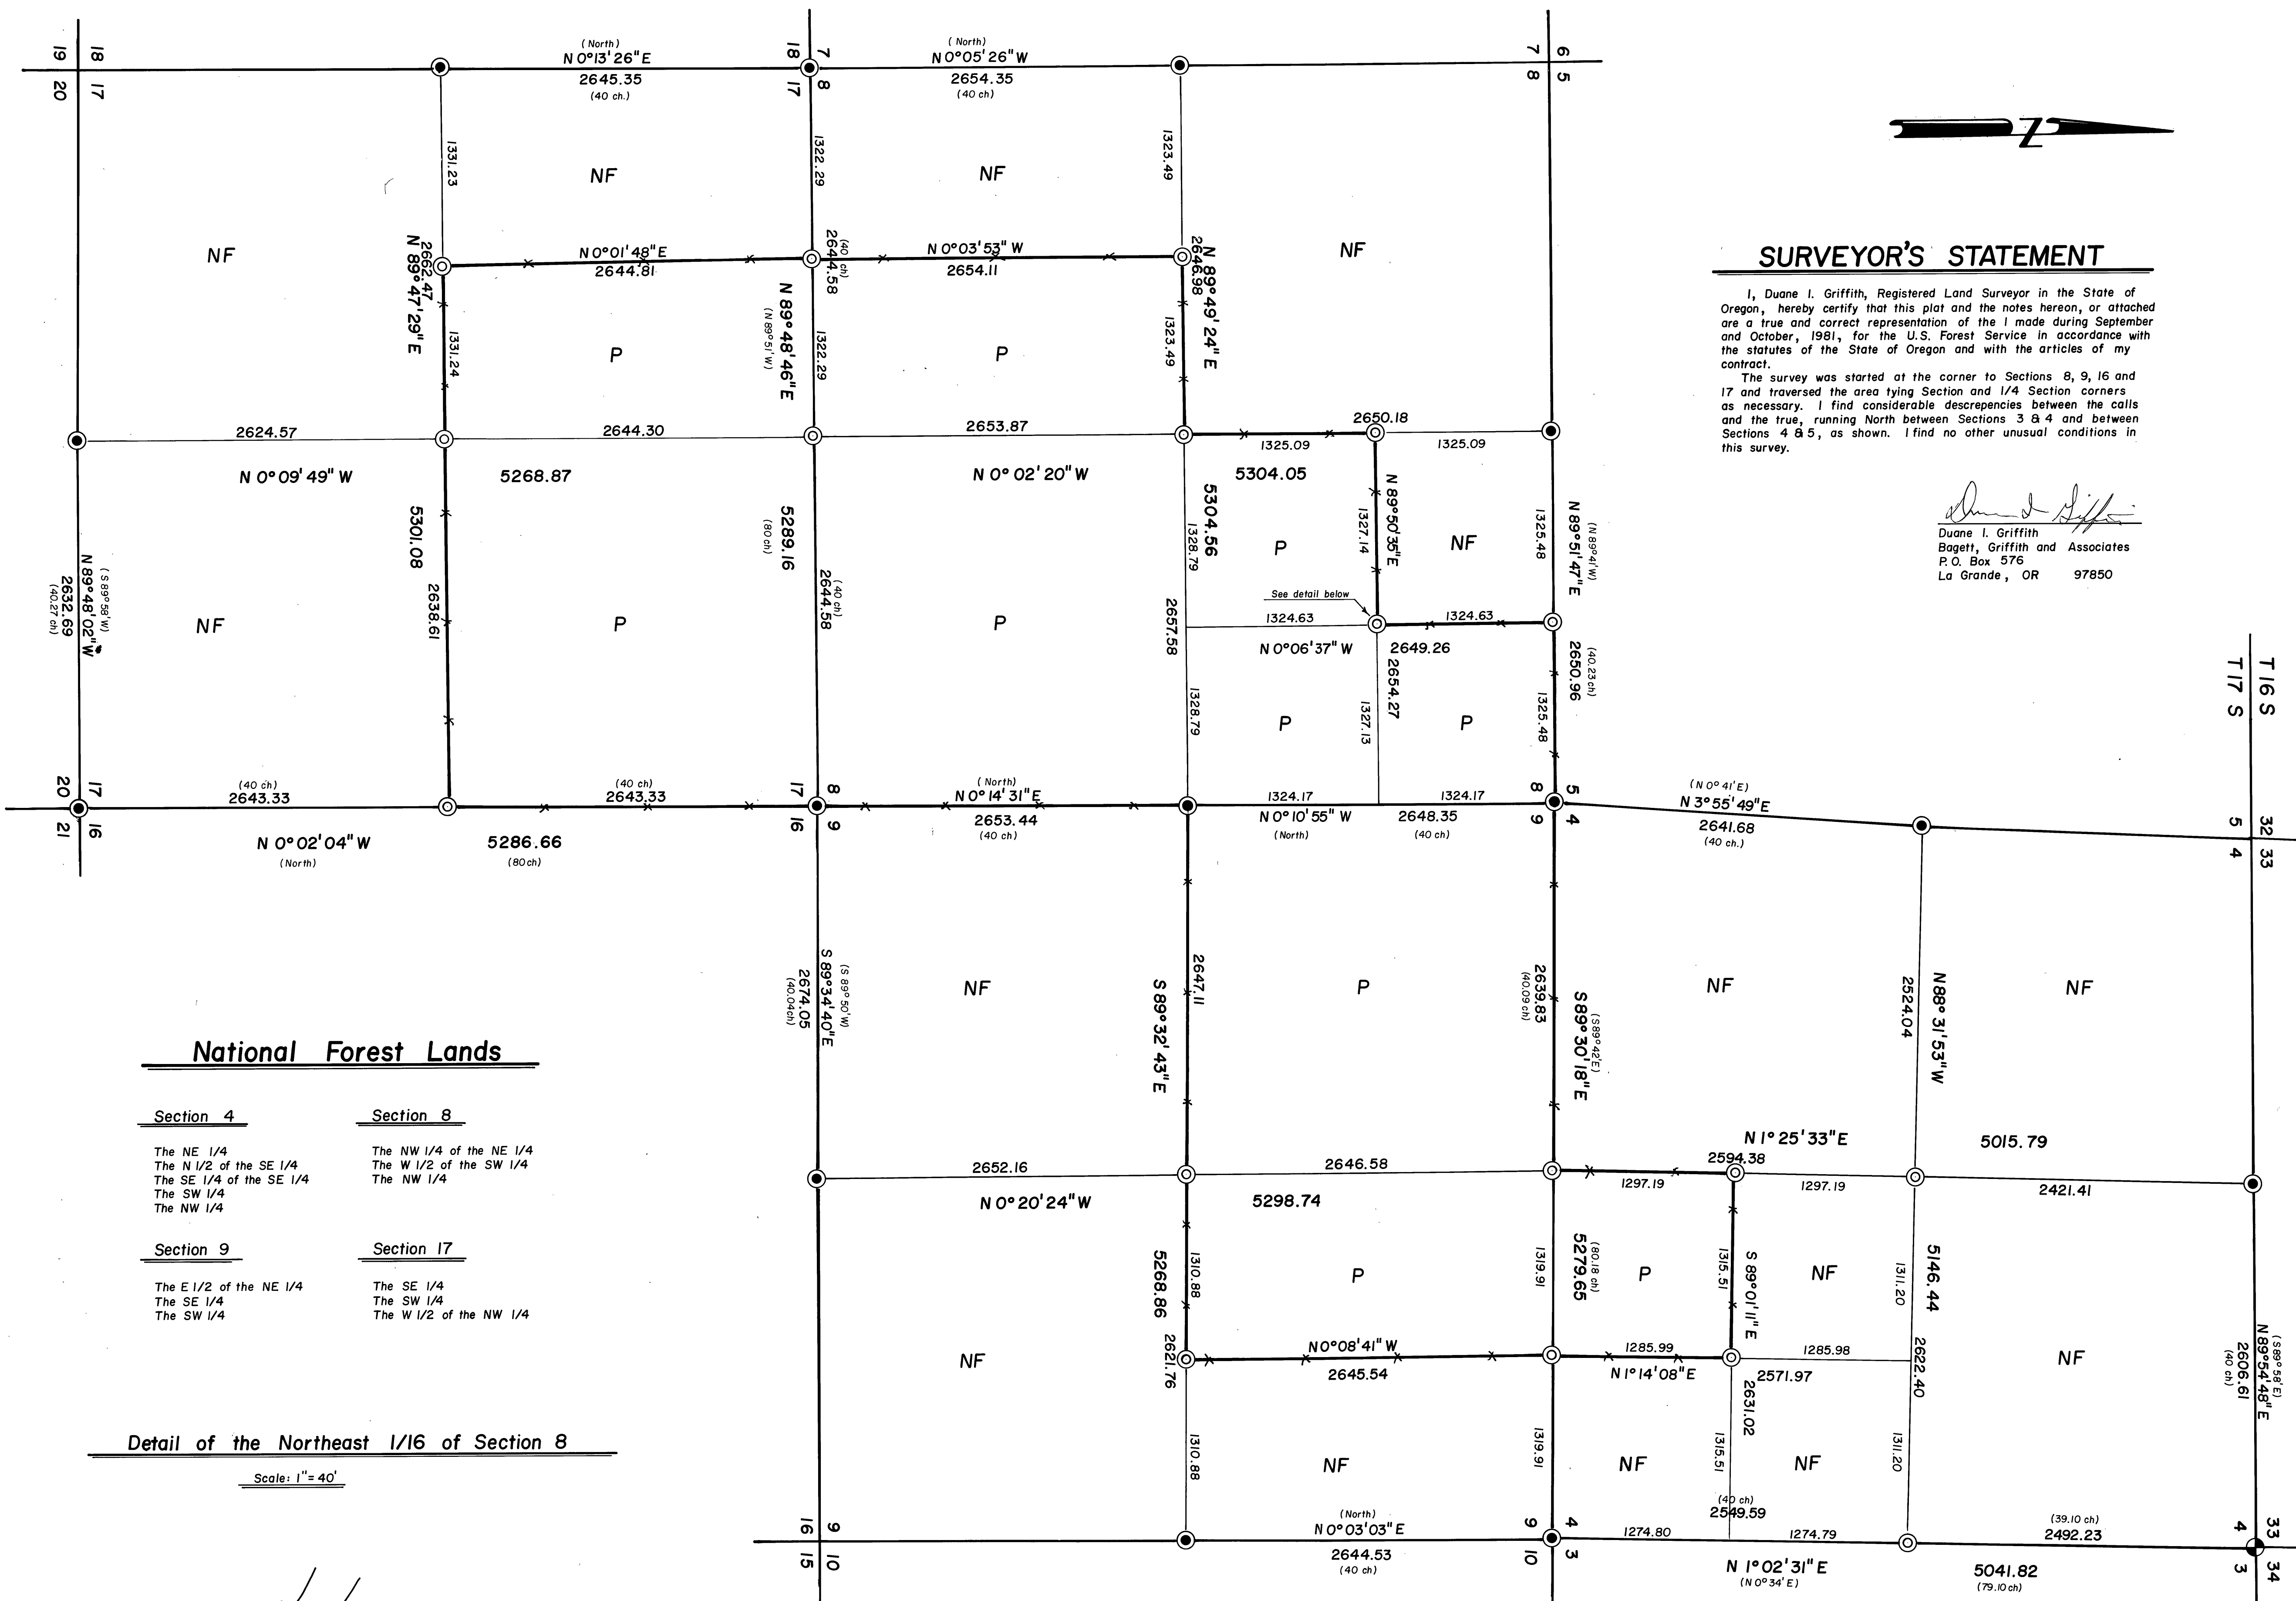

SURVEYOR'S STATEMENT

I, Duane I. Griffith, Registered Land Surveyor in the State of Oregon, hereby certify that this plat and the notes hereon, or attached are a true and correct representation of the land made during September and October, 1981, for the U.S. Forest Service in accordance with the statutes of the State of Oregon and with the articles of my contract.

The survey was started at the corner to Sections 8, 9, 16 and 17 and traversed the area tying Section and 1/4 Section corners as necessary. I find considerable discrepancies between the calls and the true, running North between Sections 3 & 4 and between Sections 4 & 5, as shown. I find no other unusual conditions in this survey.

Duane I. Griffith
Duane I. Griffith
Baggett, Griffith and Associates
P.O. Box 576
La Grande, OR 97850

BASIS OF BEARING

A.M. and P.M. Solar observations taken at a point 400 feet South of the Northeast corner of Section 17.

	A.M.	P.M.
Date	9/10/81	9/10/81
Mean vert. angle	12° 47' 52"	8° 20' 18"
Mean declination	4° 49' 31"	4° 39' 26"
Mean horiz. angle	184° 38' 32"	357° 17' 33"

Latitude 44° 06' 17"
Magnetic declination 21° East


LEGEND

- Found aluminum monument set by Forest Service
- Found original G.L.O. corner evidence, set 2 1/2" x 30" aluminum pipe with aluminum cap
- Set 2 1/2" x 30" aluminum pipe with aluminum cap at proportionate distance
- National Forest Boundary, posted
- () Record bearing and distance from G.L.O. field notes
- NF National Forest lands
- P Privately owned lands

NOTE:

For monumentation information, see monumentation sheets filed separately

Scale: 1" = 600'

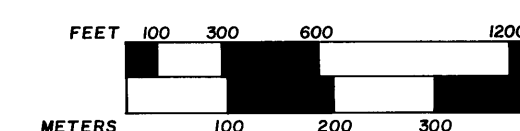

1 Meter = 3.2808333 Feet

National Forest Lands

Section 4

The NE 1/4
The N 1/2 of the SE 1/4
The SE 1/4 of the SE 1/4
The SW 1/4
The NW 1/4

Section 8

The NW 1/4 of the NE 1/4
The W 1/2 of the SW 1/4
The NW 1/4

Section 9


The E 1/2 of the NE 1/4
The SE 1/4
The SW 1/4

Section 17

The SE 1/4
The SW 1/4
The W 1/2 of the NW 1/4

Detail of the Northeast 1/16 of Section 8

Scale: 1" = 40'

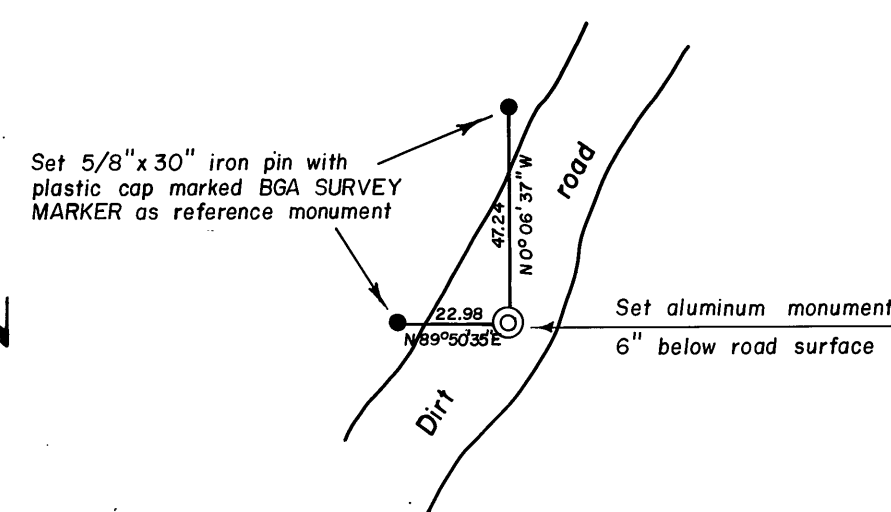

REGISTERED
PROFESSIONAL
LAND SURVEYOR

Duane I. Griffith
DUANE I. GRIFFITH
644

BAGETT - GRIFFITH & ASSOCIATES
La Grande, Oregon

Map of Survey
Survey in Sections 4, 8, 9 and 17
Township 17 South, Range 32
East of the Willamette Meridian
GRANT COUNTY, OREGON

SURVEYED FOR	Malheur National Forest
SURVEYED BY	d.i.g. - g.t.b. - r.g.r.
Scale: 1" = 600'	Drawn by: d.i.g. - r.g.r.

RECEIVED AND
FILED
DEC 24 1981

CLERK OF COUNTY SURVEYOR
Robert W. Baggett