


TOWNSHIP 12 SOUTH, RANGE 33 EAST, OF THE WILLAMETTE MERIDIAN, OREGON.

DEPENDENT RESURVEY

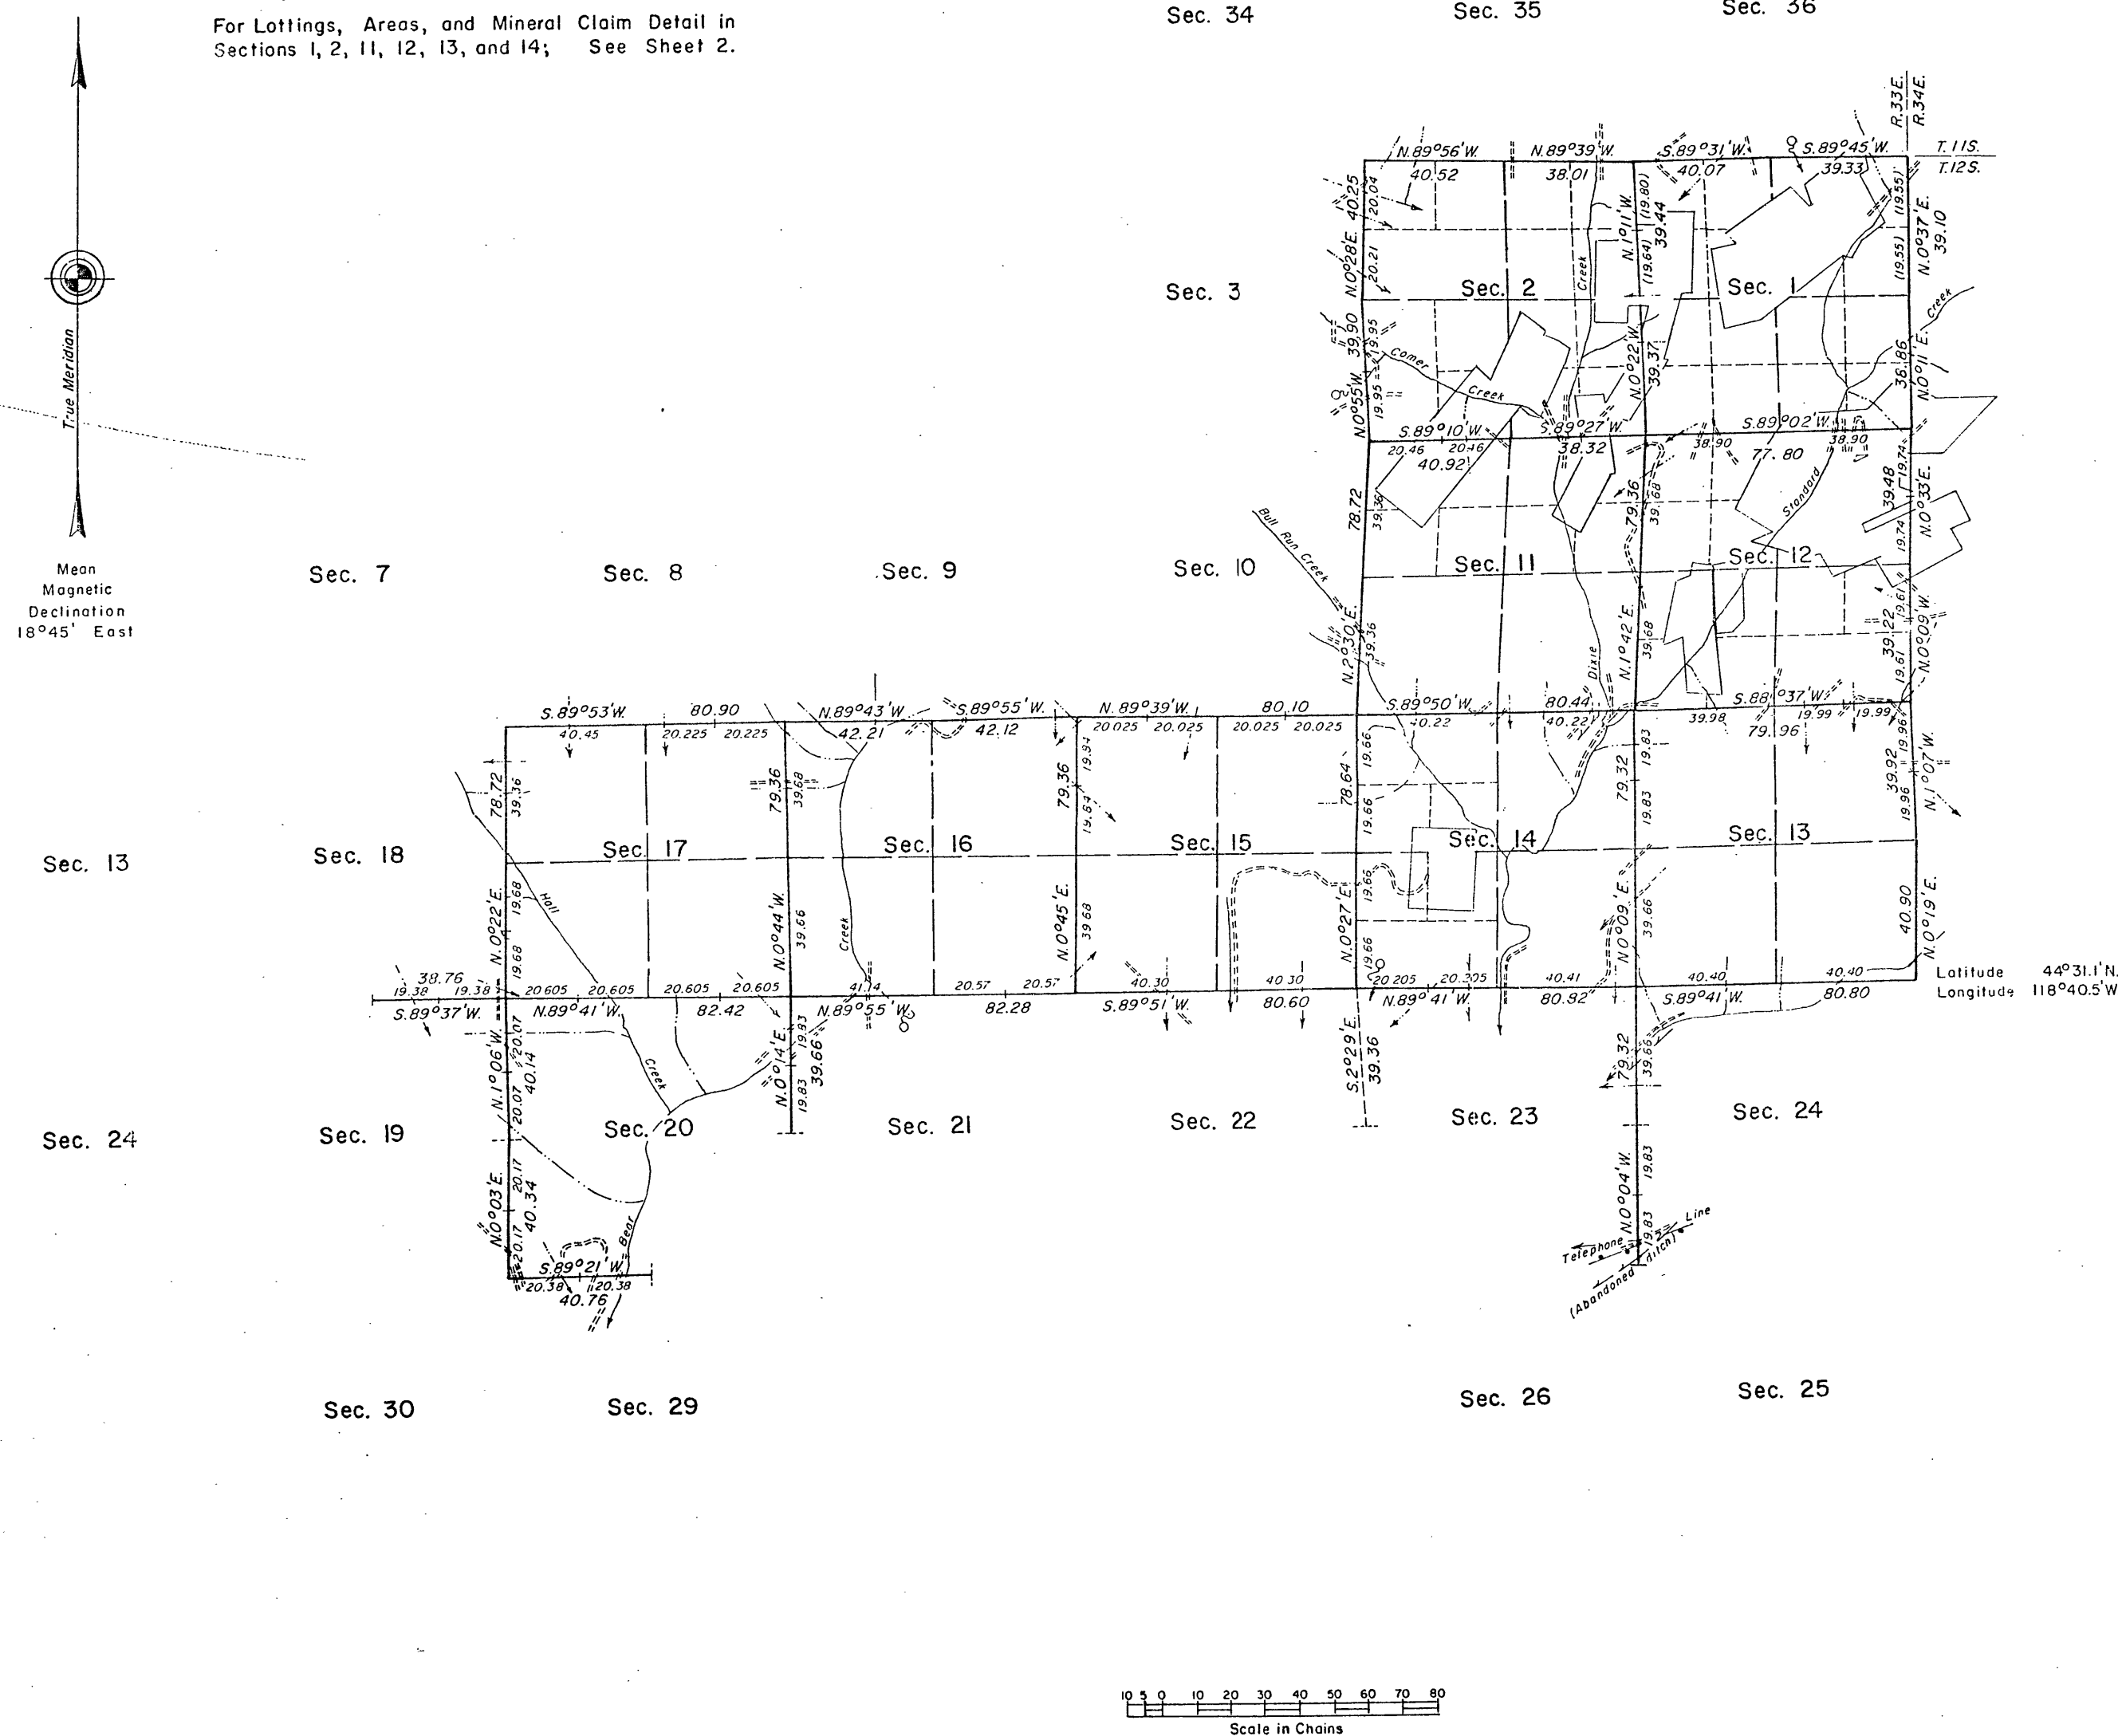

A history of surveys is contained in the field notes.

This plat represents a dependent resurvey of a portion of the north and east boundaries, and a portion of the subdivisional lines, with ties to certain mining claim corners, T. 12 S., R. 33 E., Willamette Meridian, Oregon, designed to restore the corners in their true original location according to the best available evidence.

Except as shown hereon, the lottings and areas are as shown on the plats approved November 17, 1869, November 7, 1881, and January 25, 1904.

The resurvey was executed by Lynn M. Roseberry, Cadastral Surveyor, from August 22, 1966, to May 31, 1968, under Special Instructions dated May 7, 1965, which provide for the surveys included under Group Number 574.

Timber in this area consists of juniper, pine, fir, larch, spruce, cottonwood, and willow.

UNITED STATES DEPARTMENT OF THE INTERIOR
BUREAU OF LAND MANAGEMENT
Portland, Oregon June 7, 1982

This plat is strictly conformable to the approved field notes, and the survey, having been correctly executed in accordance with the requirements of law and the regulations of this Bureau, is hereby accepted.

For the Director

William W. Glenn

Chief Cadastral Surveyor of Oregon

RECEIVED AND
FILED

JUL 8 1982

OFFICE OF COUNTY SURVEYOR

Attest: *James E. Lawrence*

MAP OF SURVEY NO. 721