
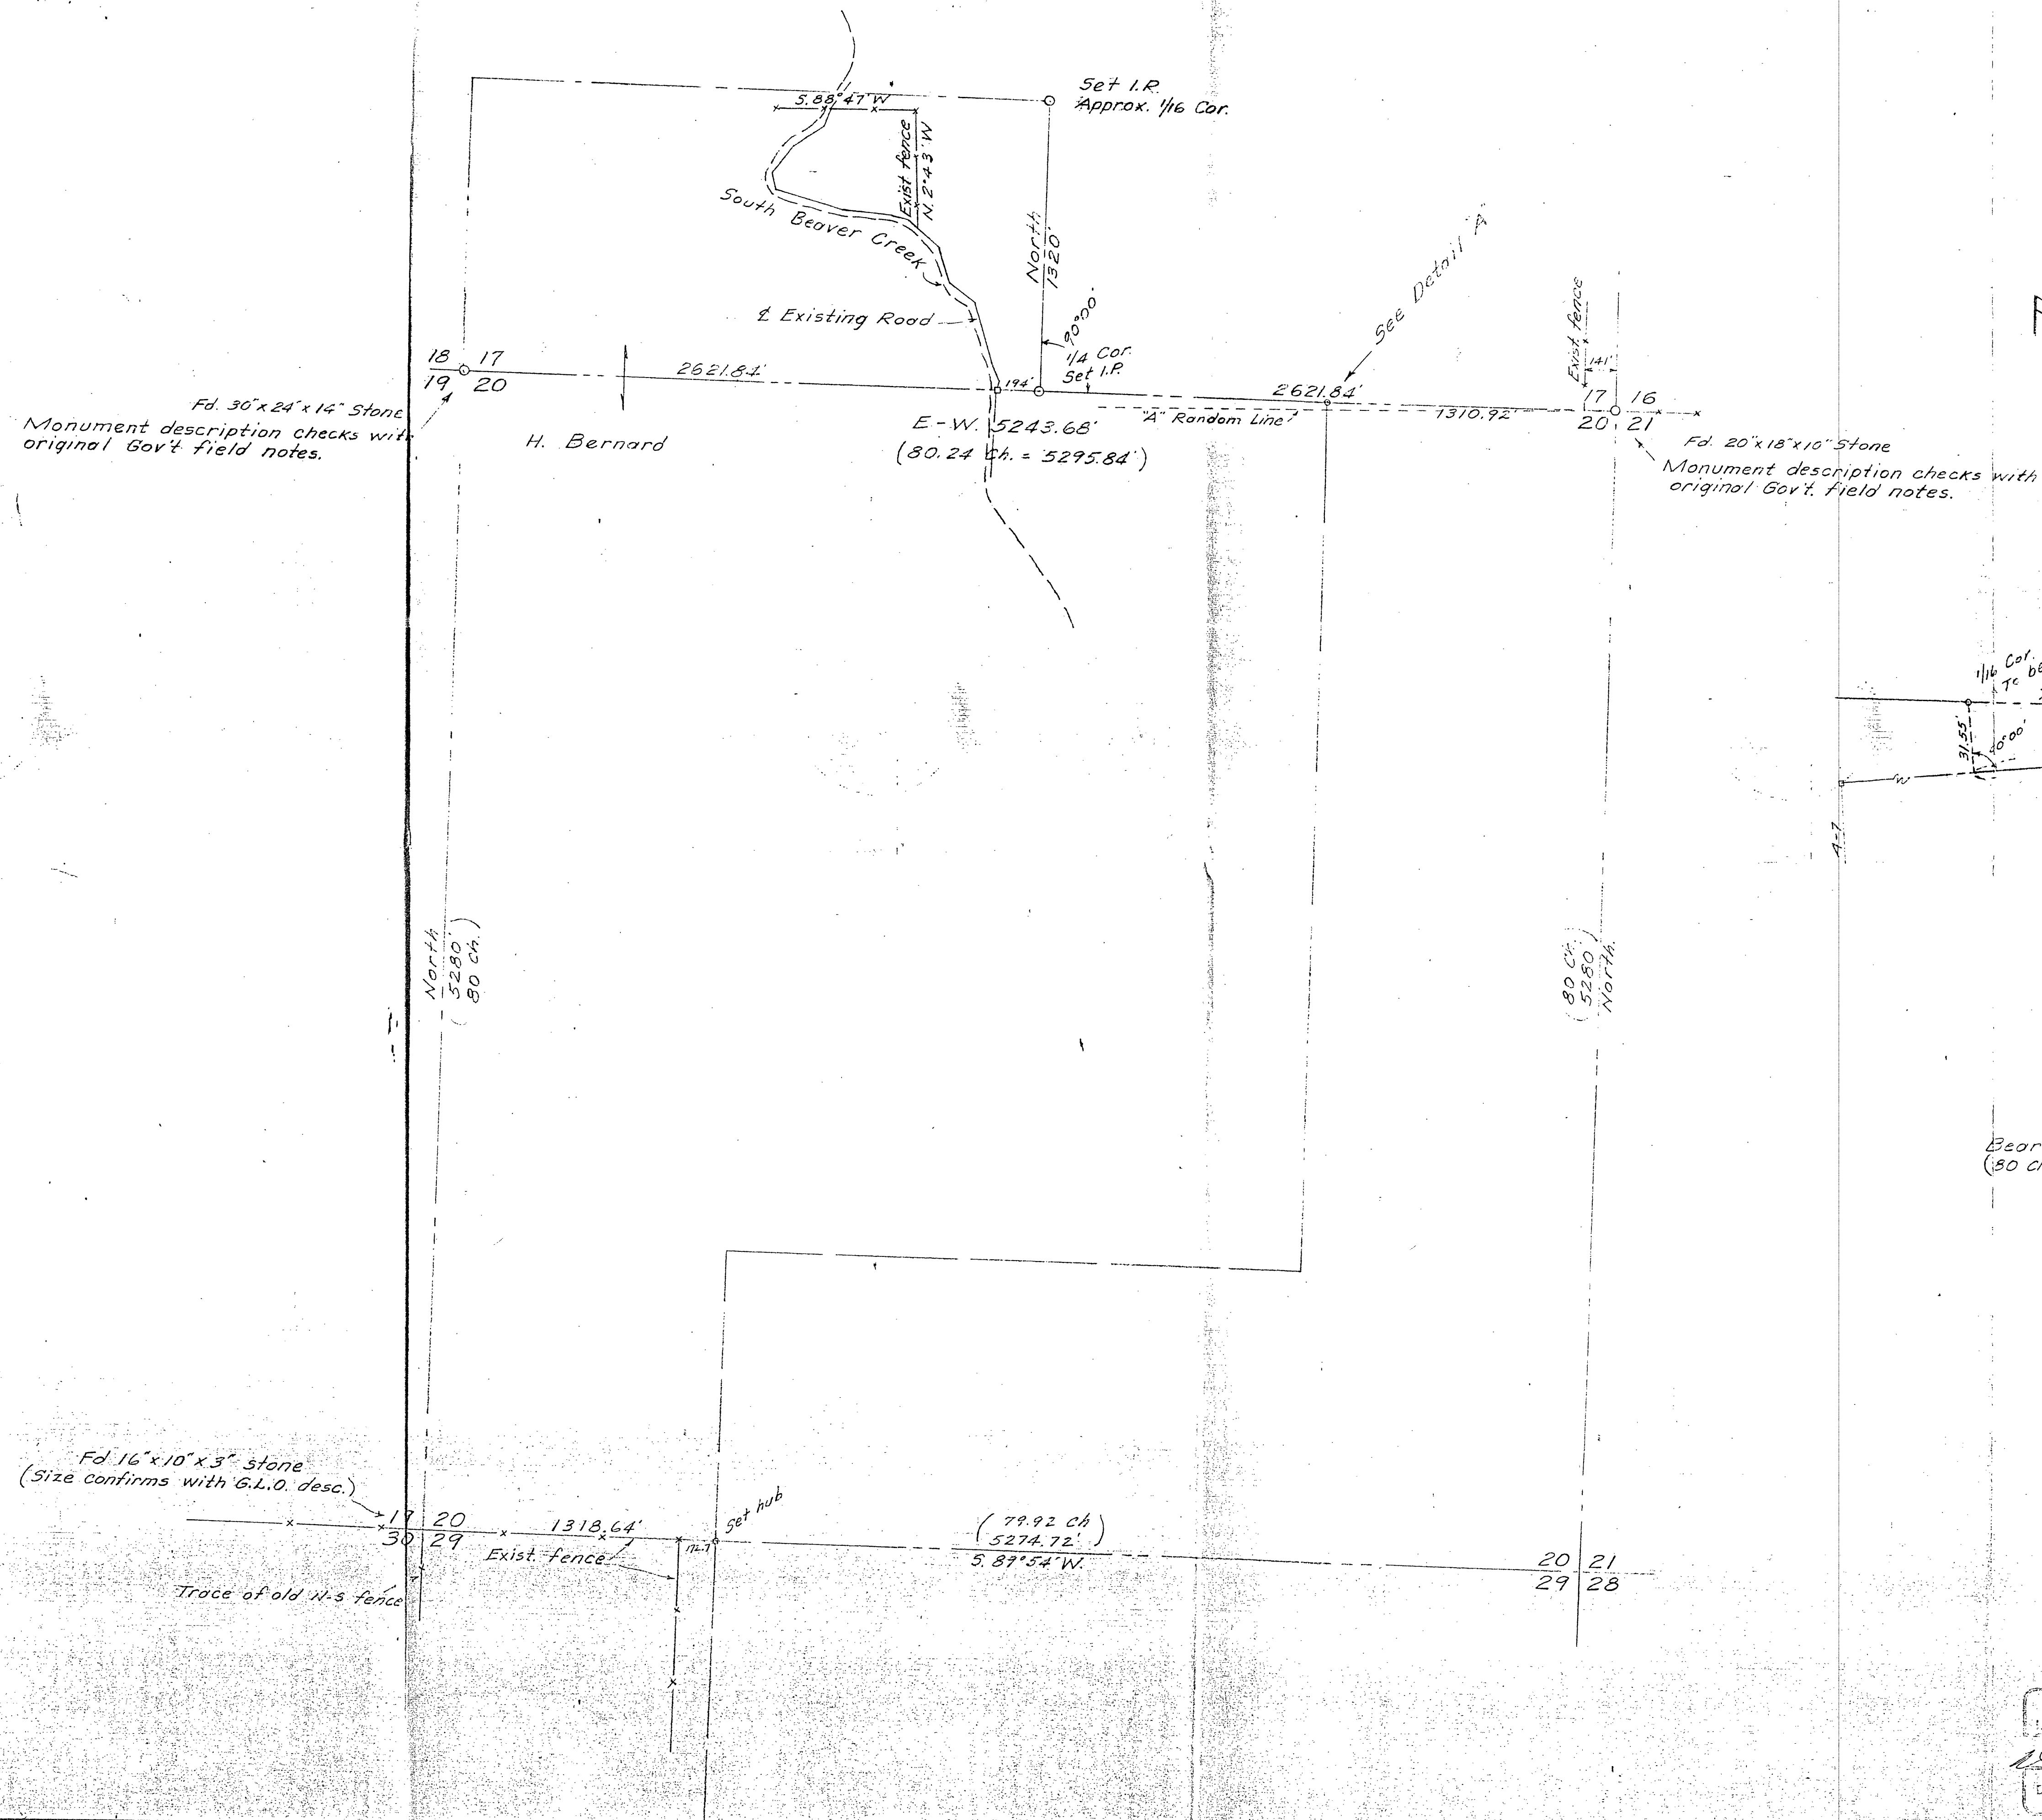


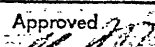

Notes

Bearings taken from original Gov't field notes.
(50 ch.: 5230) denotes original Gov't. field measure.

RECEIVED AND
FILED
JAN 18 1965
JOHN LIVEIRA, County Clerk
Deputy,

Date	No.	Revisions	By	App.
<i>Survey</i> <i>For Henry Bernard</i> <i>In Sections 17 & 20, T.17 S., R.26 E., W.1 N.</i> <i>Grant County, Oregon.</i>				
Design	TENNESON ENGINEERING CORP. <i>Consulting Engineers</i> 412 West Second Place The Dalles Oregon			Scale <i>1" = 400'</i>
Survey <i>R.C.</i>				Date <i>12-10-64</i>
Drawn <i>V.F.</i>	Checked 	Approved 	Work Order No. <i>3311</i>	Sheet <i>1 of 1</i>