
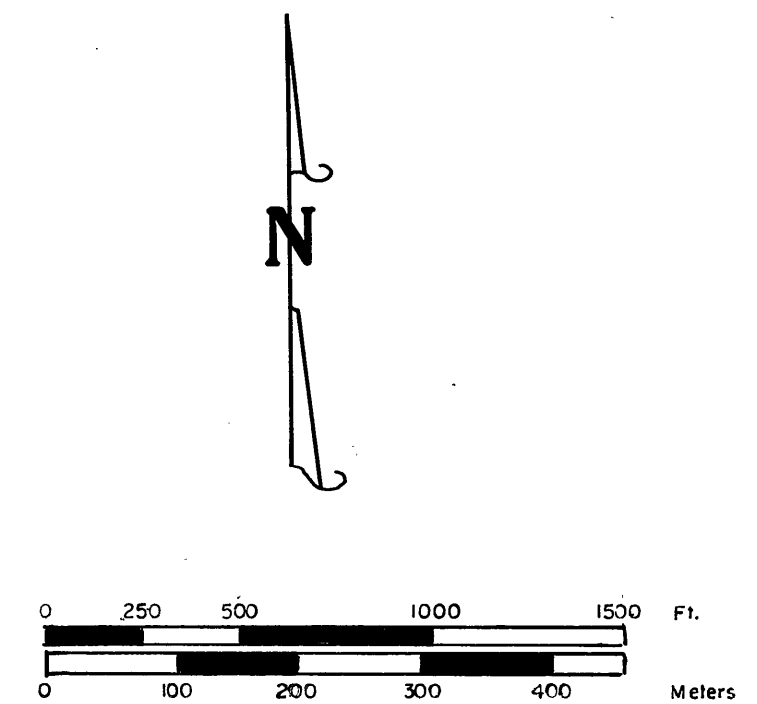


TOWNSHIP 17 SOUTH, RANGE 32 EAST, W.M.
GRANT COUNTY, OREGON

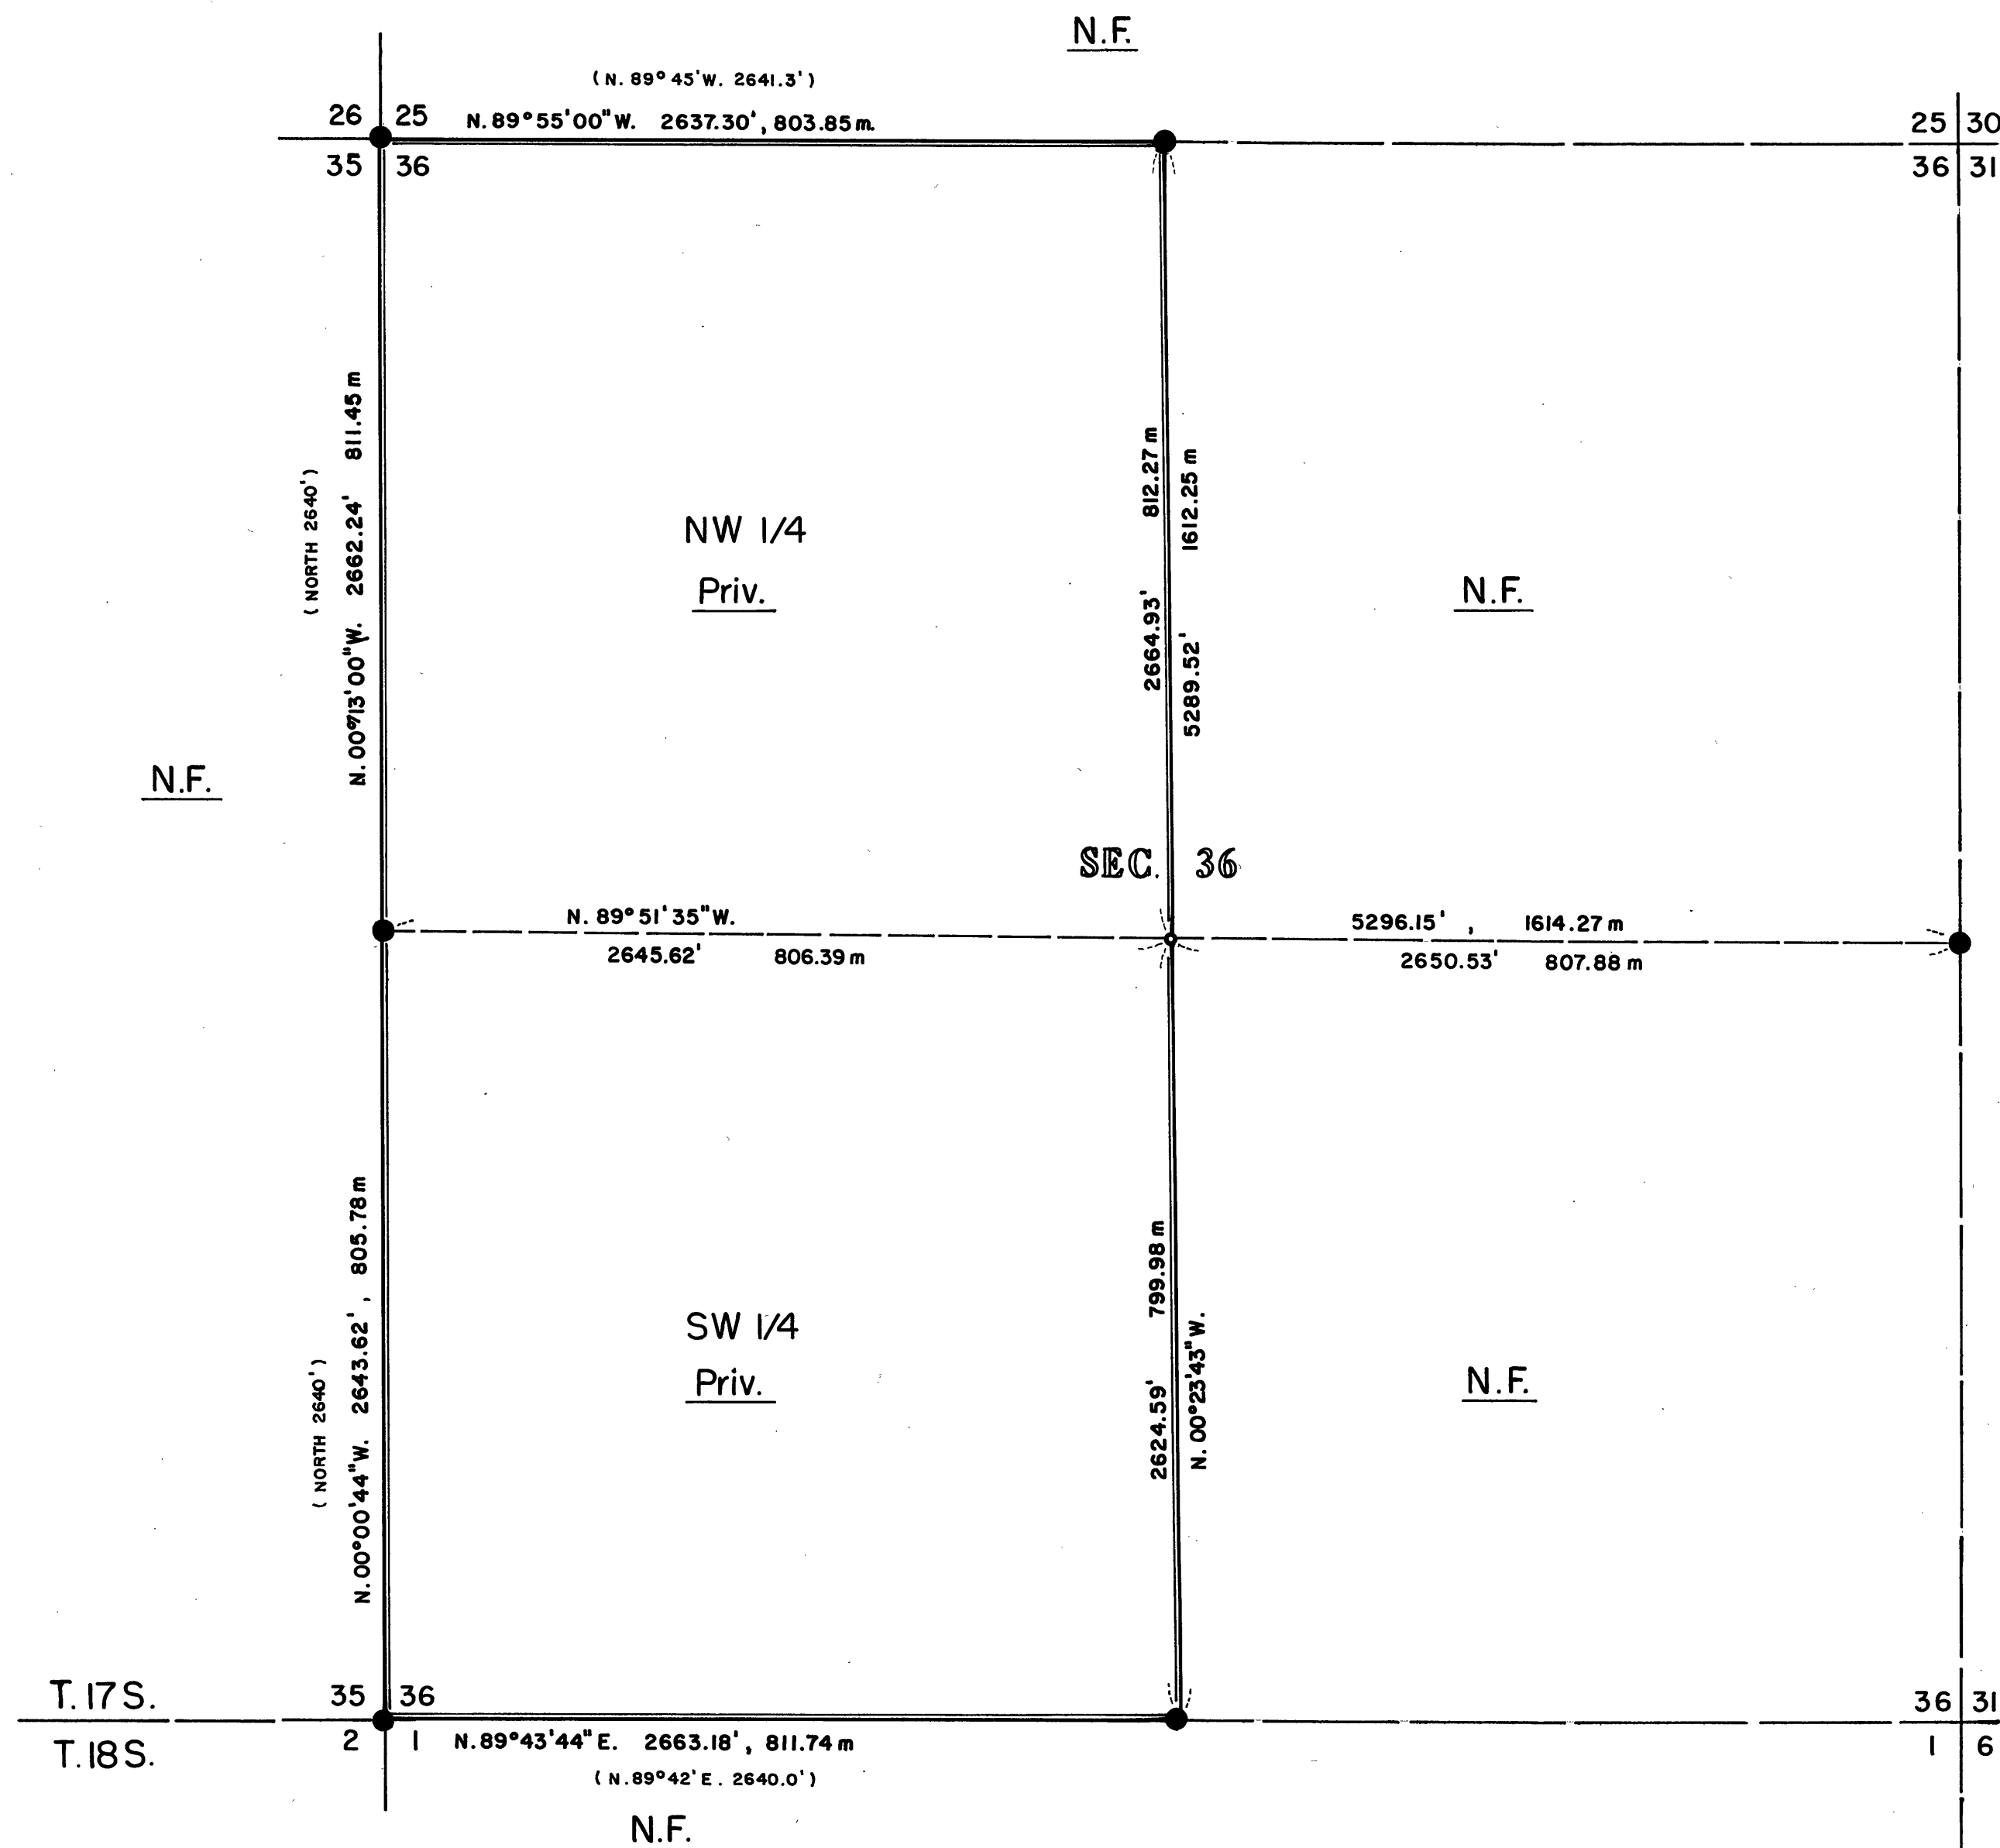

LEGEND

- Original G.L.O. corner found and monumented
- () Monument set
- Distance and/or Bearing of record
- National Forest boundary posted
- m Meters
- N.F. National Forest lands
- Priv. Privately owned lands

NOTES

- Bearings based on Solar Observations.
- For complete description of corners see "Certified Record of Land Corner Monumentation" sheets filed separately.
- For project description see "Project Narrative" filed separately.
- Original G.L.O. survey by Henry W. Cooke under Contract No. 470 dated April 14, 1885 and Contract No. 494, dated January 16, 1884.

CERTIFICATION

I, Charles F. Palmer, Land Surveyor registered in accord with the laws of the State of Oregon, do hereby certify this plat and the notes hereon to be a true representation of the survey that I performed during August and September, 1982 for the U.S. Forest Service and in accordance with the statutes of the State of Oregon and the Articles of my Contract (No. 53-04HI-2-8967 N).

Charles F. Palmer 11/12/82
CHARLES F. PALMER, P.L.S.
Oregon License No. 1287

GRANT COUNTY SURVEY NO. 737
Filed Nov. 23, 1982
By Robert D. Bayett

RECEIVED AND
FILED

NOV 23 1982

OFFICE OF COUNTY SURVEYOR
Robert D. Bayett
Attest: *Hammie Lawrence*

REGISTERED PROFESSIONAL LAND SURVEYOR <i>Charles F. Palmer</i> OREGON SEPTEMBER 23, 1977 CHARLES F. PALMER 1287	U.S.D.A., Forest Service		Malheur National Forest	
	SURVEY PLAT			
	Portion No. 1 of the "SILVIES CADASTRAL SURVEY"			
	Scale: 1" = 500'	Date: SEPT. 1982	Job: 709-1	
Dsn: -	M.A.P.'s	Sht. No.		
Drm: C.F.P.		of 1		
Ckd: C.F.P.	M. A. Palmer & Sons ENGINEERING & SURVEYING 254 N. Alder - Box 61 Burns, Oregon 97720			

MADOP SURVEY NO. 737