


Survey No. 74

TWN 11 S., R. 35 E. W. M.

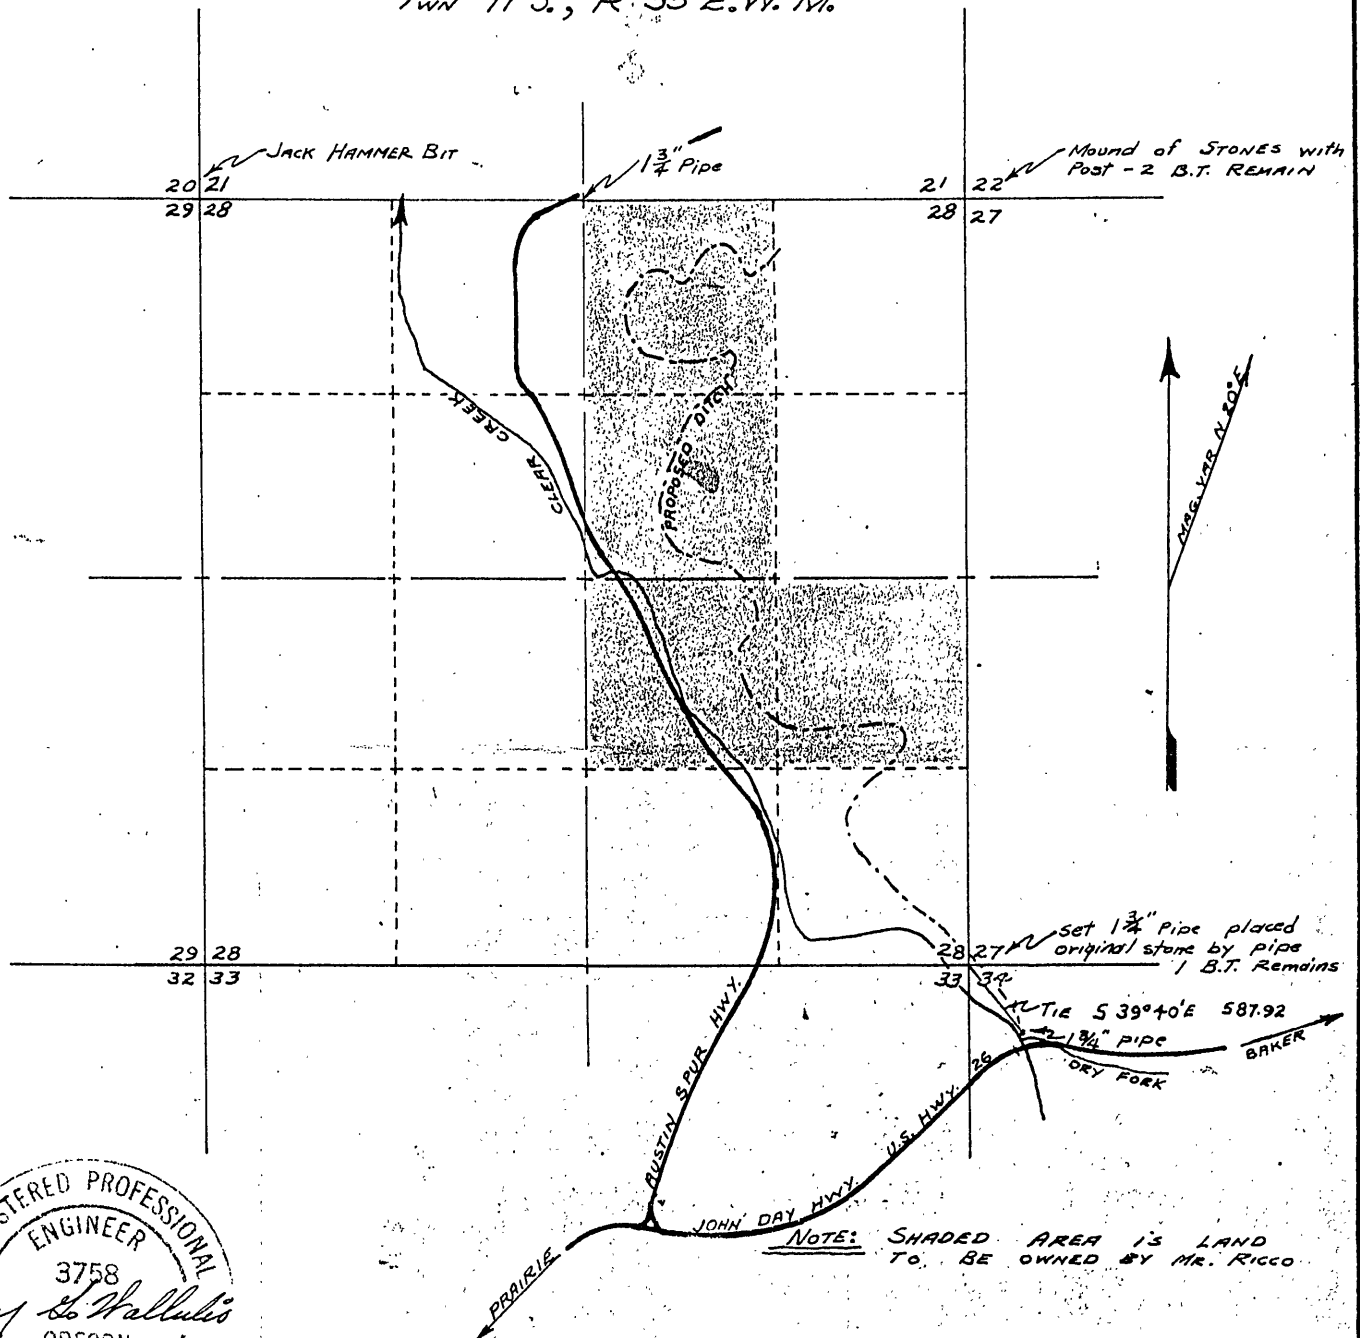

I, STANLEY G. WALLULIS, OF PENDLETON, OREGON DO
HEREBY CERTIFY THAT THIS MAP WAS MADE FROM NOTES TAKEN
DURING AN ACTUAL SURVEY MADE BY ME ON DECEMBER 10, 1962.

Stanley G. Wallulis

POINT OF DIVERSION
SURVEY ON CLEAR CREEK
FOR HENRY RICCO

Scale 4" = 1 mile

Date: 12-11-62

STANLEY G. WALLULIS
CONSULTING ENGINEER
P.O. Box 91

PENDLETON

OREGON

Survey # 74