

① T15S R29E
N 1/4
S13 S18
1982
RLS 934

N. 1/4 CORNER BETWEEN SECTION 13, T15S, R29E, AND SECTION 18, T15S, R29E
NO RECORD OF THIS CORNER FOUND. NO EVIDENCE FOUND.
AT PROPORTIONED POSITION I SET A 3"x30" AL. PIPE WITH A 3/4" AL. CAP STAMPED AS SHOWN,
6" ABOVE GROUND, IN STONE MOUND. MY NEW BT'S ARE AS FOLLOWS:
A 16" DBH. P. PINE, SCRIBED "N 1/4 S18 BT" BEARS N72°W, 65.8 FT.
A 36" DBH. P. PINE, SCRIBED "N 1/4 S18 BT" BEARS N40°E, 101.7 FT.

② T15S R29E
NW 1/4 S18
1982
RLS 934

N.W. 1/4 CORNER, SEC. 18, T15S, R29E
NO RECORD OF THIS CORNER FOUND. NO EVIDENCE FOUND.
AT CALCULATED POSITION I SET A 3"x30" AL. PIPE WITH A 3/4" AL. CAP STAMPED AS SHOWN,
8" ABOVE GROUND, IN STONE MOUND. MY NEW BT'S ARE AS FOLLOWS:
A 22" DBH. P. PINE, SCRIBED "NW 1/4 S18 BT" BEARS S61°W, 37.7 FT.
A 13 1/2" DBH. P. PINE, SCRIBED "NW 1/4 S18 BT" BEARS N30°W, 36.4 FT.

③ T15S R29E
W 1/4 S18
1982
RLS 934

C-W 1/4 CORNER, SECTION 18, T15S, R29E
NO RECORD OF THIS CORNER FOUND. NO EVIDENCE FOUND.
AT CALCULATED POSITION I SET A 3"x30" AL. PIPE WITH A 3/4" AL. CAP STAMPED AS SHOWN,
5" ABOVE GROUND, IN STONE MOUND. MY NEW BT'S ARE AS FOLLOWS:
A 11" DBH. P. PINE SCRIBED "C W 1/4 S18 BT" BEARS S72°E, 100.3 FT.
A 22" DBH. P. PINE SCRIBED "C W 1/4 S18 BT" BEARS N24°E, 85.8 FT.

④ T15S R29E
C 1/4 S18
1982
RLS 934

CENTER 1/4 CORNER, SECTION 18, T15S, R29E
NO RECORD OF THIS CORNER FOUND. NO EVIDENCE FOUND.
AT CALCULATED POSITION I SET A 3"x30" AL. PIPE WITH A 3/4" AL. CAP STAMPED AS SHOWN,
10" ABOVE GROUND IN STONE MOUND. MY NEW BT'S ARE AS FOLLOWS:
A 12" DBH. P. PINE, SCRIBED "C 1/4 S18 BT" BEARS N27°E, 75.0 FT.
A 24" DBH. P. PINE, SCRIBED "C 1/4 S18 BT" BEARS S77°E, 83.1 FT.

⑤ T15S R29E
S 1/4
S13 S18
1982
RLS 934

S. 1/4 CORNER BETWEEN SECTION 13, T15S, R29E, AND SECTION 18, T15S, R29E
NO RECORD OF THIS CORNER FOUND. NO EVIDENCE FOUND.
AT PROPORTIONED POSITION I SET A 3"x30" AL. PIPE WITH A 3/4" AL. CAP STAMPED AS SHOWN,
6" ABOVE GROUND, IN STONE MOUND. MY NEW BT'S ARE AS FOLLOWS:
A 10" DBH. D. FIR, SCRIBED "S 1/4 S13 BT" BEARS N53°W, 12.1 FT.
A 12" DBH. D. FIR, SCRIBED "S 1/4 S18 BT" BEARS N44°E, 28.1 FT.

⑥ T15S R29E
SW 1/4 S18
1982
RLS 934

S.W. 1/4 CORNER, SECTION 18, T15S, R29E
NO RECORD OF THIS CORNER FOUND. NO EVIDENCE FOUND.
AT CALCULATED POSITION I SET A 3"x30" AL. PIPE WITH A 3/4" AL. CAP STAMPED AS SHOWN,
6" ABOVE GROUND, IN STONE MOUND. MY NEW BT'S ARE AS FOLLOWS:
A 10" DBH. D. FIR, SCRIBED "SW 1/4 S18 BT" BEARS S40°W, 39.2 FT.
A 11 1/2" DBH. D. FIR, SCRIBED "SW 1/4 S18 BT" BEARS S67°E, 36.6 FT.

⑦ T15S R29E
S13 S18
S24 S19
1982
RLS 934

CORNER TO SECTIONS 13 AND 24, T15S, R29E, AND SECTIONS 18 AND 19, T15S, R29E
NO EVIDENCE FOUND
AT PROPORTIONED POSITION I SET A 3"x30" AL. PIPE WITH A 3/4" AL. CAP STAMPED AS SHOWN,
8" ABOVE GROUND, IN STONE MOUND. MY NEW BT'S ARE AS FOLLOWS:
A 11 1/2" DBH. P. PINE, SCRIBED "T15S R29E S13 BT" BEARS N43°E, 38.2 FT.
A 9" DBH. JUNIPER, SCRIBED "T15S R29E S13 BT" BEARS N58°W, 33.7 FT.
A 11 1/2" DBH. JUNIPER, SCRIBED "T15S R29E S24 BT" BEARS S66°W, 28.0 FT.
A 13" DBH. P. PINE, SCRIBED "T15S R29E S19 BT" BEARS S75°E, 44.7 FT.

⑧ T15S R29E
W 1/4 S18
1982
RLS 934


W. 1/4 CORNER BETWEEN SECTIONS 18 AND 19, T15S, R29E
NO RECORD OF THIS CORNER FOUND. NO EVIDENCE FOUND.
AT PROPORTIONED POSITION I SET A 3"x30" AL. PIPE WITH A 3/4" AL. CAP STAMPED AS SHOWN,
6" ABOVE GROUND, WITH STONES SET AROUND CORNER. MY NEW BT'S ARE AS FOLLOWS:
A 9" DBH. D. FIR, SCRIBED "W 1/4 S18 BT" BEARS S02°E, 16.9 FT.
A 15" DBH. D. FIR, SCRIBED "W 1/4 S18 BT" BEARS N51°W, 18.3 FT.

⑨ T15S R29E
1/4
S18 S17
1982
RLS 934

1/4 CORNER BETWEEN SECTIONS 17 AND 18, T15S, R29E
NO EVIDENCE FOUND
AT PROPORTIONED POSITION I SET A 3"x30" AL. PIPE WITH A 3/4" AL. CAP STAMPED AS SHOWN,
6" ABOVE GROUND, WITH STONES SET AROUND CORNER. MY NEW BT'S ARE AS FOLLOWS:
A 10" DBH. P. PINE, SCRIBED "1/4 S18 BT" BEARS N36°W, 46.0 FT.
A 11" DBH. P. PINE, SCRIBED "1/4 S17 BT" BEARS S74 1/2°E, 66.5 FT.

⑩ WC
TO
LINE TREE
10 FT.
1982
RLS 934

ORIGINAL LINE TREE WHICH LIES 7.22 CHAINS SOUTH OF CORNER TO SECTIONS 13, 18, 19 AND 24
ACCORDING TO ORIGINAL G.L.O. NOTES.
FOUND A 37" DBH. P. PINE SNAG (NO BARK) ABOUT 20' HIGH, BADLY ROTTED, WITH 2 HACKS ABOUT
10" APART, ON BOTH NORTH AND SOUTH SIDES OF TREE.
AS A WITNESS CORNER TO THE ORIGINAL LINE TREE I SET A 3"x30" AL. PIPE WITH A 3/4" AL. CAP
STAMPED AS SHOWN, AT A POINT 100.0 FT. NORTH OF THE LINE TREE AND ON THE SECTION LINE.
MY NEW BT'S ARE AS FOLLOWS: (BEARINGS AND DISTANCES ARE FROM WITNESS CORNER.)
A 8" DBH. JUNIPER, MARKED WITH AN "X" AT BREAST HT. AND "BT" ON A LOW BLAZE, BEARS S70°E, 12.5 FT.
A 11" DBH. D. FIR, MARKED WITH AN "X" AT BREAST HT. AND "BT" ON A LOW BLAZE, BEARS S70°W, 17.9 FT.

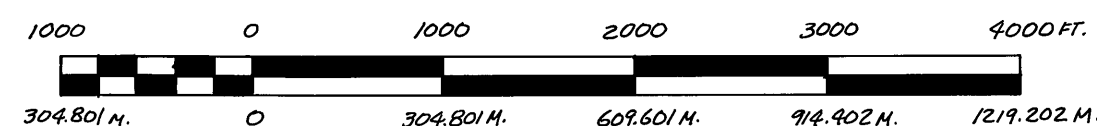


NOTE: FILED HERewith ARE U.S.F.S. FORMS RG-7100-57,
"CERTIFIED RECORD OF LAND CORNER MONUMENTATION" FOR
THE FOLLOWING CORNERS (DENOTED BY STANDARD INDEX FILE
NUMBERS) FOR T15S, R29E: J-1, J-3, J-5, L-1, L-5, N-1,
N-3, AND N-5.

THE ORIGINAL FIELD NOTES FOR THIS PLAT ARE IN TRAVERSE
BOOK 4 AND IN CORNER BOOKS 3 AND 4 FOR ALDRICH CADASTRAL
SURVEY.

LEGEND

- SET 3"x30" AL. PIPE WITH 3/4" AL. CAP FROM FOUND G.L.O.
EVIDENCE, USED FOR SURVEY CONTROL
- ⊙ SET 3"x30" AL. PIPE WITH 3/4" AL. CAP BY SINGLE OR DOUBLE
PROPORTIONMENT (NO EVIDENCE OF CORNER FOUND)
- CORNER CALCULATED ONLY, NOT FOUND OR SET
- M. METERS (UNLABELED DISTANCES ARE FEET)
- C.H. CHAINS
- () BEARINGS AND DISTANCES IN BRACKETS ARE FROM ORIGINAL
GOVERNMENT SURVEY NOTES.
- NATIONAL FOREST BOUNDARY, POSTED WITH STEEL OR WOODEN
POSTS AND U.S.F.S. PROPERTY BOUNDARY SIGN 54-2

MEAN MAGNETIC DECLINATION 17°15' EAST

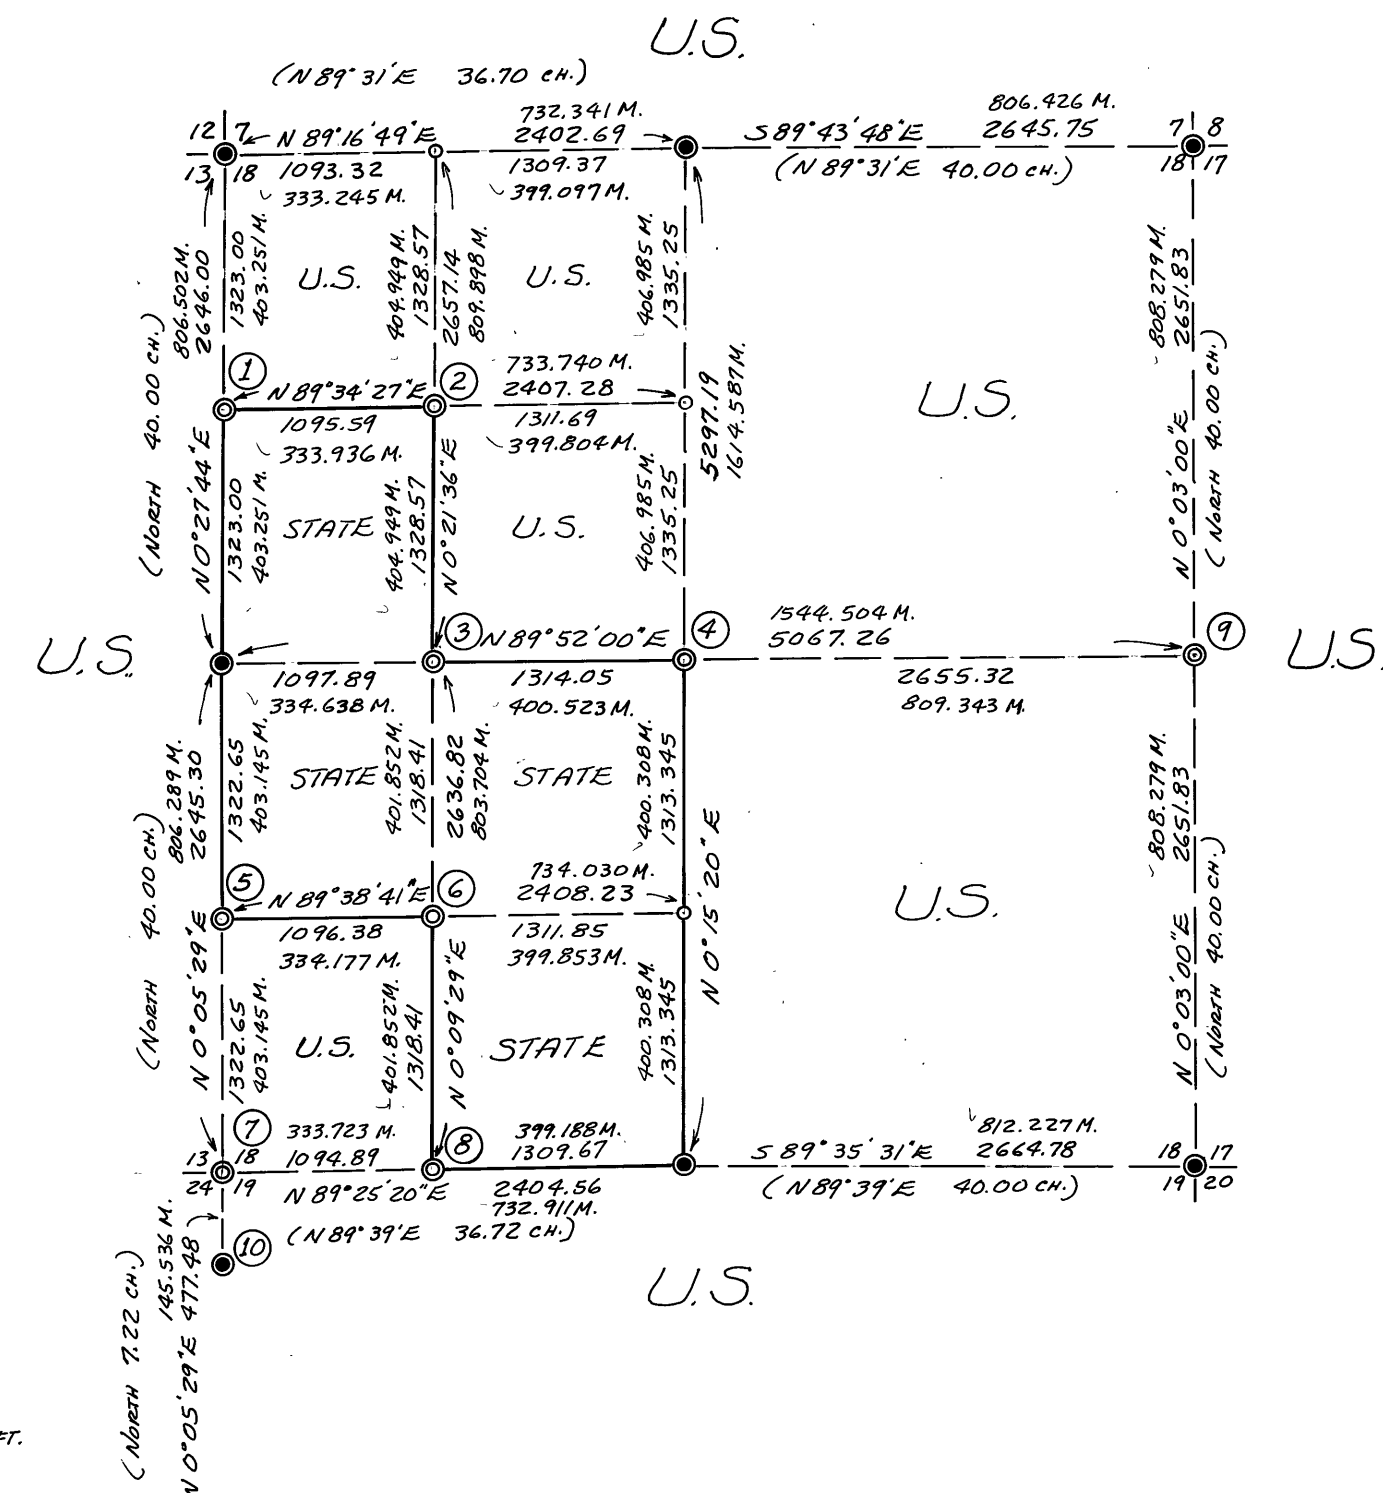

CERTIFICATION:

I, Victor M. McLind, a Registered Land Surveyor in the State
of Oregon, hereby certify that this plat and the notes hereon,
or attached, are a correct representation of a survey I performed
from July to November, 1982, for the U.S. Forest Service, in
accordance with the statutes of the State of Oregon and with
the articles of my contract.

REGISTERED
PROFESSIONAL
LAND SURVEYOR

VICTOR M. McLIND
JUL 15, 1970
VICTOR M. McLIND
934

Victor M. McLind
Victor M. McLind
Registered Land Surveyor
Oregon License No. 934

RECEIVED AND
FILED

JAN 18 1983

OFFICE OF COUNTY SURVEYOR

Attest: *[Signature]*

PLAT OF SURVEY

LOCATED IN
T.15S., R.29E., W.M., GRANT COUNTY, OREGON
FOR
THE UNITED STATES DEPARTMENT OF AGRICULTURE
MALHEUR NATIONAL FOREST

SURVEYED BY VICTOR M. McLIND, MILTON-FREEWATER, OR.
JULY- NOVEMBER, 1982 SCALE: 1"=1000'

BEARINGS TRUE, BASED ON SOLAR OBSERVATION

ALDRICH CADASTRAL SURVEY

CONTRACT NO. 53-04H1-2-8968N