(1)

T15S, R29E
W. P.
520 | 521
1982
RLS 934

ORIGINAL LINE TREE 25.48 CH. (RECORD) SOUTH OF SEC. COR. 16, 17, 21 & 22, T15S, R29E
FND. A 15½" D.B.H. PINE WINDFALL WITH 2 HACKS ABOUT 10" APART, ON BOTH NORTH AND SOUTH SIDES OF TREE.
AT LOCATION FORMERLY OCCUPIED BY THE LINE TREE I SET A 3"x 30" AL. PIPE WITH 3½" AL. CAP STAMPED AS SHOWN. MY NEW B.T.'s ARE AS FOLLOWS:
A 14½" D.B.H. D. FIR, MARKED WITH AN "X" AT BREAST HT. AND "BT" SCRIBED ON A LOW BLAZE, BEARS N 47°E, 24.7 FT.
A 13" D.B.H. D. FIR MARKED WITH AN "X" AT BREAST HT. AND "BT" SCRIBED ON A LOW BLAZE, BEARS N 7½°W, 29.3 FT.

(2)

T15S R29E
¼ S17 / S20
1982
RLS 934

¼ CORNER TO SECTIONS 17 AND 20, T15S, R29E
FND. OBT, A BADLY ROTTED P. PINE STUMP, 28" DIAM, 24" HIGH, BADLY WEATHERED FACE WITH SCRIBES "DT" VISIBLE, BEARS N 78°W, 17 LKS. = 11.2 FT.
AT RECORD BEARING AND DISTANCE FROM FOUND OBT STUMP I SET A 3"x 30" AL. PIPE WITH 3½" AL. CAP STAMPED AS SHOWN, 10" ABOVE GROUND, WITH MOUND OF STONES AROUND IT. MY NEW B.T.'s ARE AS FOLLOWS:
A 9½" D.B.H. P. PINE, SCRIBED "¼ S17 BT" BEARS N 32°W, 23.1 FT.
A 8½" D.B.H. P. PINE, SCRIBED "¼ S20 BT" BEARS S 39°W, 42.1 FT.

(3)

T15S R29E
S17 | S16
S20 | S21
1982
RLS 934

CORNER TO SECTIONS 16, 17, 20 & 21, T15S, R29E
NO EVIDENCE FOUND. BOTH OBT'S ARE LYING ON GROUND BUT HAVE BEEN DISTURBED BY CAT WORK (GRAVEL PIT) AT PROPORTIONED POSITION I SET A 3"x 30" AL. PIPE WITH 3½" AL. CAP STAMPED AS SHOWN, 12" ABOVE GROUND IN MOUND OF STONE, NEAR BOTTOM OF GRAVEL EXCAVATION. MY NEW BT'S ARE AS FOLLOWS:
A 6½" D.B.H. LODGEPOLE PINE, SCRIBED "T15S R29E S20 BT" BEARS S17½°W, 12.1 FT.
A 6½" D.B.H. LODGEPOLE PINE, SCRIBED "T15S R29E S21 BT" BEARS S44°E, 28.1 FT.
A 6½" D.B.H. P. PINE, SCRIBED "T15S R29E S16 BT" BEARS N41°E, 26.1 FT.
A 11" D.B.H. P. PINE, SCRIBED "T15S R29E S17 BT" BEARS N80°W, 91.3 FT.

(4)

T15S R29E
¼
S17 | S16
1982
RLS 934

¼ CORNER TO SECTIONS 16 & 17, T15S, R29E
NO EVIDENCE FOUND.
AT PROPORTIONED POSITION I SET A 3"x 30" AL. PIPE WITH A 3½" AL. CAP STAMPED AS SHOWN, 8" ABOVE GROUND, IN MOUND OF STONE. MY NEW BT's ARE AS FOLLOWS:
A 9" D.B.H. P. PINE, SCRIBED "¼ S17 BT" BEARS N 65½°W, 27.1 FT.
A 7" D.B.H. P. PINE, SCRIBED "¼ S16 BT" BEARS N 41°E, 42.4 FT.

(5)

T15S
R29E
S8 | S9
S17 | S16
OPLS 1805
1979

CORNER TO SECTIONS 8, 9, 16 & 17, T15S, R29E
FND. 3" AL. PIPE WITH 3½" FOREST SERVICE AL. CAP STAMPED AS SHOWN, 6" ABOVE GROUND WITH STONES SET AROUND. FND. BT'S AS FOLLOWS:
OBT, 19" D.B.H. P. PINE, FACE OPEN WITH SCRIBES "S17 T15 R29" VISIBLE, BEARS S16°W, 10.4 FT. (REC. S6°W 17 LKS. = 9.9 FT.) TREE IS DEAD
OBT, 18 P. PINE STUMP, 6" HIGH, BADLY WEATHERED FACE W/SCRIBES PARTLY VISIBLE, BEARS N72°E, 36.5 FT. (REC. N82½°E 54 LKS. = 35.6 FT.)
A 22" D.B.H. P. PINE, SCRIBES "T15S R29E S9 BT" VISIBLE, BEARS N76°E, 71.8 FT. (REC. N79°E, 71.8 FT.)
A 6" D.B.H. P. PINE, SCRIBES "T15S R29E S16 BT," BEARS S33°E, 49.7 FT. AS PER REC.
A 26" D.B.H. D. FIR, SCRIBES "T15S R29E S8" VISIBLE, BEARS N37°W, 57.2 FT. AS PER REC.
MY NEW BT, A 6½" D.B.H. P. PINE, SCRIBED "T15S R29E S17 BT" BEARS S45½°W, 56.4 FT.

(6)

T15S R29E
¼ S9 / S16
1982
RLS 934

¼ CORNER TO SECTIONS 9 & 16, T15S, R29E
FND. OBT, A 18" D.B.H. P. PINE WINDFALL, PARTLY OPEN FACE W/SCRIBES "¼ S BT" VISIBLE, BEARS S35°W 95 LKS. = 62.7 FT. (RECORD)
AT RECORD BEARING AND DIST. FROM OBT. I SET A 3"x 30" AL. PIPE W/3½" AL. CAP STAMPED AS SHOWN, 9" ABOVE GROUND, IN LARGE MOUND OF STONES. MY NEW BT'S ARE AS FOLLOWS:
A 13" D.B.H. P. PINE, SCRIBED "¼ S16 BT" BEARS S01°E, 64.2 FT.
A 13½" D.B.H. P. PINE, SCRIBED "¼ S9 BT" BEARS N67°W, 28.9 FT.

(7)

T15S R29E
S9 | S10
S16 | S15
1982
RLS 934

CORNER TO SECTIONS 9, 10, 15 & 16, T15S, R29E
NO EVIDENCE FOUND
AT PROPORTIONED POSITION I SET A 3"x 30" AL. PIPE WITH A 3½" AL. CAP STAMPED AS SHOWN. MY NEW BT'S ARE AS FOLLOWS:
A 11" D.B.H. D. FIR, SCRIBED "T15S R29E S16 BT" BEARS S71°W, 27.5 FT.
A 8" D.B.H. D. FIR, SCRIBED "T15S R29E S9 BT" BEARS N43½°W, 15.4 FT.
A 7" D.B.H. D. FIR, SCRIBED "T15S R29E S10 BT" BEARS N69°E, 9.4 FT.
A 12½" D.B.H. TAMARACK, SCRIBED "T15S R29E S15 BT" BEARS S39½°E, 35.5 FT.

(8)

T15S R29E
S4 | S3
S9 | S10
1982
RLS 934

CORNER TO SECTIONS 3, 4, 9 & 10, T15S, R29E
FND. STONE 21"x 14"x 13" STANDING CARDINAL WITH 3 NOTCHES ON W. EDGE AND A FAINT ¼" ON TOP, FROM WHICH:
OBT, 30" D.B.H. FIR, FACE PARTLY OPENED, SCRIBES "S4 T1 R2" VISIBLE, BEARS N89°W 4.8 FT. (REC. N89°W 7 LKS. = 4.6 FT.)
OBT, 19" D.B.H. FIR, NICE SCAR HAS BEEN PARTLY OPENED BUT NO SCRIBES VISIBLE, BEARS S45°E 6.2 FT. (REC. S81°E 9 LKS. = 5.9 FT.)
IN PLACE OF FOUND STONE MON. I SET A 3"x 30" AL. PIPE WITH A 3½" AL. CAP STAMPED AS SHOWN, 5" ABOVE GROUND, BURIED ORIG. STONE ALONGSIDE, AND SET STONES AROUND CORNER. MY NEW BT'S ARE AS FOLLOWS:
A 13½" D.B.H. D. FIR, SCRIBED "T15S R29E S3 BT" BEARS N29°E, 40.3 FT.
A 13½" D.B.H. D. FIR, SCRIBED "T15S R29E S10 BT" BEARS S37½°E, 60.8 FT.
A 31" D.B.H. P. PINE, SCRIBED "T15S R29E S9 BT" BEARS S39°W, 60.7 FT.

SCALE : 1" = 1000'

1000 0 1000 2000 3000 4000 FT.
304.801 M. 0 304.801 M. 609.601 M. 914.402 M. 1219.202 M.

LEGEND

- FOUND ALUMINUM CAP, USED FOR SURVEY CONTROL
- SET 3"x 30" AL. PIPE WITH 3½" AL. CAP FROM FOUND G.L.O. EVIDENCE, USED FOR SURVEY CONTROL
- SET 3"x 30" AL. PIPE WITH 3½" AL. CAP BY SINGLE OR DOUBLE PROPORTIONMENT (SEARCHED FOR ORIGINAL CORNER BUT FOUND NO EVIDENCE)
- M METERS (UNLABELED DISTANCES ARE FEET)
- CH. CHAINS
- ( ) BEARINGS AND DISTANCES IN BRACKETS ARE FROM ORIGINAL GOVERNMENT SURVEY NOTES
- NATIONAL FOREST BOUNDARY, POSTED WITH STEEL OR WOODEN POSTS AND U.S.F.S. PROPERTY BOUNDARY SIGN 54-Z

MEAN MAGNETIC DECLINATION 17°30' EAST

NOTE: FILED HEREWITH ARE U.S.F.S. FORMS R6-7100-57 "CERTIFIED RECORD OF LAND CORNER MONUMENTATION" FOR THE FOLLOWING CORNERS: (DENOTED BY STANDARD INDEX FILE NUMBERS) E-13, J-9, J-11, J-13, J-15, L-9, L-13, N-7, N-9, N-11, N-13, ALL IN T15S, R29E.

THE ORIGINAL FIELD NOTES FOR THIS PLAT ARE IN TRAVERSE BOOKS NOS. 5 AND 6 AND IN CORNER BOOKS 3 AND 4 FOR ALDRICH CADASTRAL SURVEY.

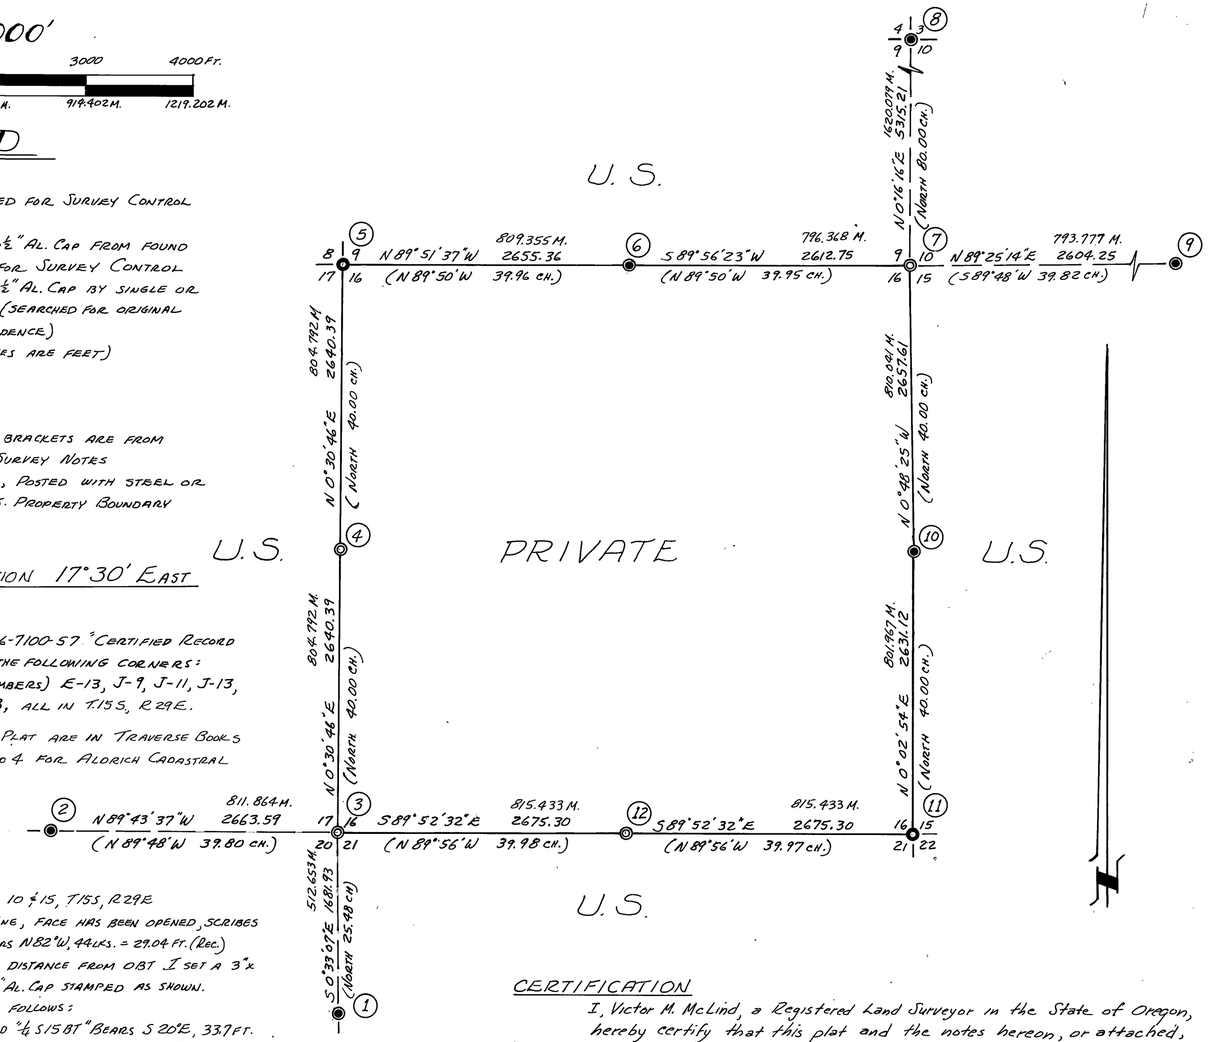

(9)

T15S R29E
¼ S10 / S15
1982
RLS 934

¼ CORNER TO SECTIONS 10 & 15, T15S, R29E
FND OBT, A 31" D.B.H. P. PINE, FACE HAS BEEN OPENED, SCRIBES "¼ 2 BT" VISIBLE, BEARS N82°W, 44 LKS. = 29.04 FT. (REC.)
AT RECORD BEARING AND DISTANCE FROM OBT I SET A 3"x 30" AL. PIPE WITH A 3½" AL. CAP STAMPED AS SHOWN.
MY NEW BT'S ARE AS FOLLOWS:
A 12" DBH P. PINE, SCRIBED "¼ S15 BT" BEARS S 20°E, 33.7 FT.
A 11" DBH P. PINE, SCRIBED "¼ S10 BT" BEARS N 73½°E, 24.7 FT.

(10)

T15S R29E
¼
S16 | S15
1982
RLS 934

¼ CORNER TO SECTIONS 15 & 16, T15S R29E
FND. OBT, A 32" PINE WINDFALL, BARK GONE AND FACE EXPOSED AND WEATHERED, SCRIBES "¼ S BT" VISIBLE, BEARS N 87°E 28 LKS. = 18.48 FT. (RECORD)
AT RECORD BEARING & DISTANCE FROM OBT I SET A 3"x 30" AL. PIPE WITH A 3½" AL. CAP STAMPED AS SHOWN, 4" ABOVE GROUND IN STONE MOUND. MY NEW BT'S ARE AS FOLLOWS:
A 10½" D.B.H. D. FIR, SCRIBED "¼ S16 BT," BEARS S 42½°W, 7.1 FT.
A 10½" D.B.H. D. FIR, SCRIBED "¼ S15 BT", BEARS S 76½°E, 30.5 FT.

(11)

T15S
R29E
S16 | S15
S21 | S22
OPLS 1805
1979

CORNER TO SECTIONS 15, 16, 21 & 22, T15S, R29E
FND. 3" AL. PIPE WITH A 3½" FOREST SERVICE AL. CAP STAMPED AS SHOWN, 8" ABOVE GROUND.
OBT, A 25" D.B.H. P. PINE SNAG, OPEN FACE WITH SCRIBES "S21 T15S R29 BT" VISIBLE, BEARS S89°W, 30.2 FT. (REC. S89°W 45 LKS. = 29.7 FT.)
OBT, A 36" DBH P. PINE SNAG, OPEN FACE WITH SCRIBES "S 22 T15 R29 BT" VISIBLE, BEARS S48°E, 27.5 FT (REC. S 52°E, 41 LKS = 27.1 FT.)
A 12" DBH D. FIR, FACE W/SCRIBES "T15S R29E S22 BT" VISIBLE, BEARS S82°E, 14.4 FT. AS PER REC.
A 10" DBH D. FIR, FACE W/SCRIBES "T15 S R29E S15 BT" VISIBLE, BEARS N73°E, 21.8 FT. AS PER REC.
A 9" D.B.H. D. FIR, FACE W/SCRIBES "T15S R29E S16 BT" VISIBLE, BEARS N 76°W, 20.5 FT. (REC. N78°W, 20.7 FT.)
A 8" D.B.H. D. FIR, FACE W/SCRIBES "T15S R29E S21 BT" VISIBLE, BEARS S 23°W, 19.5 FT. AS PER REC.

(12)

WC
← 20 FT
T15S R29E
¼ S16 / S21
1982
RLS 934

¼ CORNER TO SECTIONS 16 & 21, T15S, R29E
NO EVIDENCE FOUND.
PROPORTIONED POSITION FALLS IN MURDERER'S CREEK
FOR WITNESS CORNER I SET A 3"x 30" AL. PIPE WITH A 3½" AL. CAP STAMPED AS SHOWN, ON SECTION LINE AND 20.00 FT. EASTERLY FROM TRUE CORNER, 4" ABOVE GROUND, IN STONE MOUND.
MY NEW BT'S TO WITNESS CORNER ARE AS FOLLOWS:
A 14" D.B.H. P. PINE, MARKED WITH AN "X" AT BREAST HT. AND "BT" ON A LOW BLAZE, BEARS N10°W, 32.0 FT. FROM WITNESS CORNER.
A 26½" D.B.H. P. PINE, MARKED WITH AN "X" AT BREAST HT. AND "BT" ON A LOW BLAZE, BEARS S03°E, 58.8 FT. FROM WITNESS CORNER.

CERTIFICATION

I, Victor M. McLind, a Registered Land Surveyor in the State of Oregon, hereby certify that this plat and the notes hereon, or attached, are a correct representation of a survey I performed from July to November, 1982, for the U.S. Forest Service, in accordance with the statutes of the State of Oregon and with articles of my contract.

Victor M. McLind
Victor M. McLind
Registered Land Surveyor
Oregon License No. 934

REGISTERED PROFESSIONAL LAND SURVEYOR

OREGON
JULY 17, 1970
VICTOR M. McLIND
934

RECEIVED AND FILED
JAN 18 1983
OFFICE OF COUNTY SURVEYOR
Robert D. Sagen
Attest: Joanne E. Lawrence

PLAT OF SURVEY

LOCATED IN
T.15 S., R.29 E., W.M., GRANT COUNTY, OREGON
FOR
THE UNITED STATES DEPARTMENT OF AGRICULTURE
MALHEUR NATIONAL FOREST
SURVEYED BY VICTOR M. McLIND, MILTON-FREEWATER, OR.
JULY - NOVEMBER, 1982 SCALE : 1" = 1000'
BEARINGS TRUE, BASED ON SOLAR OBSERVATION

ALDRICH CADASTRAL SURVEY

CONTRACT NO. 53-04H1-2-B968N

MAP OF SURVEY NO. 743