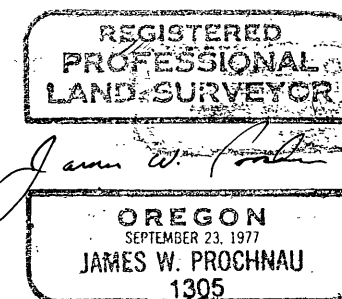


CORNER NO.	MONUMENT	ACCESSORIES	CORNER NO.	MONUMENT	ACCESSORIES
①	FD. 2 1/2" ALUM. CAP IN 1/4" GI PIPE SET BY HAMBLETON.	FD. HAMBLETON BTS: 9" COTTONWOOD BEARS N23°E 15.4 FT.; 9" LP PINE SNAG BEARS S70°W 4.1 FT.; 14" LP PINE BEARS N60°W 33.5 FT. SCRIBED BTS: 8" LARCH BEARS S37°W 15.6 FT., SCRIBED T9S R35E S34 BT; 6" W. FIR BEARS S45°E 37.3 FT., SCRIBED T9S R35E S35 BT.	⑭	FD. 2 1/2" ALUM. CAP IN 1" G.I. PIPE SET BY HAMBLETON BEARS N73°47'51"W 39.27 FT. FROM CORRECT POSITION. SET 2 1/2" BRASS CAP IN 2 1/2" X30" GI PIPE - ROCK MOUND.	FD. HAMBLETON BTS FROM HIS MONUMENT: 13" LARCH BEARS N18°E 33.7 FT.; 18" SPRUCE BEARS S42°E 31.0 FT. SCRIBED BTS: 8" W. FIR BEARS S39°E 3.1 FT., SCRIBED C-E-SW-NW 1/256 S35 BT; 8" W. FIR BEARS N29°E 19.8 FT., SCRIBED C-E-SW-NW 1/256 S35 BT.
②	FD. 2 1/2" ALUM. CAP IN 1/4" GI PIPE SET BY HAMBLETON BEARS N 9° 21' 18" W 12.31 FT. FROM CORRECT POSITION. SET 2 1/2" BRASS CAP IN 2 1/2" X30" G.I. PIPE - ROCK MOUND.	SCRIBED BTS: 7" LP PINE BEARS EAST 15.7 FT., SCRIBED W-W 1/64 S26 BT; 6" LP PINE BEARS S25°E 38.7 FT., SCRIBED W-W 1/64 S35 BT.	⑮	SET 2 1/2" BRASS CAP IN 2 1/2" X 30" GI PIPE - ROCK MOUND.	SCRIBED BTS: 8" LP PINE BEARS N21°W 7.8 FT., SCRIBED C-E-W-W 1/256 S35 BT; 7" LP PINE BEARS N47°E 14.2 FT., SCRIBED C-E-W-W 1/256 S35 BT.
③	FD. 2 1/2" ALUM. CAP IN 1" GI PIPE SET BY HAMBLETON BEARS N 11° 17' 52" W 18.33 FT. FROM CORRECT POSITION. SET 2 1/2" BRASS CAP IN 2 1/2" X30" GI PIPE - ROCK MOUND.	FD. HAMBLETON BTS FROM HIS MONUMENT: 6" LP PINE BEARS N58°W 7.4 FT.; 7" LP PINE SNAG BEARS S66°E 14.3 FT. SCRIBED BTS: 6" LARCH BEARS N62°W 33.6 FT., SCRIBED E-W-W 1/256 S26 BT; 8" LARCH BEARS S36°W 24.4 FT., SCRIBED E-W-W 1/256 S35 BT.	⑯	FD. 2 1/2" ALUM. CAP IN 1" GI PIPE SET BY HAMBLETON BEARS N85° 18' 59" W 79.51 FT. FROM CORRECT POSITION. SET 2 1/2" BRASS CAP IN 2 1/2" X 30" GI PIPE - ROCK MOUND.	FD. HAMBLETON BTS FROM HIS MONUMENT: 12" LP PINE SNAG BEARS N62°W 3.7 FT.; 8" LP PINE WINDTHROW BEARS N 04°E 14.0 FT. SCRIBED BTS: 9" LARCH BEARS S61°W 56.1 FT., SCRIBED C-E-W-SW 1/256 S35 BT; 5" D. FIR BEARS N80°W 33.3 FT., SCRIBED C-E-W-SW 1/256 S35 BT.
④	FD. 1" GI PIPE IN STONE MOUND AT CORNER POSITION. SET 2 1/2" BRASS CAP IN 2 1/2" X30" GI PIPE - ROCK MOUND.	FD. ORIG. BTS: 12" LARCH BEARS N10°W 9.2 FT., 16" LARCH (DOWN) BEARS S50°W 4.0 FT.; FD. 2 1/2" GI PIPE BEARS N15°E 8 FT. IN ROOT HOLE OF ORIG. 12" LARCH. SCRIBED BTS: 7" LP PINE BEARS S30°E 14.6 FT., SCRIBED 1/4 S35 BT; 7" LP PINE BEARS N56°E 13.4 FT., SCRIBED 1/4 S26 BT.	⑰	FD. 2 1/2" ALUM. CAP IN 1" GI PIPE SET BY HAMBLETON BEARS N77° 02' E 88.82 FT. FROM CORRECT POSITION. SET 2 1/2" BRASS CAP IN 2 1/2" X 30" GI PIPE - ROCK MOUND.	FD. HAMBLETON BTS FROM HIS MONUMENT: 18" D. FIR BEARS S77°W 6.4 FT.; 10" D. FIR BEARS N53°E 23.9 FT. SCRIBED BTS: 8" D. FIR BEARS S28°W 53.9 FT., SCRIBED C-W -E-SW 1/256 S35 BT; 5" W. FIR BEARS N58°W 13.3 FT., SCRIBED C-W-E-SW 1/256 S35 BT.
⑤	FD. 22" X12" X12" STONE MARKED WITH NOTCH ON SE SIDE. SET 2 1/2" BRASS CAP IN 2 1/2" X30" GI PIPE - ROCK MOUND.	FD. ORIG. BTS: 14" LARCH SNAG BEARS N20°E 4.4 FT.; 30" W. FIR, ROTTEN SNAG, BEARS S25°E 48.2 FT.; 20" D. FIR, ROTTEN DOWN, BEARS S80°W 81.2 FT. SCRIBED BTS: 10" D. FIR BEARS N7°W 45.3 FT., SCRIBED T9S R35E S26 BT; 10" LP PINE BEARS N28°E 22.6 FT., SCRIBED T9S R35E S25 BT; 12" LARCH BEARS S88°E 11.9 FT., SCRIBED T9S R35E S36 BT; 10" W. FIR BEARS S18°W 86.4 FT., SCRIBED T9S R35E S35 BT.	⑱	SET 2 1/2" BRASS CAP IN 2 1/2" X 30" GI PIPE - ROCK MOUND.	SCRIBED BTS: 5" D. FIR BEARS N33°E 20.6 FT., SCRIBED C-W-E-W 1/256 S35 BT; 5" W. FIR BEARS S55°E 16.9 FT., SCRIBED C-W-E-W 1/256 S35 BT.
⑥	FD. 14" X8" X6" STONE MARKED 1/4 ON WEST FACE. SET 2 1/2" BRASS CAP IN 2 1/2" X30" GI PIPE - ROCK MOUND.	FD. ORIG. BT: 35" P. PINE BEARS S33°W 39.15 FT., SCRIBED BTS: 11" D. FIR BEARS S55°W 52.2 FT., SCRIBED 1/4 S35 BT; 16" P. PINE BEARS N35°E 11.2 FT., SCRIBED 1/4 S36 BT.	⑲	FD. 2 1/2" ALUM. CAP IN 1" GI PIPE SET BY HAMBLETON BEARS N33° 37' 46" E 35.12 FT. FROM CORRECT POSITION. SET 2 1/2" BRASS CAP IN 2 1/2" X30" GI PIPE - ROCK MOUND.	FD. HAMBLETON BTS FROM HIS MONUMENT: 16" D. FIR BEARS S21°W 8.3 FT.; 20" P. PINE BEARS S61°W 7.2 FT. SCRIBED BTS: 9" D. FIR BEARS N33°E 8.5 FT., SCRIBED SW-NE-NW 1/256 S35 BT; 12" D. FIR BEARS S19°E 43.1 FT., SCRIBED SW-NE-NW 1/256 S35 BT.
⑦	FD. 2 1/2" BRASS CAP IN 2 1/2" GI PIPE. PIPE SET BY HAMBLETON, CAP SET ON PIPE BY BARBOUR LS 1051.	FD. BARBOUR BTS: 11" LP PINE BEARS N81°E 23.2 FT.; 10" LP PINE BEARS S64°E 22.0 FT.; 24" D. FIR BEARS S62°W 16.0 FT.; 10" LP PINE WINDTHROW BEARS N17°W 57.8 FT.	⑳	FD. 2 1/2" ALUM. CAP IN 1" GI PIPE SET BY HAMBLETON BEARS N38° 21' 41" E 29.60 FT. FROM CORRECT POSITION. SET 2 1/2" BRASS CAP IN 2 1/2" X 30" GI PIPE - ROCK MOUND.	FD. HAMBLETON BTS FROM HIS MONUMENT: 7" LP PINE SNAG BEARS N19°W 3.3 FT.; 9" LP PINE SNAG BEARS S84°W 8.2 FT. SCRIBED BTS: 5" D. FIR BEARS N64°E 7.9 FT., SCRIBED C-S-N-NW 1/256 S35 BT; 5" LARCH BEARS S13°W 45.7 FT., SCRIBED C-S-N-NW 1/256 S35 BT.
⑧	FD. 2 1/2" ALUM. CAP IN 1 1/2" GI PIPE SET BY HAMBLETON LS 645.	FD. ORIG. BTS: 29" P. PINE BEARS S70°E 8.6 FT.; 14" D. FIR BEARS N80°E 15.2 FT.	㉑	FD. 2 1/2" ALUM. CAP IN 1" GI PIPE SET BY HAMBLETON BEARS N25° 54' 59" W 24.31 FT. FROM CORRECT POSITION. SET 2 1/2" BRASS CAP IN 2 1/2" X 30" GI PIPE - ROCK MOUND.	FD. HAMBLETON BTS FROM HIS MONUMENT: 8" D. FIR BEARS N44°W 11.5 FT.; 18" D. FIR BEARS N85°E 11.2 FT. SCRIBED BTS: 9" P. PINE BEARS S31°E 31.8 FT., SCRIBED C-N-NW 1/64 S35 BT; 12" P. PINE BEARS S39°W 34.1 FT., SCRIBED C-N-NW 1/64 S35 BT.
⑨	FD. 2 1/2" ALUM. CAP IN 1 1/2" GI PIPE SET BY HAMBLETON.	FD. ORIG. BTS: 37" P. PINE STUMP BEARS N50°E 24.4 FT.; 22" D. FIR SNAG BEARS S30°W 66.7 FT. FD. BARBOUR BTS: 8" W. FIR BEARS N60°E 39.0 FT.; 12" D. FIR BEARS S27°E 19.0 FT.; 10" W. FIR BEARS S50°W 33.0 FT.; 8" D. FIR BEARS N40°W 41.0 FT.	㉒	FD. 2 1/2" ALUM. CAP IN 1" G.I. PIPE SET BY HAMBLETON BEARS N28° 11' 59" E 19.96 FT. FROM CORRECT POSITION. SET 2 1/2" BRASS CAP IN 2 1/2" X 30" G.I. PIPE - ROCK MOUND.	FD. HAMBLETON BT FROM HIS MONUMENT: 11" LP PINE BEARS N17°E 6.3 FT. SCRIBED BTS: 9" W. FIR BEARS S3°E 27.8 FT., SCRIBED C-E-NW-NW 1/256 S35 BT; 6" D. FIR BEARS S85°W 21.0 FT., SCRIBED C-E-NW-NW 1/256 S35 BT.
⑩	SET 2 1/2" BRASS CAP IN 2 1/2" X30" GI PIPE.	SCRIBED BTS: 15" W. FIR BEARS S42°W 6.8 FT., SCRIBED 1/4 S34 BT; 11" LARCH BEARS S61°E 40.9 FT., SCRIBED 1/4 S35 BT.	㉓	SET 2 1/2" BRASS CAP IN 2 1/2" X 30" G.I. PIPE - ROCK MOUND.	SCRIBED BTS: 5" D. FIR BEARS S37°E 30.5 FT., SCRIBED C 1/4 S35 BT; 5" W. FIR BEARS N8°W 17.5 FT., SCRIBED C 1/4 S35 BT.
⑪	FD. 2 1/2" ALUM. CAP IN 1" GI PIPE SET BY HAMBLETON BEARS S80° 21' 33" W 19.57 FT. FROM CORRECT POSITION. SET 2 1/2" BRASS CAP IN 2 1/2" X30" GI PIPE - ROCK MOUND.	FD. HAMBLETON BTS FROM HIS MONUMENT: 10" LP PINE WINDTHROW BEARS S32°E 8.9 FT.; 10" LP PINE WINDTHROW BEARS N55°W 11.4 FT. SCRIBED BTS: 9" W. FIR BEARS S8°E 27.0 FT., SCRIBED S-N-W 1/256 S35 BT; 6" W. FIR BEARS N73°W 23.1 FT., SCRIBED S-N-W 1/256 S34 BT.	NOTE: ALL NEW BTS ARE FACED AND MARKED PER BLM MANUAL AND IN ADDITION HAVE A BRASS WASHER MARKED LS 1305 NAILED FLUSH IN LOWER BLAZE. ALL BTS ARE PAINTED WITH 6" RED BAND AND TAGGED WITH APPROPRIATE SIGNS. ALL CAPS ARE STAMPED AS PER BLM MANUAL PLUS THE TOWNSHIP, RANGE, 1982 AND DLS 1305. 6" STEEL POSTS WITH APPROPRIATE SIGNS WERE SET 3 TO 5 FT. FROM ALL CORNERS AS PER CONTRACT. FIELD NOTES ARE IN BOOKS A, B, C, E AND M. CONTRACT NO. 53-04M3-2-2789.		
⑫	FD. 2 1/2" ALUM. CAP IN 1" GI PIPE SET BY HAMBLETON BEARS N 82° 24' 42" W 18.91 FT. FROM CORRECT POSITION. SET 2 1/2" BRASS CAP IN 2 1/2" X30" GI PIPE - ROCK MOUND.	FD. HAMBLETON BT FROM HIS MONUMENT: 9" W. FIR BEARS N47°W 20.1 FT. SCRIBED BTS: 5" W. FIR BEARS N11°E 3.7 FT., SCRIBED SW-NW-NW 1/256 S35 BT; 7" W. FIR BEARS S77°W 9.8 FT., SCRIBED SW-NW-NW 1/256 S35 BT.			
⑬	FD. 2 1/2" ALUM. CAP IN 1 1/2" GI PIPE SET BY HAMBLETON BEARS S86° 29' 09" W 38.34 FT. FROM CORRECT POSITION. SET 2 1/2" BRASS CAP IN 2 1/2" X30" GI PIPE - ROCK MOUND.	FD. HAMBLETON BTS FROM HIS MONUMENT: 5" LP PINE BEARS N45°W 1.1 FT.; 5" LP PINE SNAG BEARS N33°E 7.6 FT. SCRIBED BTS: 8" W. FIR BEARS S24°E 6.0 FT., SCRIBED C-W-SW-NW S35 BT; 7" W. FIR BEARS N25°E 10.3 FT., SCRIBED C-W-SW-NW S35 BT.			

REGISTERED
PROFESSIONAL
LAND SURVEYOR

RECEIVED AND
FILED

JAN 2 5 1983

OFFICE OF COUNTY SURVEYOR
Attest: *[Signature]*