


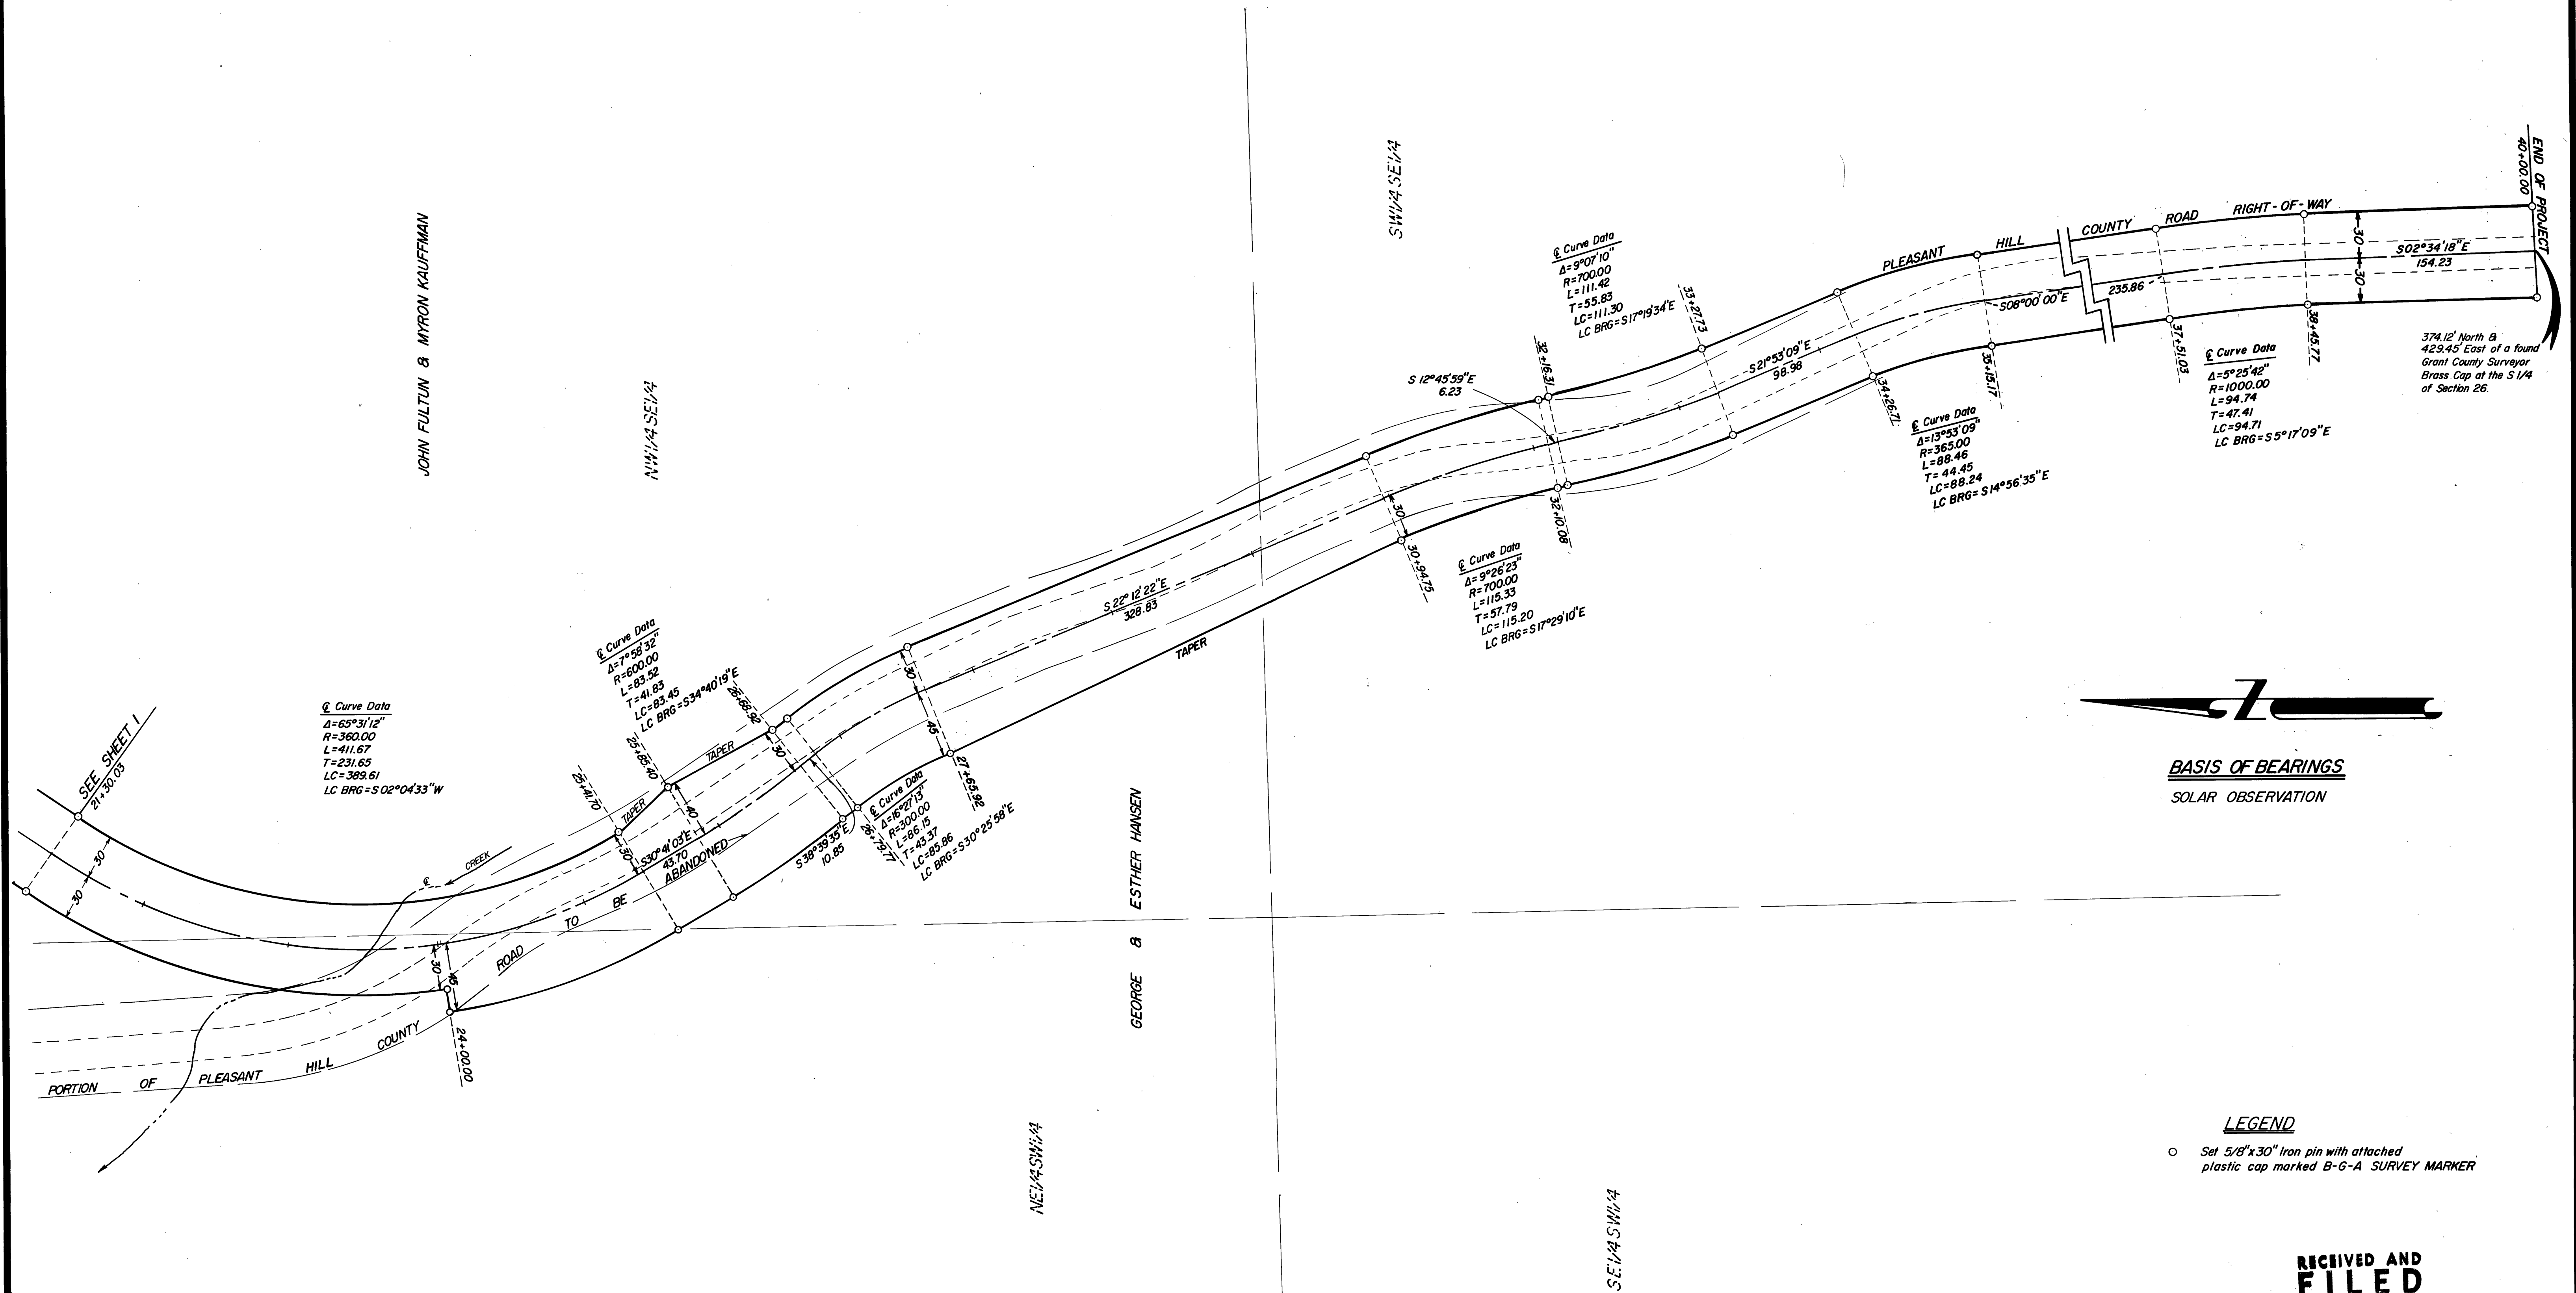

BASIS OF BEARINGS
SOLAR OBSERVATION

LEGEND

- Set 5/8"x30" Iron pin with attached plastic cap marked B-G-A SURVEY MARKER

RECEIVED AND FILED

JUN 15 1983

OFFICE OF COUNTY SURVEYOR
Robert D. Bagett
Attest: *Myron Kauffman*

REGISTERED
PROFESSIONAL
LAND SURVEYOR
Robert D. Bagett
OREGON
JULY 14, 1983
ROBERT D. BAGETT
598

BAGETT - GRIFFITH & ASSOCIATES John Day, Oregon		
MAP OF SURVEY		
RELOCATION OF A PORTION OF THE PLEASANT HILL COUNTY ROAD, COUNTY ROAD NO. 49 SITUATED IN SECTION 26, T13S, R30E, WM GRANT COUNTY, OREGON		
SURVEYED FOR	GRANT COUNTY ROAD DEPARTMENT	
SURVEYED BY	R.D.B. & D.I.G.	Feb-June 83
Scale: 1" = 50'	Drawn by: J.L.W.	6/83