


TOWNSHIP 17 SOUTH, RANGE 31 EAST, OF THE WILLAMETTE MERIDIAN, OREGON.

CORRECTIVE DEPENDENT RESURVEY

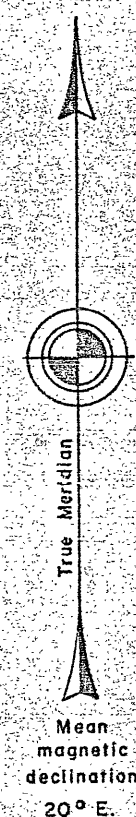


Sec. 16

Sec. 10

Sec. 15

Sec. 14

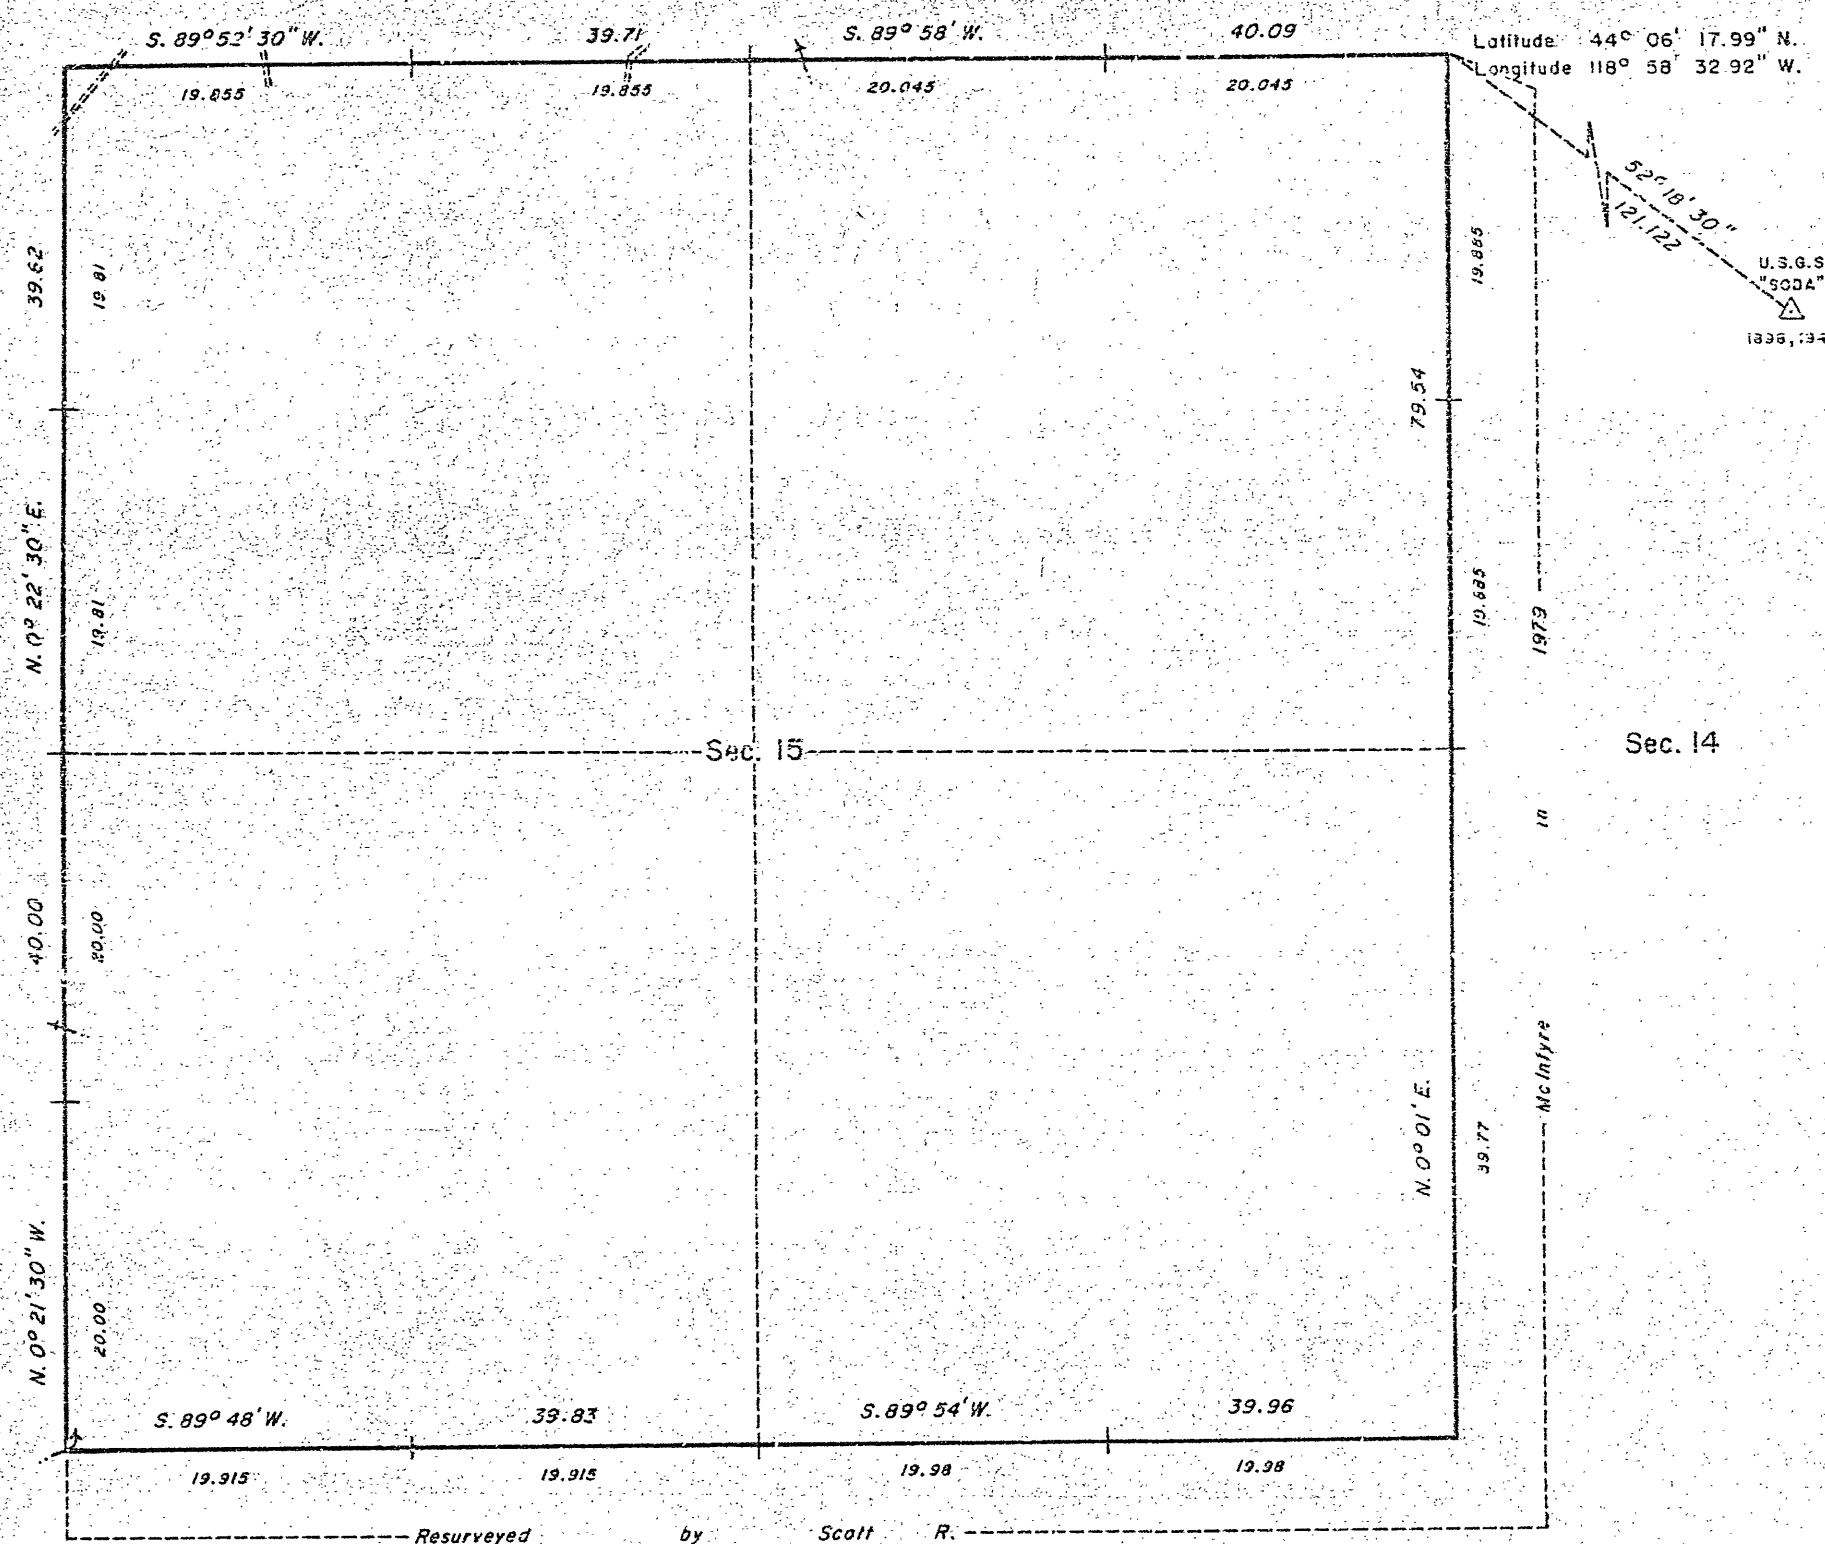

A history of surveys is contained in the field notes.

This plat represents a corrective dependent resurvey of a portion of the subdivisional lines, T. 17 S., R. 31 E., Willamette Meridian, Oregon, designed to restore the corners in their true original locations according to the best available evidence.

The lottings and areas are as shown on the plat approved November 5, 1881.

The survey was executed by Philip G. Griffin, Cadastral Surveyor, beginning July 9, 1986, and completed July 16, 1986, pursuant to Special Instructions dated July 8, 1986, under Group Number 1335, Oregon.

Timber in this area consists of pine, larch, and fir.

UNITED STATES DEPARTMENT OF THE INTERIOR
BUREAU OF LAND MANAGEMENT
Portland, Oregon July 31, 1987

This plat is strictly conformable to the approved field notes, and the survey, having been correctly executed in accordance with the requirements of law and the regulations of this Bureau, is hereby accepted.

For the Director

RECEIVED AND
FILED

SEP 10 1987

OFFICE OF COUNTY SURVEYOR
Attest *Michael R. King*

William W. Elson
Chief Cadastral Surveyor of Oregon

