


TOWNSHIP 17 SOUTH, RANGE 31 EAST, OF THE WILLAMETTE MERIDIAN, OREGON.

DEPENDENT RESURVEY

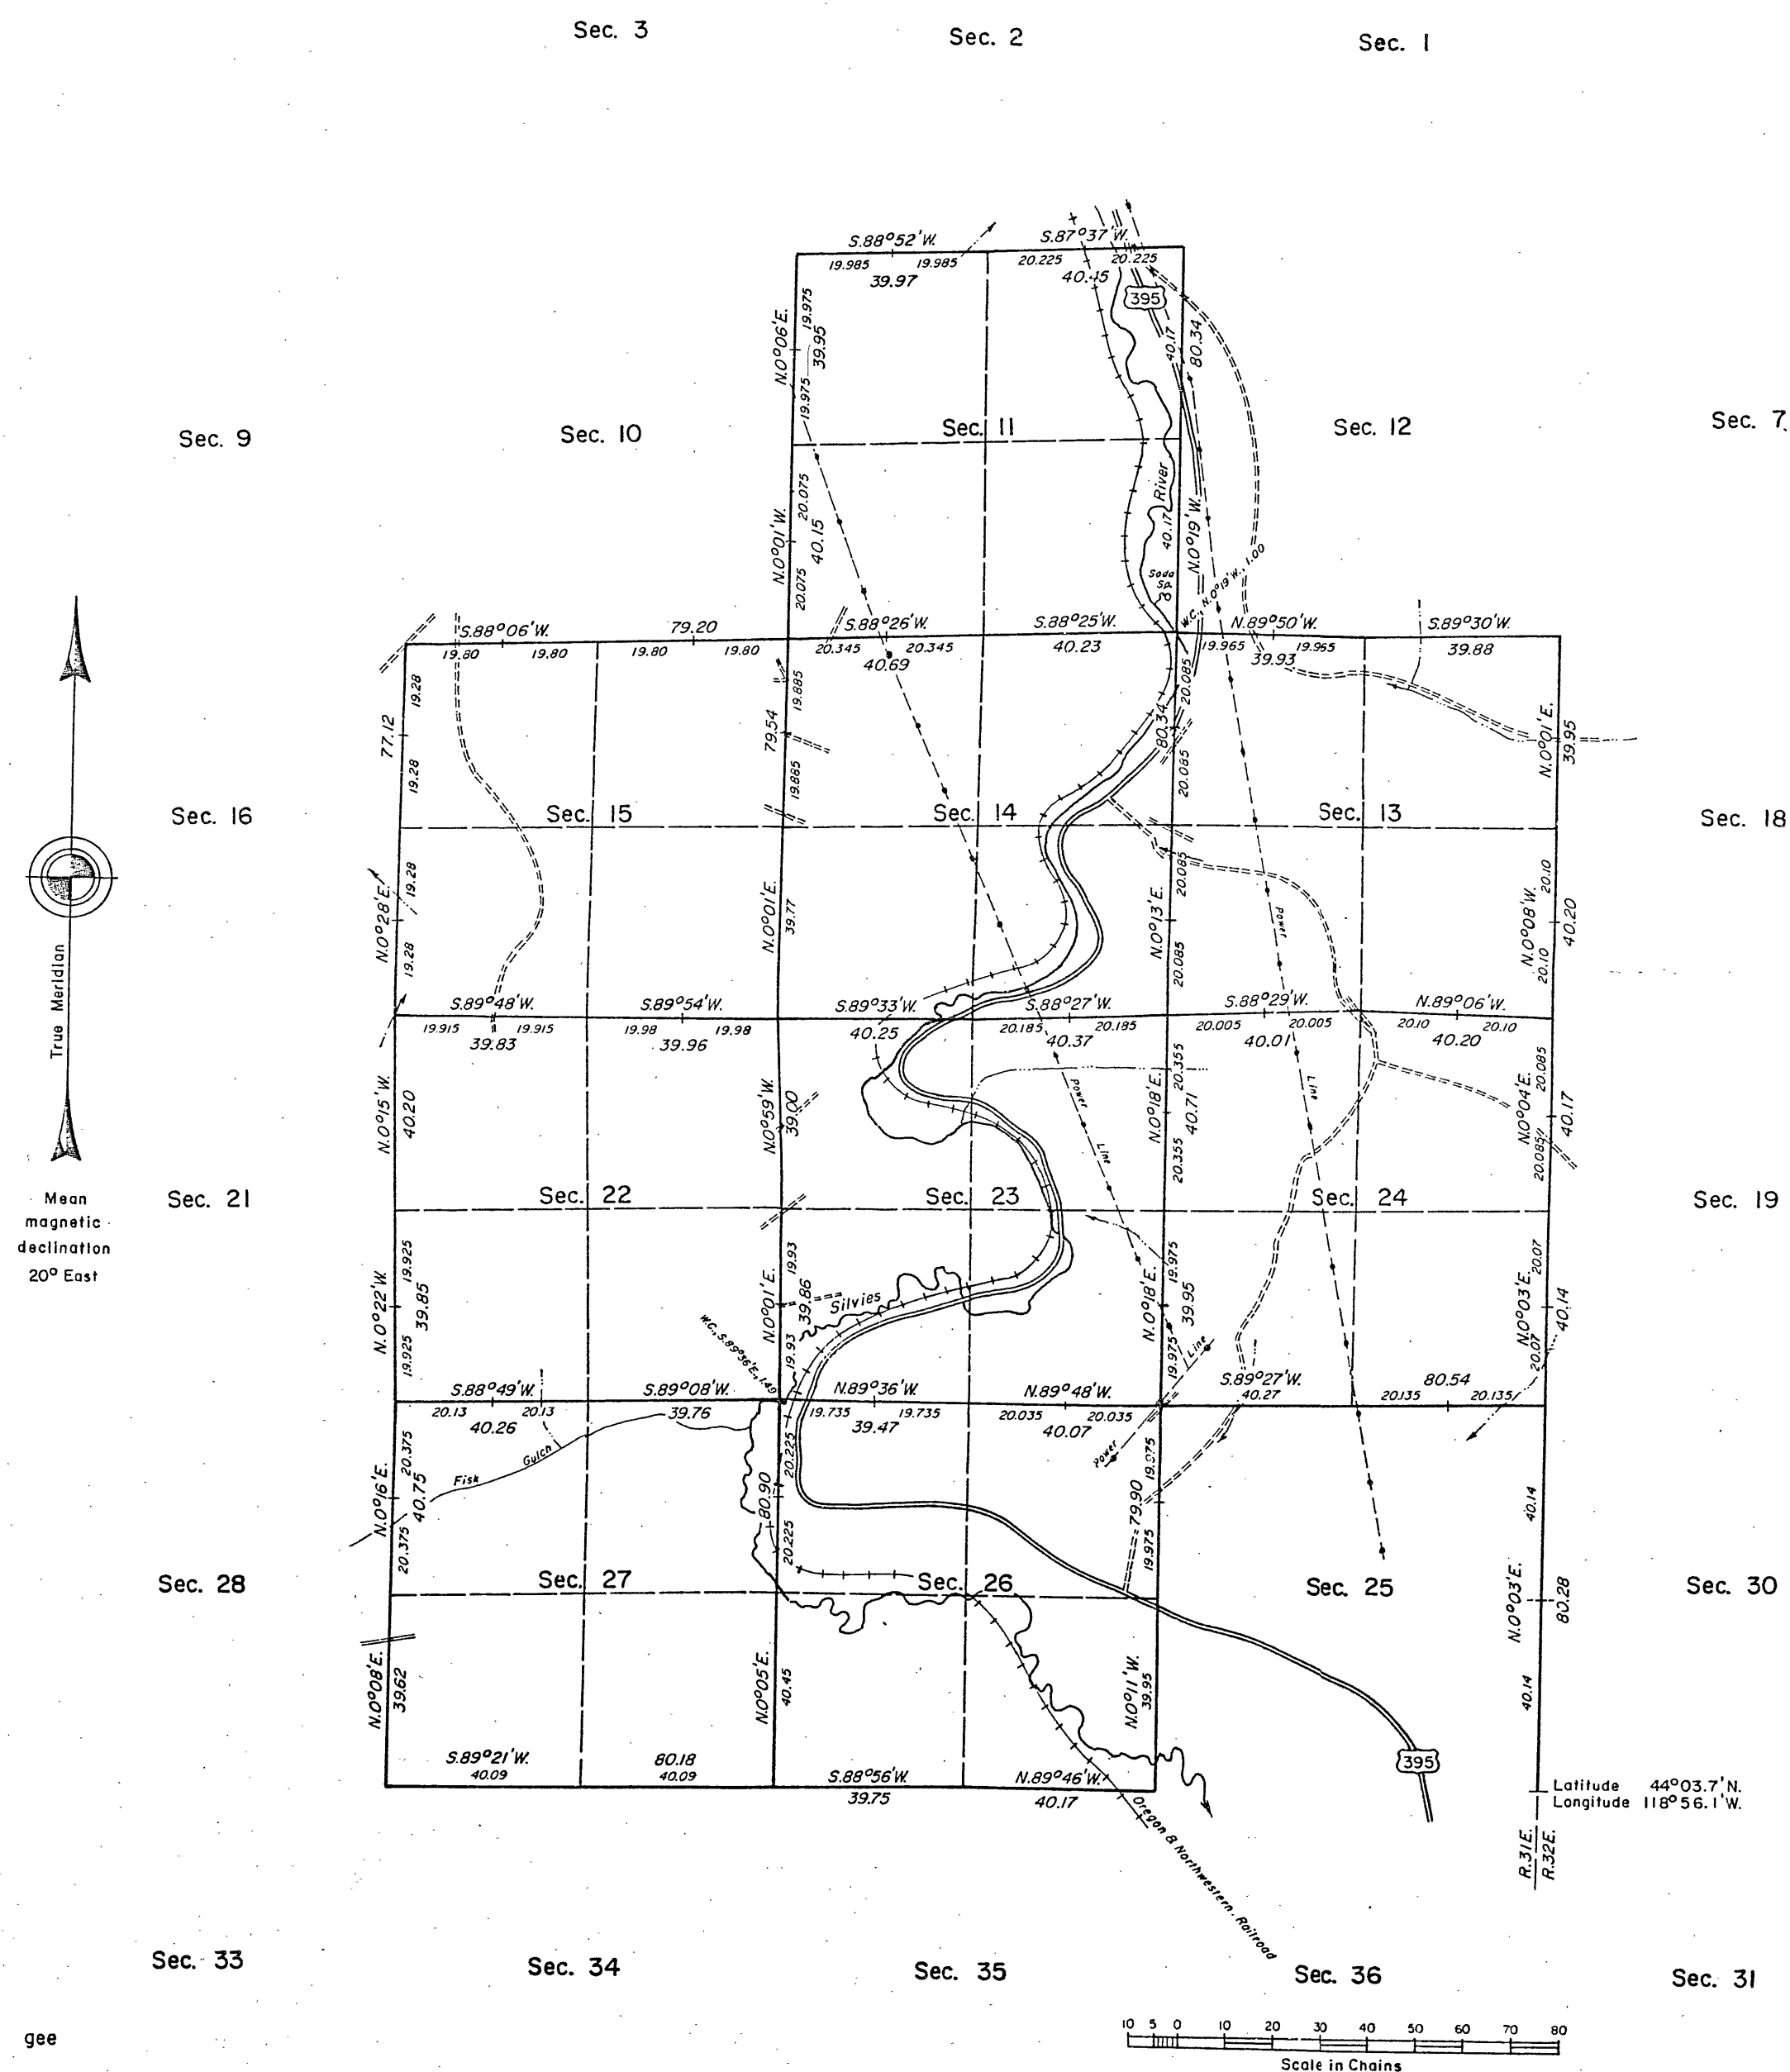

A history of surveys is contained in the field notes.

This plat represents a dependent resurvey of a portion of the east boundary and subdivisional lines, T. 17 S., R. 31 E., Willamette Meridian, Oregon, designed to restore the corners in their true original locations according to the best available evidence.

The lottings and areas are as shown on the plat approved November 5, 1881 and November 28, 1883.

The survey was executed by Scott R. McIntyre, Cadastral Surveyor, beginning May 21, 1979 and completed July 3, 1979, pursuant to Special Instructions for Group No. 982, Oregon, dated May 1, 1979.

Timber in this area consists of pine and fir.

UNITED STATES DEPARTMENT OF THE INTERIOR
BUREAU OF LAND MANAGEMENT
Portland, Oregon January 20, 1983

This plat is strictly conformable to the approved field notes, and the survey, having been correctly executed in accordance with the requirements of law and the regulations of this Bureau, is hereby accepted.

For the Director

William W. Glenn

Chief Cadastral Surveyor of Oregon

RECEIVED AND
FILED

FEB 17 1983

OFFICE OF COUNTY SURVEYOR

James E. Lawrence
Attest: *James E. Lawrence*

MAP OF SURVEY NO. 752

Sec. 752 A & 752 B