SURVEY FOR

U.S. FOREST SERVICE

GIMLET OLIVE CADASTRAL

CONTRACT NO. 53-04M3-2-2789


RETRACEMENT OF MINERAL SURVEY NO. 595

CARMI CLAIM, VAMOOSE CLAIM

ORO-FINO CLAIM, SPOKANE CLAIM

T9S R35E, W.M.

DECEMBER 30, 1982 GRANT COUNTY, OREGON

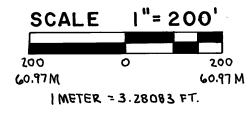



LEGEND

CORNER SET BY SURVEY

CORNER EVIDENCE FOUND

PROPERTY LINE POSTED WITH 6 FOOT STEEL POSTS AND U.S.F.S. DECALS 54-2,

BEARINGS AND DISTANCES OF RECORD BY JAMES HAMBLETON C.5. 480 AUGUST 1968.

BEARINGS AND DISTANCES OF RECORD FROM ORIGINAL GLO SURVEY.

NARRATIVE: THIS SURVEY IS A CLOSED TRAVERSE BY T-1A THEODOLITE AND 300 FT. TAPE, AND T-16 THEODOLITE AND D1-4 EDM, MADE BY JACKSON AND PROCHNAU, INC. P.O. BOX 177 ALBANY, OREGON 97321. BASIS OF BEARINGS IS A SOLAR OBSERVATION. THE ORIGINAL SURVEY OF THE SUBDIVISIONAL LINES OF THE TOWNSHIP WAS MADE BY HERMAN GRADON IN 1884. MINERAL SURVEY NO. 595 WAS MADE BY FRANK STANLEY IN 1904 THROUGH THE U.S. SURVEYOR GENERAL'S OFFICE. CARMI CORNER No. 1, (COR NO D), WAS SET BY PROPORTIONAL MEASURE NO ORIGINAL EVIDENCE WAS FOUND FOLLOWING OUR THOROUGH SEARCH, OR BY JAMES HAMBLETON IN 1968. THE MONUMENT SET IN 1968 BY HAMBLETON WAS DESTROYED BY LOGGING AND OUR MONUMENT DISAGREES SLIGHTLY WITH HAMBLETON'S 1968 B.T.S.

"I, JAMES W. PROCHNAU, A REGISTERED LAND SURVEROR IN THE STATE OF OREGON, HEREBY CERTIFY THAT THIS PLAT AND THE NOTES HEREON, OR ATTACHED, ARE A CORRECT REPRESENTATION OF A SURVEY I PERFORMED DURING JUNE THROUGH NOVEMBER, 1982 FOR THE U.S. FOREST SERVICE, IN ACCORDANCE WITH THE STATUTES OF THE STATE OF OREGON AND WITH THE ARTICLES OF MY CONTRACT,"


P.L.S. 1305, OREGON

REGISTERED
PROFESSIONAL
LAND SURVEYOR

Lonn W. Frohm

OREGON
SEPTEMBER 23, 1977

JAMES W. PROCHNAU
1305

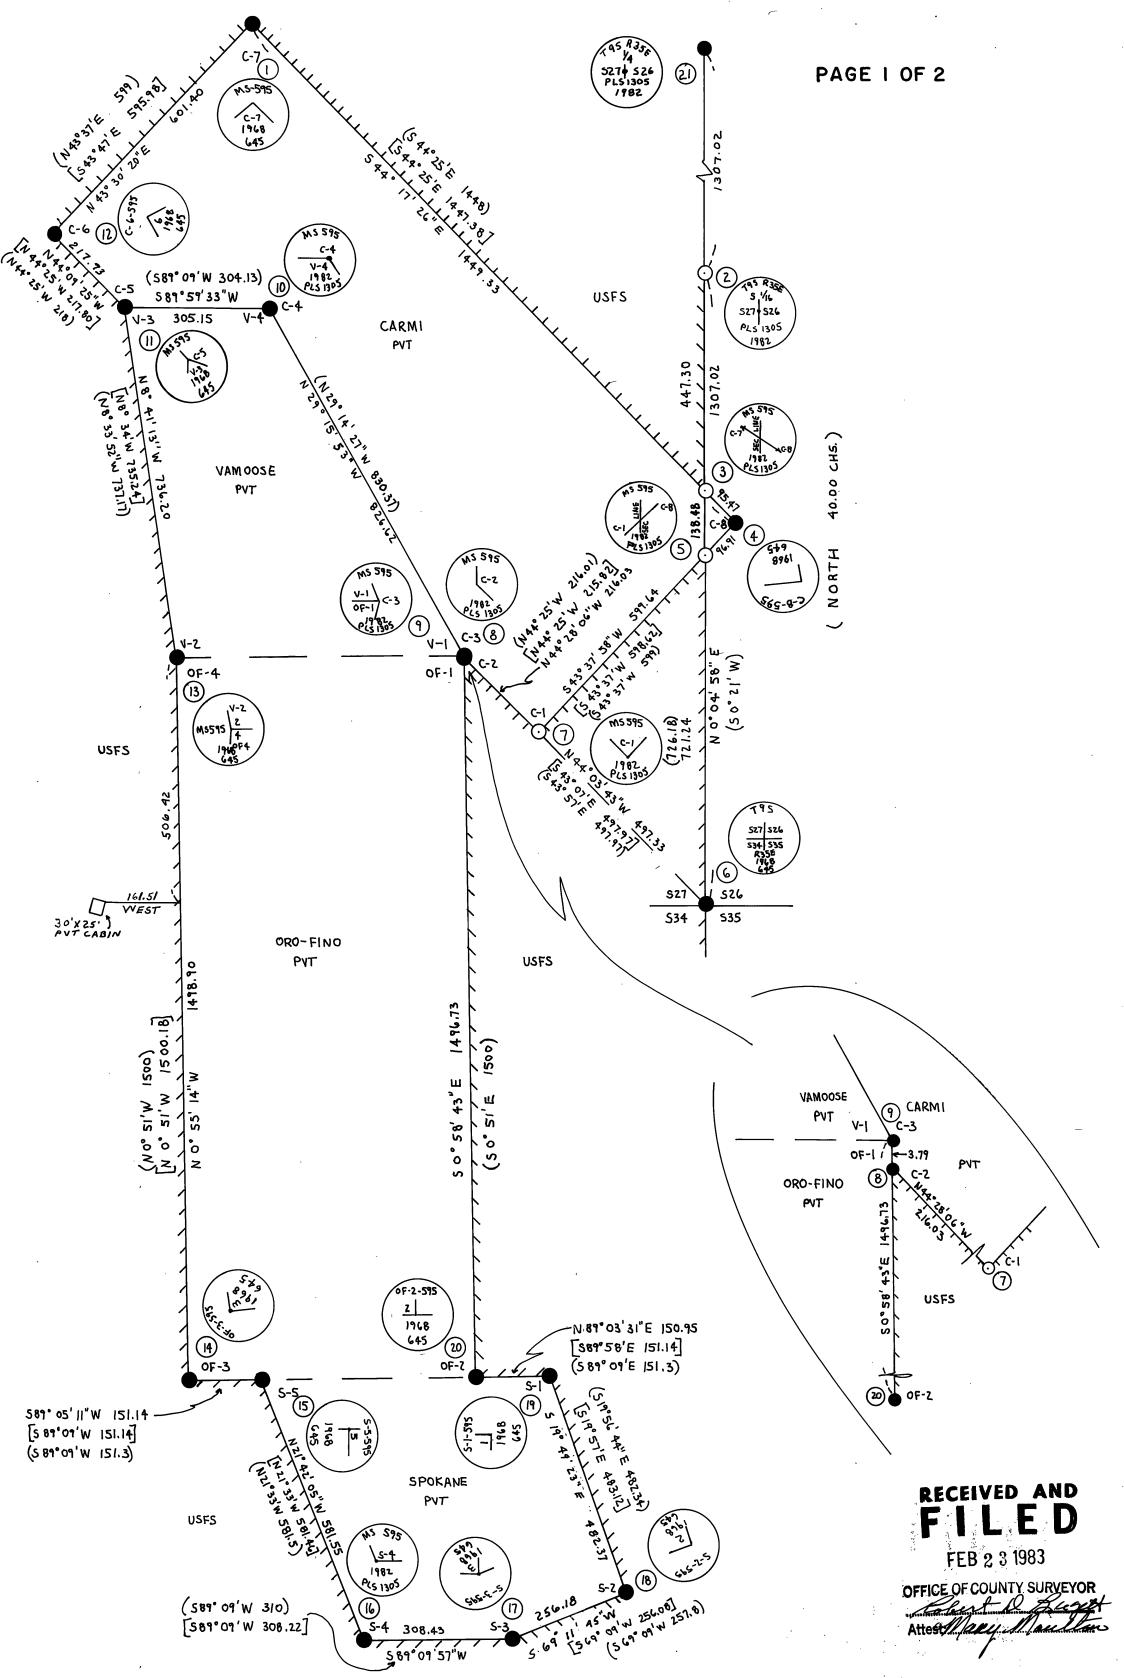

MAP OF ELIDVEY NO. 158