

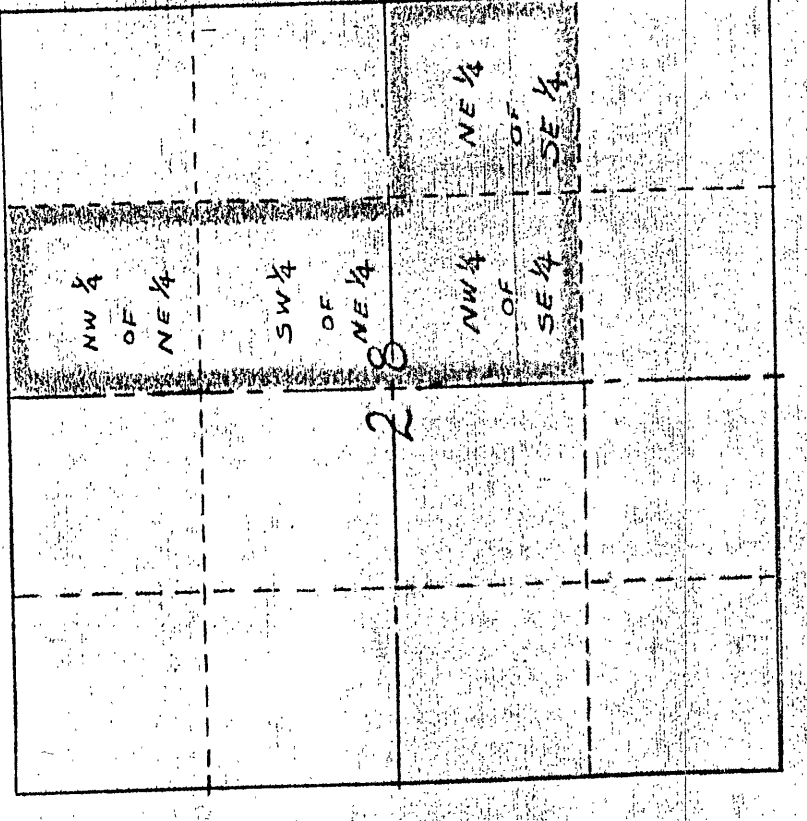


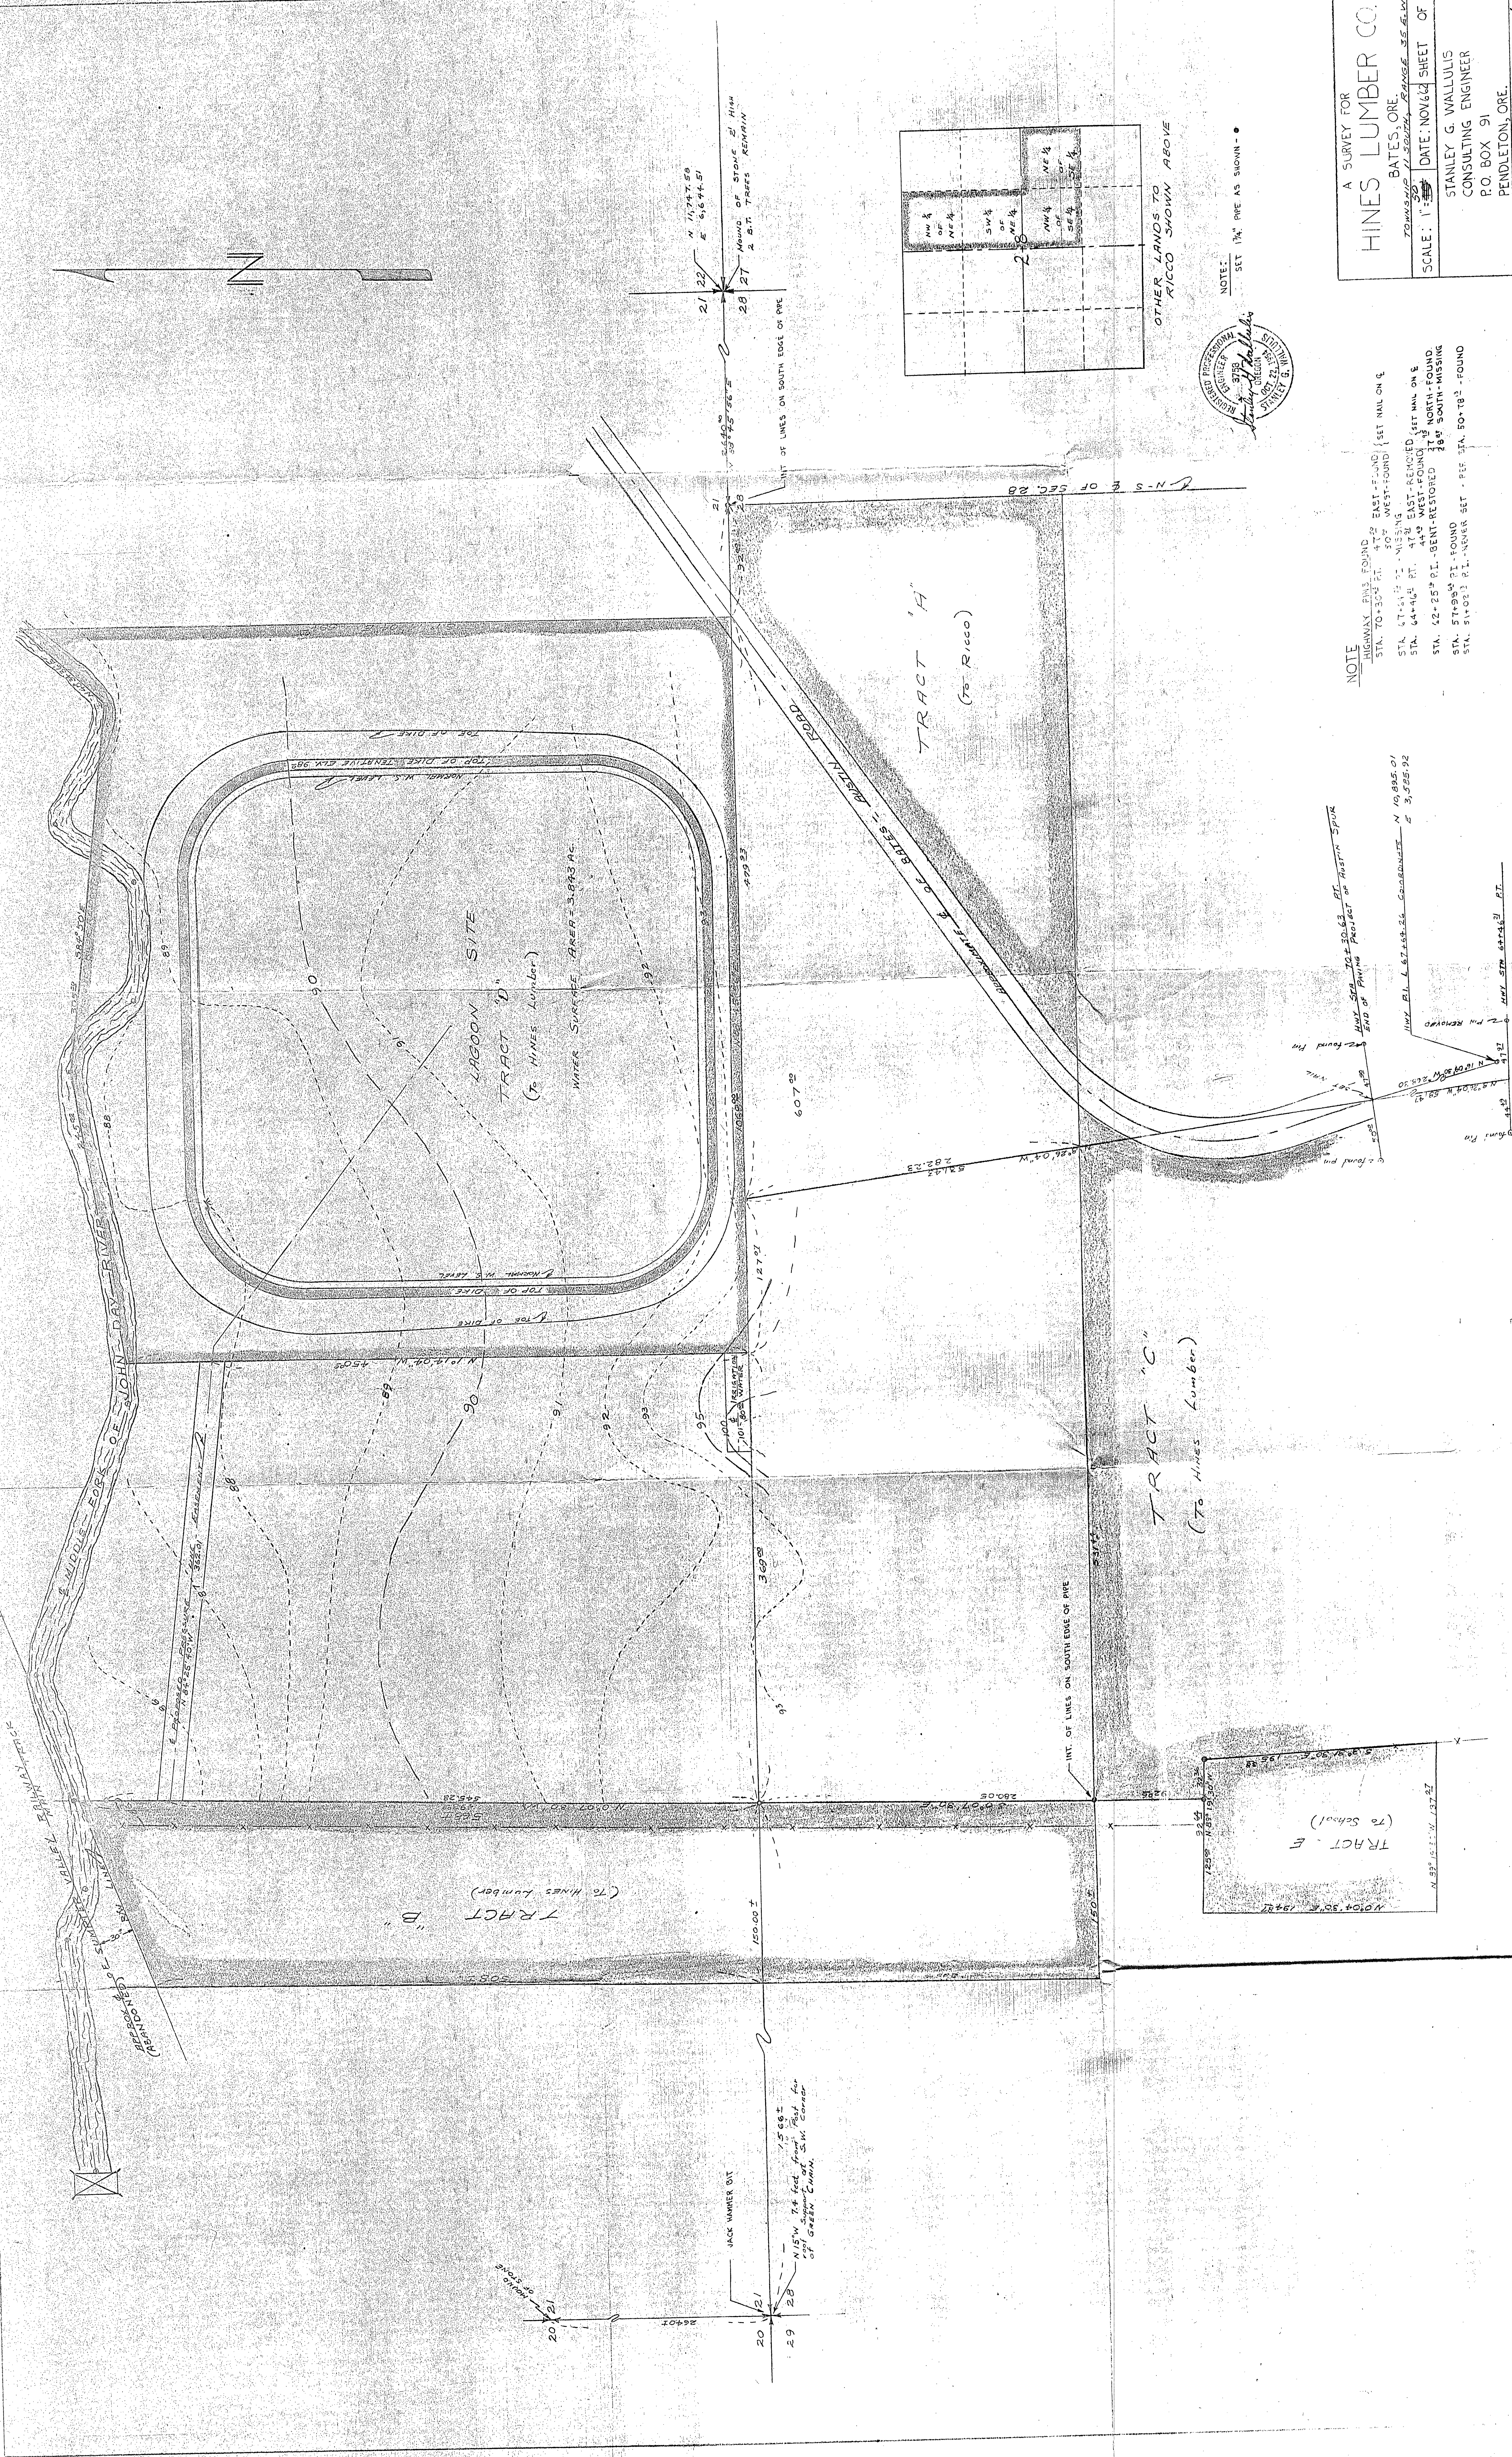

OTHER LANDS TO
RICCO SHOWN ABOVE

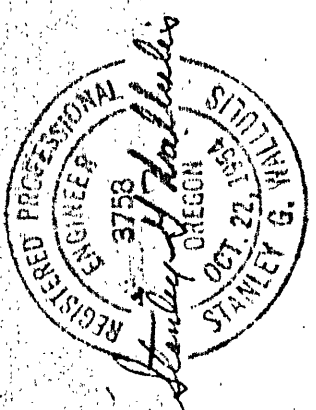

NOTE
HIGHWAY FIND FOUND EAST 2-ND (SET MAIL ON E)
STA. 70+304 FT. 45° WEST-FOUND
STA. 47+51.72 - MISSING
STA. 64+41.41 FT. 47° EAST-REMOVED SET MAIL ON E
STA. 44° WEST-FOUND
STA. 42-25° PL. - GENT-RESTORED 28° SOUTH-MISSING
STA. 57+59.41 FT. - FOUND
STA. 51+02.31 FT. - NEVER SET - SEE STA. 50+18.3 - FOUND

END OF PINE
Hwy. Sta. 20+30.63 OF Austin Spur
Hwy. Pl. L. 67+48.24 CORNER N 10,832.01
E 3,222.92
Hwy. Sta. 67+48.24

TRACT - E
(To School)
N 0° 0' 30" E 19+21
N 85° 15' 11" W 127.92

TRACT - B
(To Hines Lumber)
N 10° 10' 00" E 150.00
N 85° 15' 11" W 127.92




