
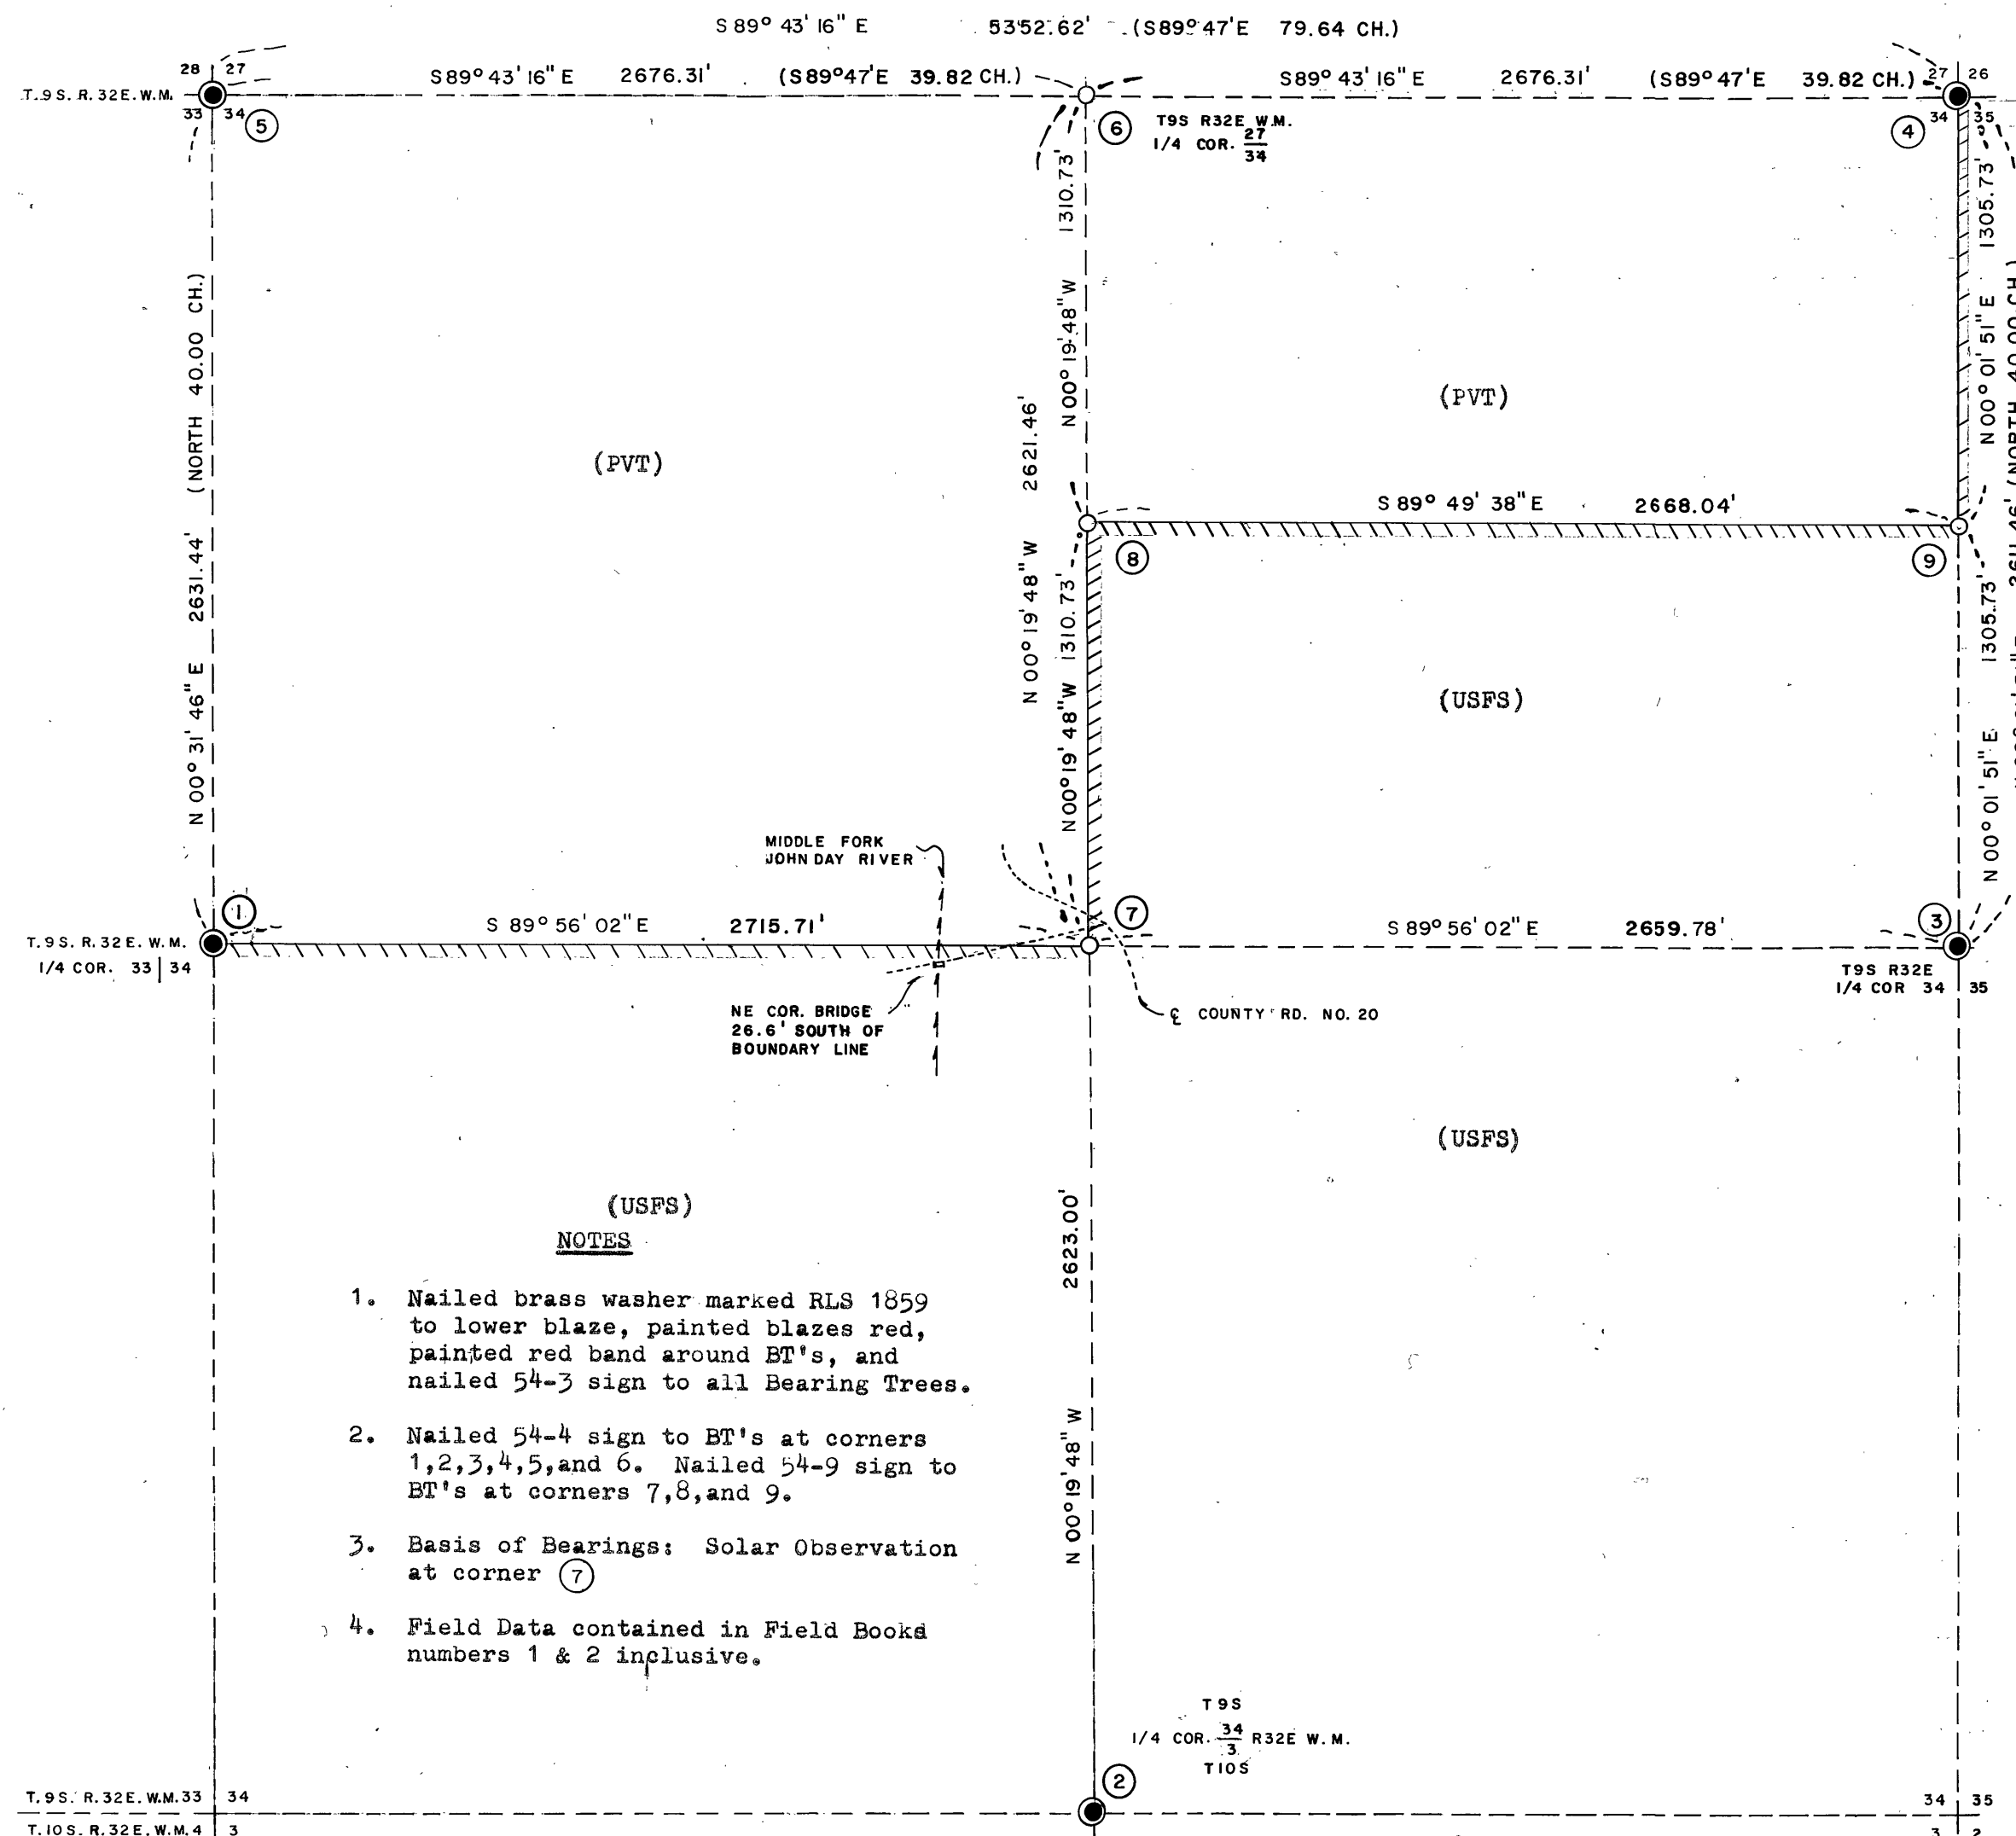
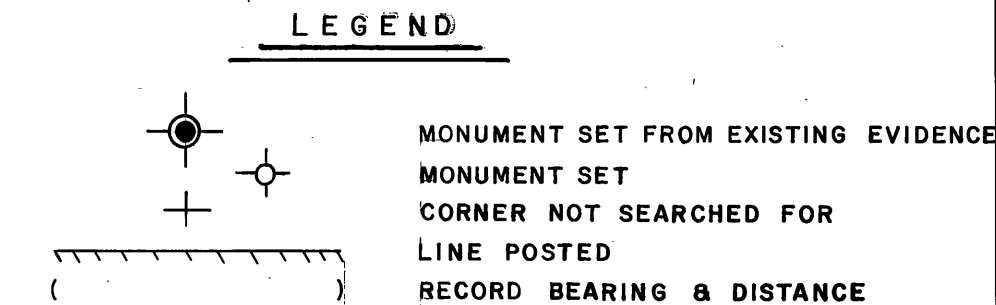


RECORD OF SURVEY
FOR THE U.S. FOREST SERVICE
SECTION 34, T9S., R.32E., W.M.
GRANT COUNTY, OREGON
MARCH 1983

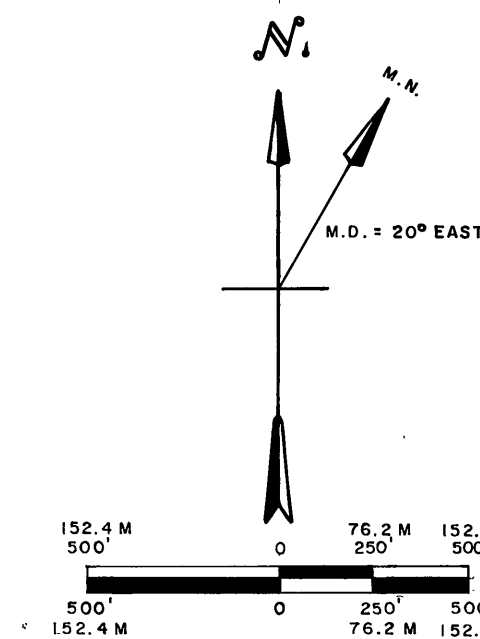


- 1/4 Corner Section 33 / 34
Fd. no evidence of original stone.
Fd. a stone (possibly Udeill's) in mnd. of stone N80°W 0.8 ft. of true position.
BT's Fd.:
33" Pine snag N65°W 14.5 ft., open blaze
mrk'd 1/4 (original), lower blaze open mrk'd
US BT (not original)
Set from original BT's 2 1/2"X30" Al. pipe / 3" Al. cap 4" A.R.Mnd. 12"Highx24"x36", (buried stone next to mon.) mrk'd
New BT's:
13" Fir N33°E 35.4 ft. mrk'd 1/4 S34 BT
9" Fir S35°30'W 55.3 ft. mrk'd 1/4 S33 BT
- 1/4 Corner section 34 / 35
Fd. no evidence of original post.
Fd. stone (as per D.I.G.) East 30.0 ft. (disturbed) of true position.
BT's Fd.:
30" Fir (D&D) S38°E 43.6 ft. open blaze
mrk'd 1/4 (original)
Rotted stump (flush/grd.) N65°E 24.4 ft.
10" Fir S62°W 26.0 ft. healed blaze (d.n.o.)
24" Fir N32°W 28.5 ft. part healed blaze (d.n.o.)
Set from Original BT's 2 1/2"X30"Al. pipe / 3" Al. cap 2" A.R.Mnd. 12" highx14"x28" (buried stone next to mon.) mrk'd
New BT's: none
- 1/4 Corner, Section 34 / 35
Fd. no evidence of original stone.
BT's Fd.:
36" Fir East 47.5 ft. open blaze (no mrkings)
32" stump (1' tall & burned out) N28°W 25.1 ft.
Set from original BT's 2 1/2"X30"Al. pipe / 3" Al. cap 2" abv. rck. mnd. 14"x36"x36" mrk'd
New BT's:
13" Pine N65°W 23.3 ft. mrk'd 1/4 S34 BT
- NE Corner Section 34
Fd original stone 22"x8"x6" mrk'd one notch on south edge, none fd. on east edge.
Fd. 1/2" iron pipe next to stone, both in mnd.
BT's Fd.:
20" pine stump (uprooted) S63°W 116.2 ft. open blaze markings illegible, severed from stump.
Rotted stump (flush/grd.) S17°E 34.7 ft.
Set @ fd. stone, 2 1/2"X30"Al. pipe / 3" cap 2" abv. rck. mnd. 6"x24"x36" (buried stone) mrk'd
New BT's:
8" Pine S56°W 55.0 ft. mrk'd T9S R32E S34 BT
9" Pine N29°W 29.0 ft. mrk'd T9S R32E S27 BT
13" Pine S32°E 213.1 ft. mrk'd T9S R32E S35 BT
- NW Corner Section 34
Fd. original stone 15"x7"x6" (disturbed) N41°E 17.0 ft. of true pos, mrk'd three notches on east edge, none fd. on south edge, in rck mnd.
BT's Fd.:
Rotted stump N40°W 36.5 ft.
Rotted stump S65°W 69.3 ft.
Root hole 60"x12" deep N65°E 46.9 ft.
Old rd. South 165.0 ft. (per orig. topo calls)
Old rd. North 27.1 ft. & West 142.6 ft. (same)
Set from orig. BT's 2 1/2"X30"Al. pipe / 3" cap 6" abv. grd. mrk'd
New BT's:
8" Pine S68°W 67.2 ft. mrk'd T9S R32E S33 BT
12" Pine N18°W 41.4 ft. mrk'd T9S R32E S28 BT
10" Pine S38°E 12.6 ft. mrk'd T9S R32E S34 BT
10" Pine N34°E 42.5 ft. mrk'd T9S R32E S27 BT

- 1/4 Corner Sections 27 / 34
Fd. no evidence of original stone.
Fd. no evidence of original BT
Set by single proportionate measurement between the NW 1/4 & NE 1/4 corners of Sec. 34
2 1/2"X30" Al. pipe / 3" Al. cap 2" abv. rck. mnd. 16"x60"x42" mrk'd
New BT's:
17" pine N87°E 22.9 ft. mrk'd 1/4 S27 BT
16" pine S36°E 37.1 ft. mrk'd 1/4 S34 BT
- Center 1/4 Corner Section 34
Set using standard section breakdown procedures 2 1/2"X30" Al. pipe / 3" Al. cap 7" abv. grd. mrk'd
New BT's:
2 1/2" Al. pipe / 3" Al. cap 3" abv. rck. mnd North (on true line) 50.0 ft. mrk'd
2 1/2" Al. pipe / 3" Al. cap 7" abv. grd. West (on true line) 66.0 ft. mrk'd
- Center N/16 Corner Section 34
Set using standard section breakdown procedures 2 1/2"X30" Al. pipe / 3" Al. cap 2" abv. rck. mnd. 6"x24"x24" mrk'd
New BT's:
12" pine N40°E 9.2 ft. mrk'd CN/16 S34 BT
9" pine S63°W 7.1 ft. mrk'd CN/16 S34 BT
- N/16 Corner Section 34 / 35
Fd. 1/2" iron pipe S84°E 15.0 ft. of true corner position.
BT's Fd.:
13" pine SW of iron pipe (location tag att)
Set by single proportionate measurement between the E 1/4 & NW corners of Sec. 34
2 1/2"X30" Al. pipe / 3" Al. cap 6" abv. grd. mrk'd
New BT's:
12" pine S85°W 47.4 ft. mrk'd N/16 S34 BT
12" fir N23°E 8.1 ft. mrk'd N/16 S35 BT

CERTIFICATION

I, William H. Weaver, a registered land surveyor in the State of Oregon, hereby certify that this plat and the notes hereon, or attached, are a correct representation of a survey made by me or under my direction during March 1983, for the U.S. Forest Service, in accordance with the statutes of the State of Oregon and with the Articles of my contract.

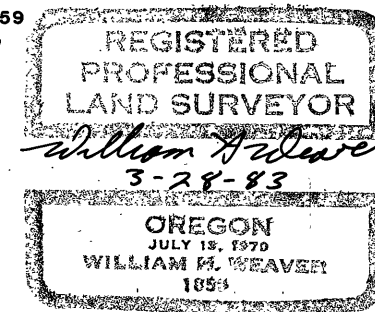

RECEIVED AND
FILED

APR 28 1983

OFFICE OF COUNTY SURVEYOR

Attest: _____

W.H. WEAVER & ASSOCIATES

503-889-6369

P.O. BOX "C" ONTARIO, OREGON 97914

PROJECT REFERENCE
NO. 8302-005-OS

DATE
3/23/83

NARRATIVE: This survey was made for the USDA-Forest Service pursuant to the conditions and specifications of Contract # 53-04KK-3-01083 for "Middle Fork Cadastral Project" and the BLM Manual. Controlling corners required for the survey and subdivision of Section 34 were either found or established from evidence or survey as indicated on this plat. All monuments and accessories established or found are shown. The original subdivision of T9S, R32E, Willamette Meridian was done in 1881 by Herman D. Graden.