


RECEIVED AND
FILED

JUN 1 1983

OFFICE OF COUNTY SURVEYOR


Attest: *[Signature]*

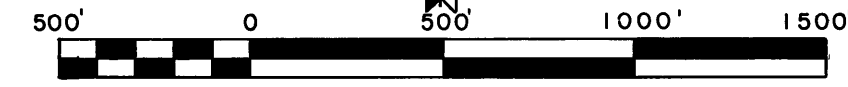

SCALE: 1" = 500'

BASIS OF BEARING

NORTH LINE, N.E. 1/4 SEC.
29, AS SHOWN ON MAP OF
SURVEY NO. 398.

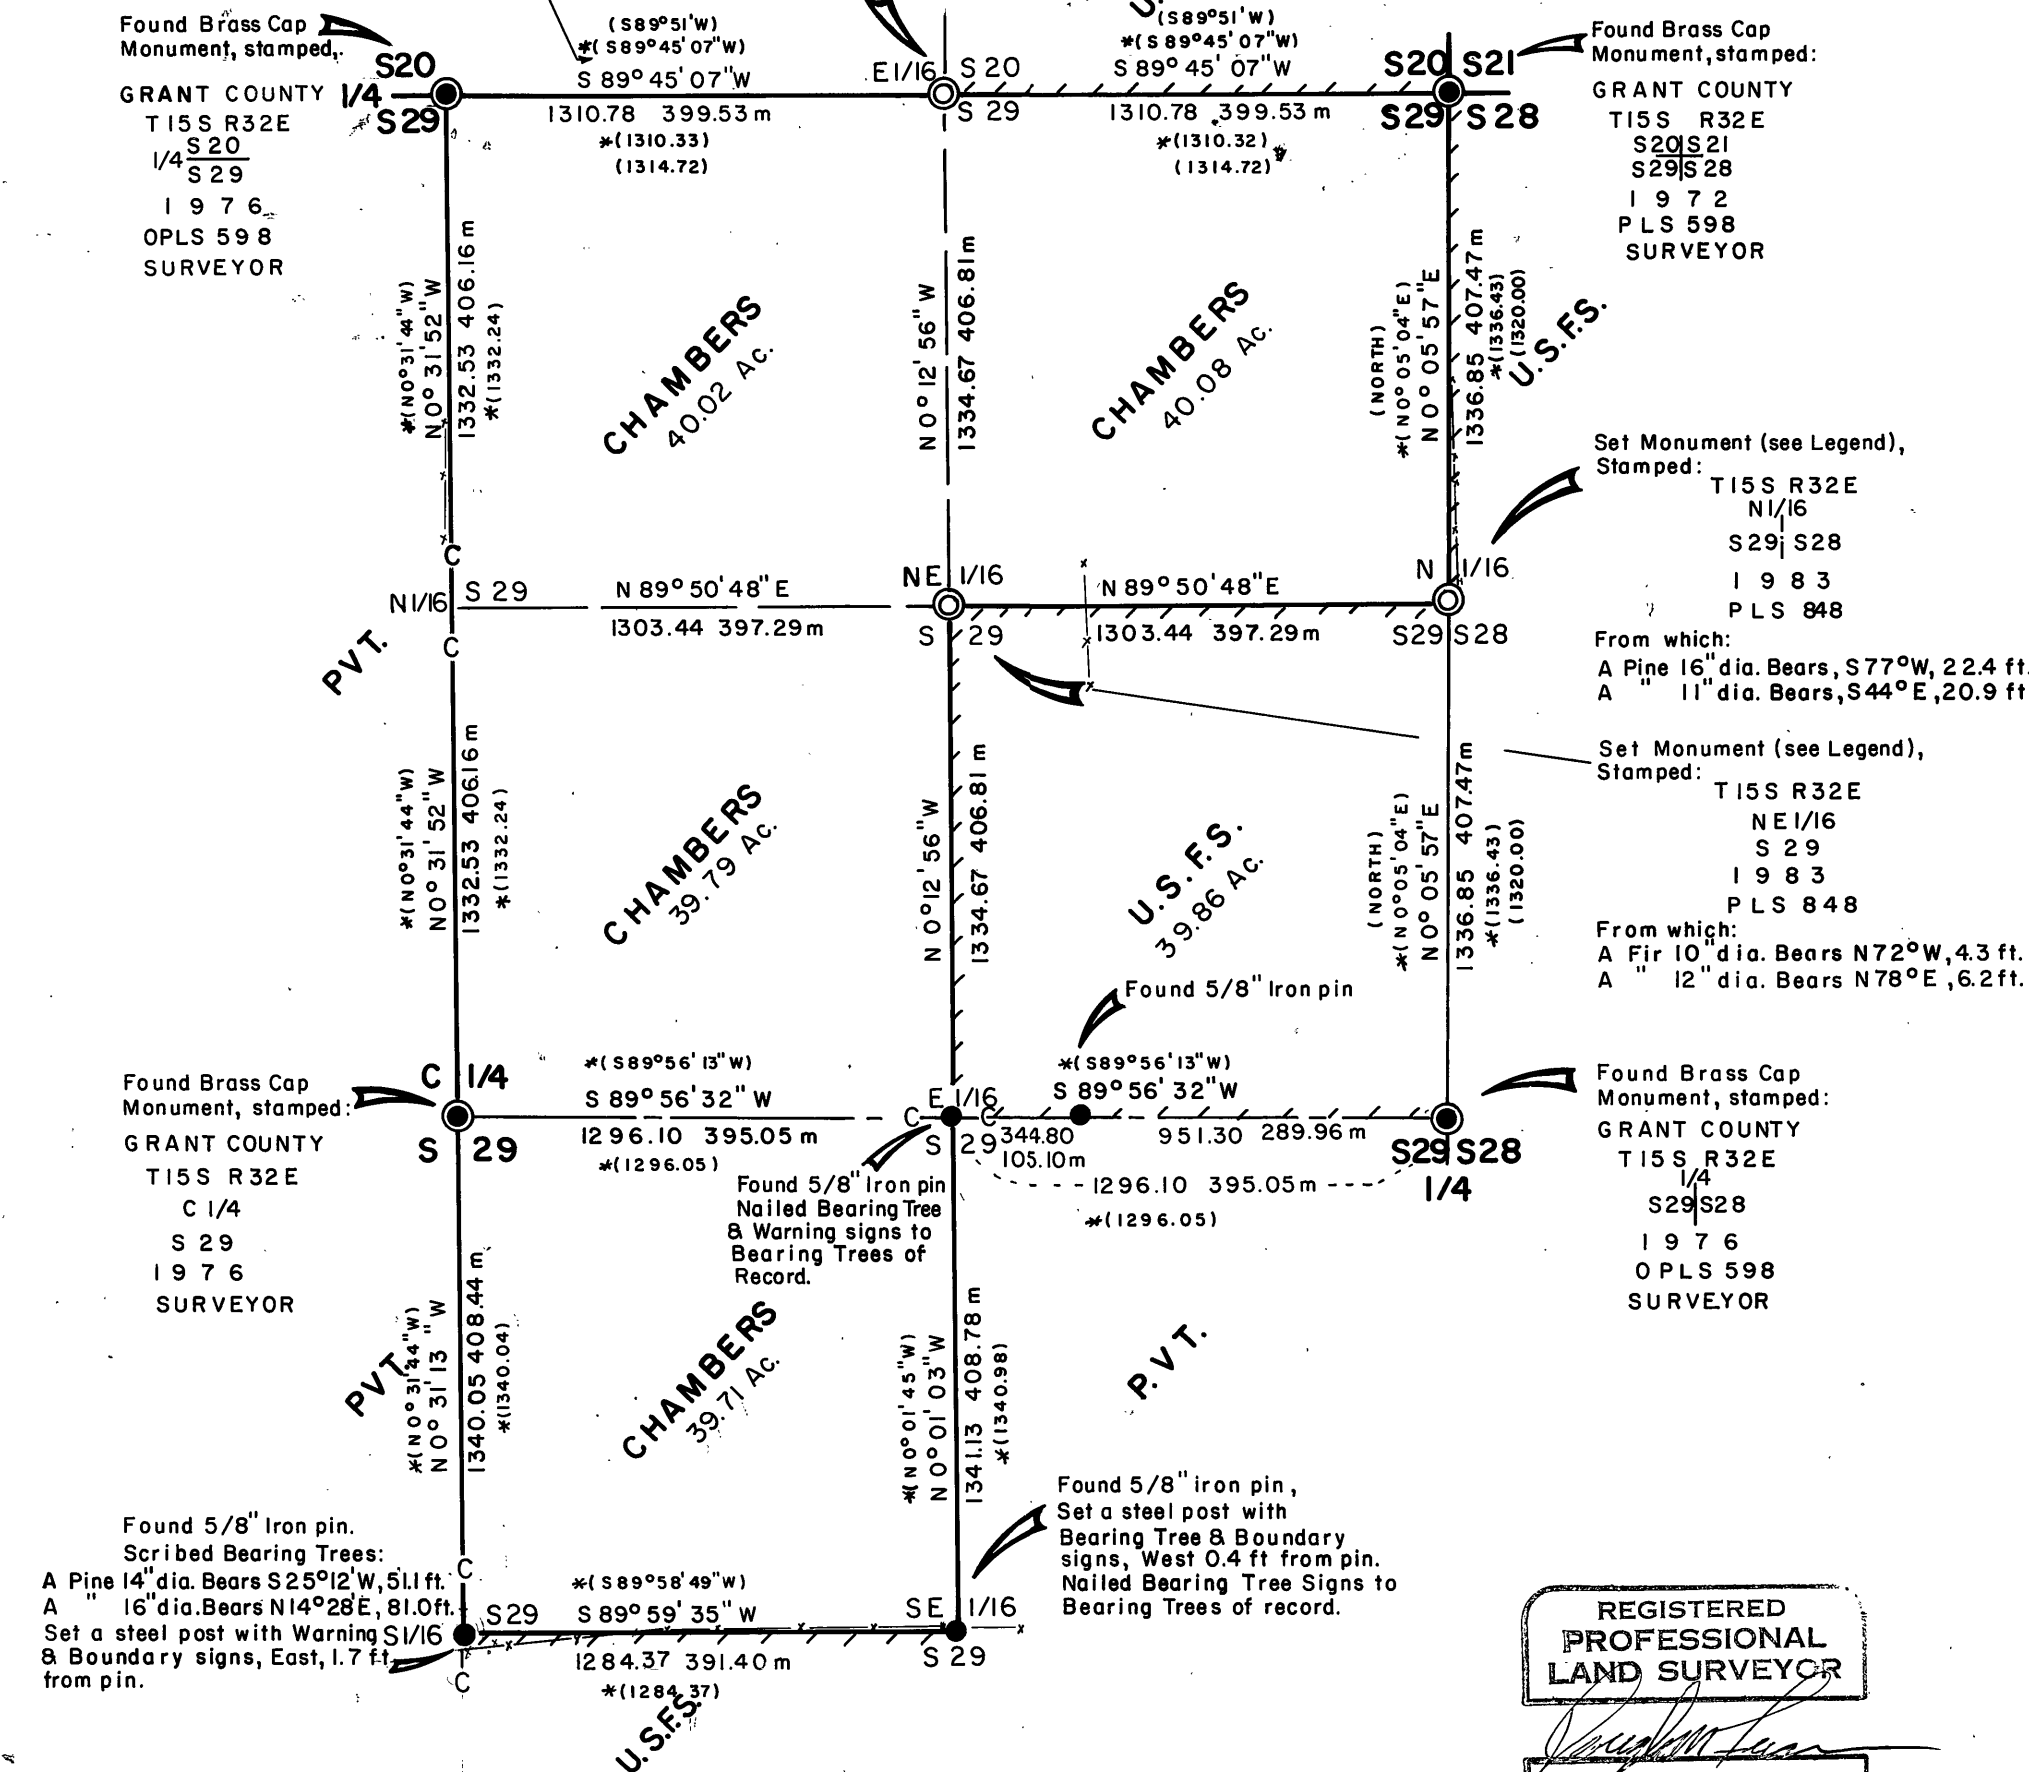

NARRATIVE

The purpose of this survey is the location of the Pat Chambers property & the accurate delineation of the property lines on the ground. The Malheur National Forest participated in the marking of the common boundary & the marking of the South line of the SE 1/4 of the NE 1/4 of this Sec. 29. All needed controlling corners are found, as re-monumented or established in 1976, by P.L.S. No. 598, as shown on map of survey No. 398, as on file in the office of the Grant County Surveyor. Based on the location of those corners, the necessary 1/16 th. corners are established & the corners are marked on the ground. Some repair work to corners established by P.L.S. 598 is accomplished as noted on the map, above.

LEGEND

- Found Brass Cap Monument of record
- Found 5/8" Iron Pin of record
- Set 30"x2" aluminum pipe with 3-1/2" aluminum cap, Scribed Bearing Trees in accordance with B.L.M. Manual (1973). Nailed brass washers, stamped PLS 848 & Bearing Tree signs to all trees scribed.
- Boundary, Malheur National Forest, marked with Steel Posts & Boundary signs driven near the cor. & at max. 200 intervals between corners.
- Property line marked by painted, red blazes on Trees which are intervisible.
- Record Bearing or Distance from Map of Survey No. 398.
- Record Bearing or Distance from original G.L.O. Survey of 1881.

REGISTERED
PROFESSIONAL
LAND SURVEYOR

OREGON
JULY 12, 1968
DOUGLAS M. FERGUSON
848

FERGUSON SURVEYING & ENGINEERING

MT. VERNON, OR.

MAP OF SURVEY

IN SEC. 29, T.15S., R.32E., W.M., LOCATING & MARKING OF THE EXTERIOR BOUNDARIES OF THE N 1/2 OF THE NE 1/4, THE SW 1/4 OF THE NE 1/4 & THE NW 1/4 OF THE SE 1/4, FOR PAT CHAMBERS AND THE SE 1/4 OF THE NE 1/4 FOR THE MALHEUR NATIONAL FOREST

GRANT COUNTY OREGON

FOR: PAT CHAMBERS & MALHEUR NATIONAL FOREST SHEET 1 OF 1

DATE: APRIL, 1983 BY Douglas M. Ferguson, D. Mitchell Ferguson & David Herburger

SCALE: 1" = 500' DRAWN BY: D.M. Ferguson