


# HENCOCK CADASTRAL SURVEY


SHEET 2 OF 2

T.12S.  
R.30E. 1/4 R.31E.  
S13 S18

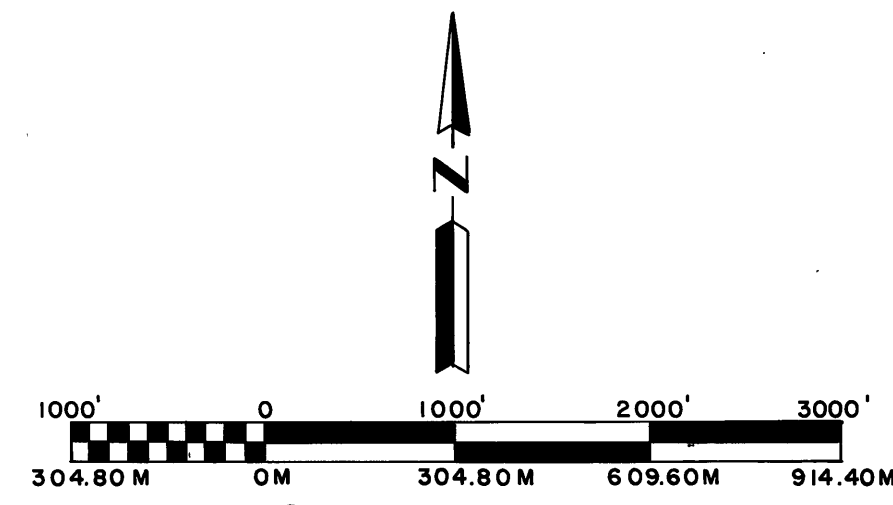

## BASIS OF BEARINGS

See Sheet 1 and see below "Re-Establishment of Township Line"

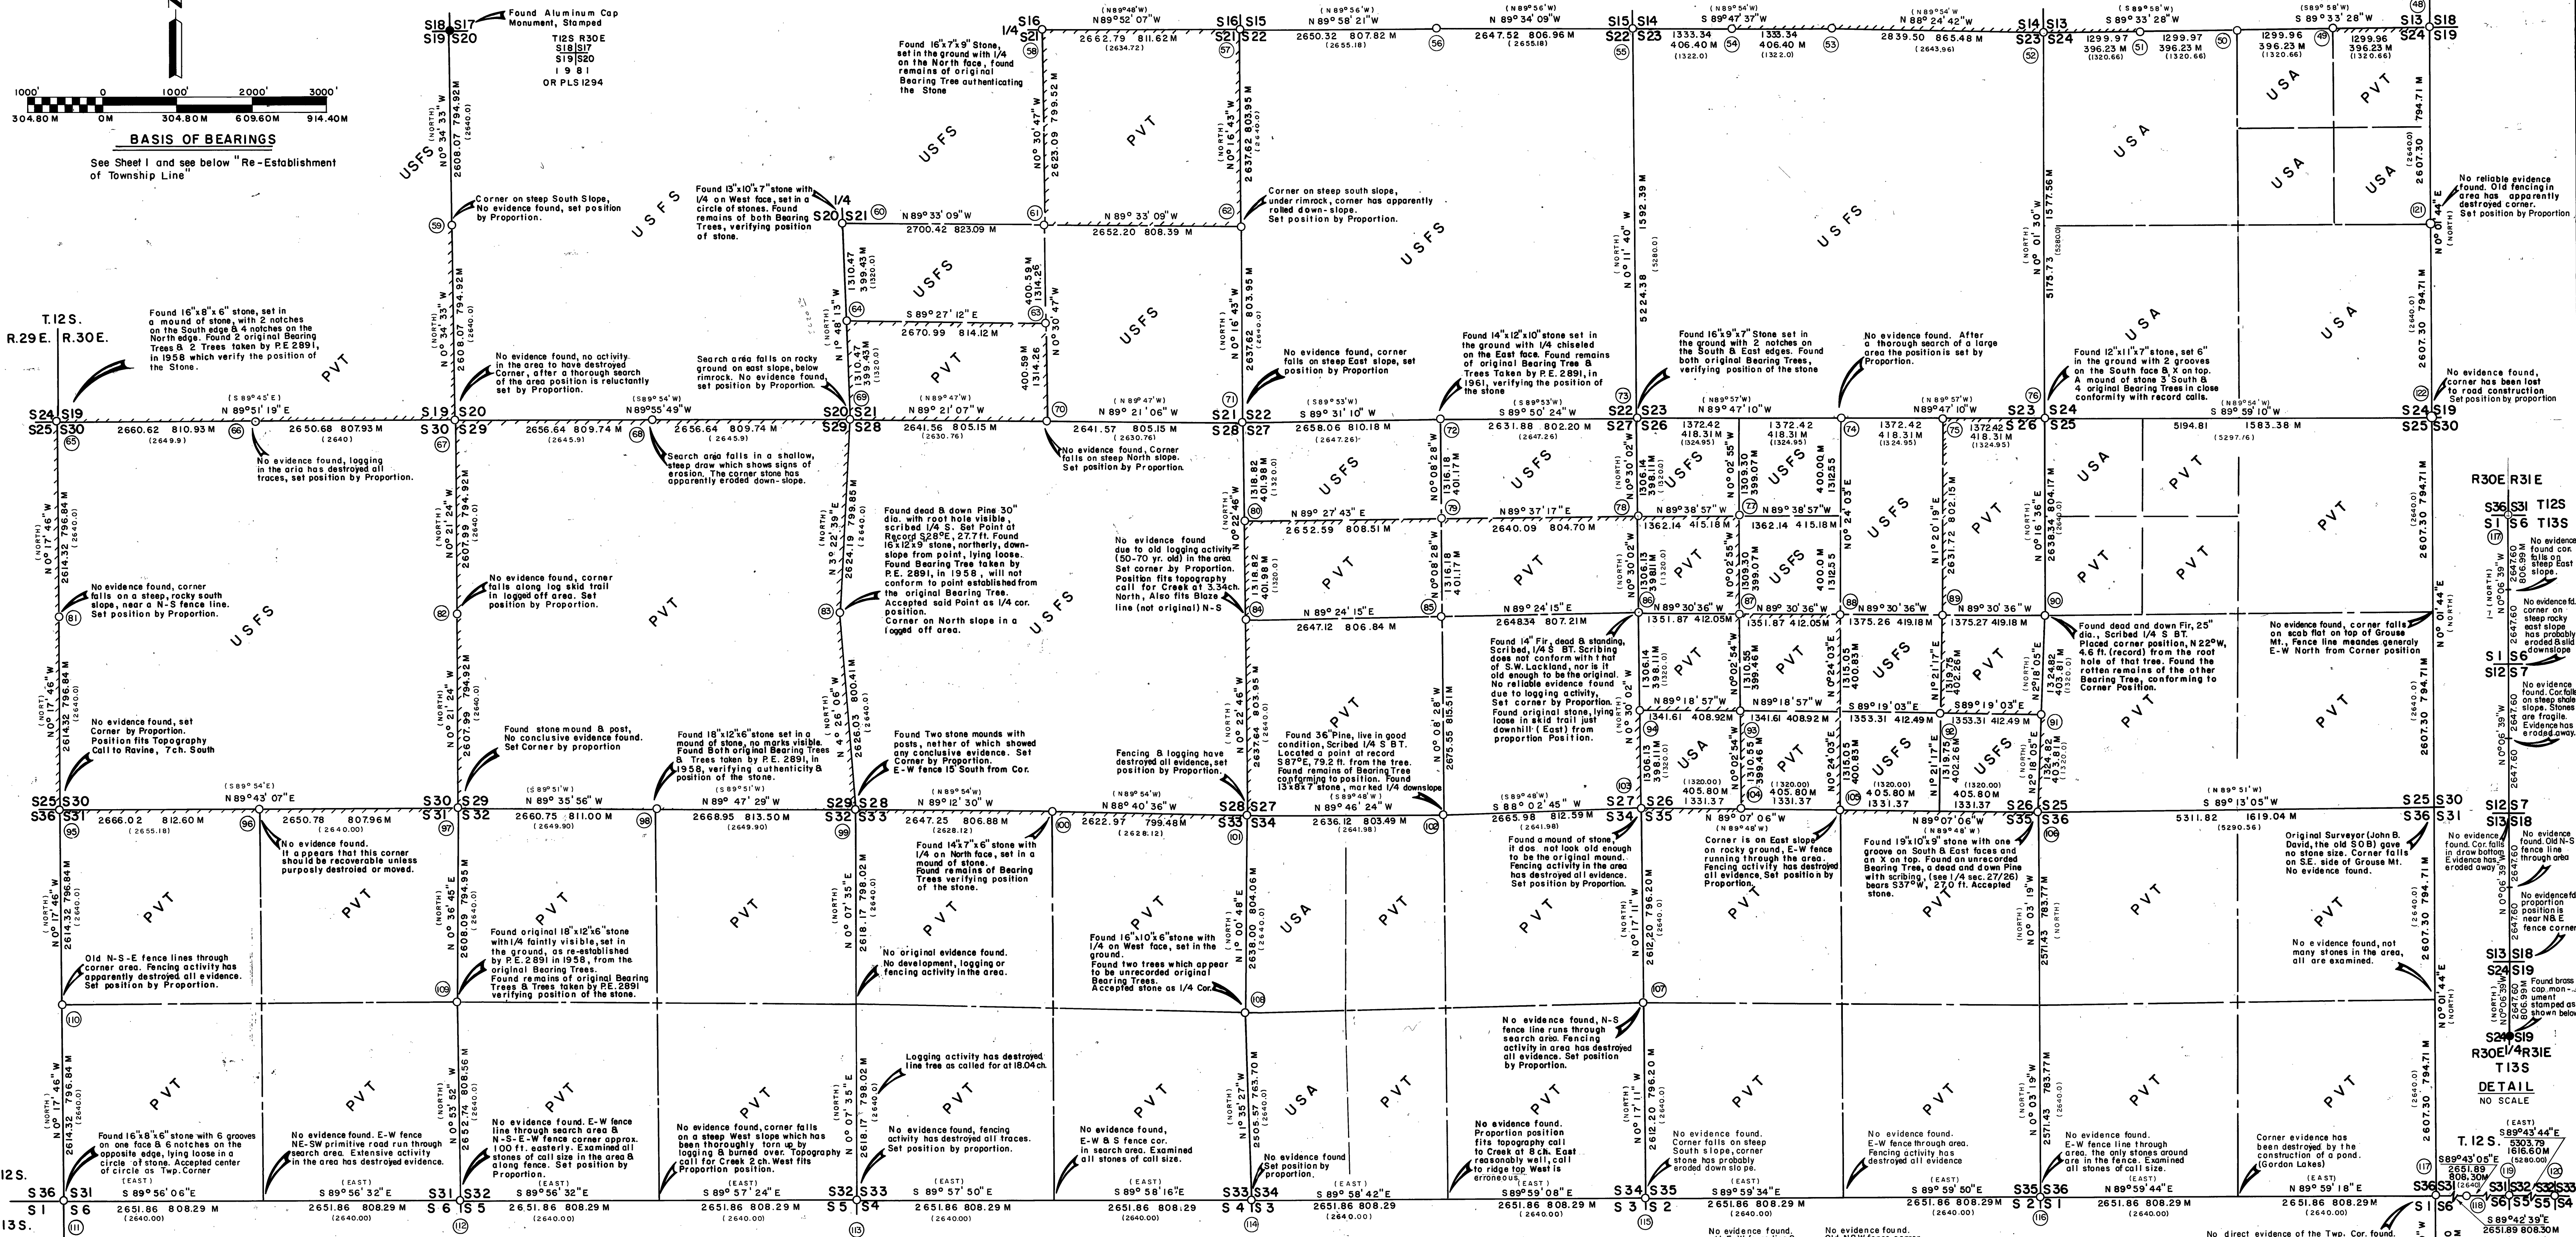

RECEIVED AND  
FILED

AUG 29 1983

OFFICE OF COUNTY SURVEYOR

Attest: *[Signature]*

## RE-ESTABLISHMENT OF TOWNSHIP LINE

Township Line is re-established from the Corner to T.12&13S., R.29&30E., running Easterly 8 miles to the Corner of Sections 32, 33, 4&5, T.12&13S., R.31E. Township line is run on the Latitudinal Curve. Bearings are on a local Grid, with True Bearing lying at the Corner of Sections 34, 35, 2&3, T.12&13S., R.30E. North Latitude at that Corner = 44° 28' 35" = 0° 00' 51" Convergancy of Meridian at North Lat. 44° 28' 35" = 0° 00' 51"

R.30E. R.31E.  
T12S S36 S31 S32 S33 S100  
T13S S1 S6 S11 S10901 S