


LEGEND

- National Forest Lands**
- All located in Township 12 South, Range 32 East of the Willamette Meridian:
- Section 24
 - Section 23
 - Section 22
 - Section 21
 - Section 20
 - The North half of Section 19
 - The North half of the South half of Section 19
- Found Grant County Surveyor brass cap
 - Found aluminum monument (see monumentation sheets filed separately)
 - ⊙ Found original G.L.O. corner evidence and set aluminum monument
 - ⊙ Set aluminum monument at proportionate position
 - () Original G.L.O. survey record bearing or distance
 - Posted National Forest Boundary line
 - SFNF Corner searched for, not found

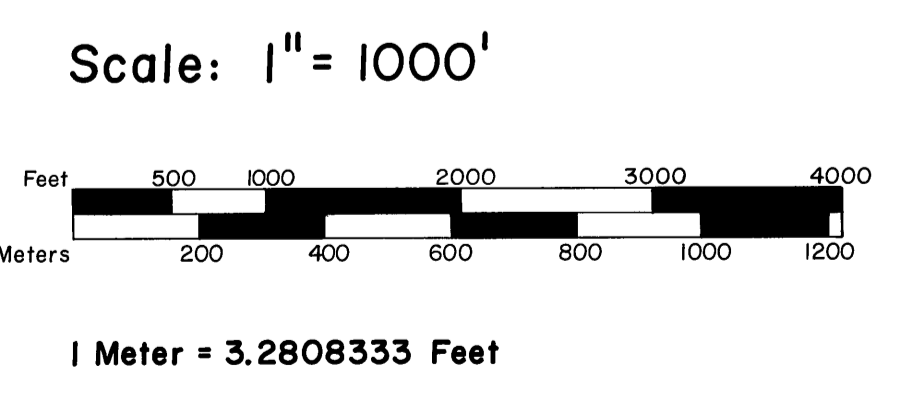

NOTE:
For monumentation information, see monumentation sheets filed separately

Surveyor's Statement

I, Duane I. Griffith, Registered Land Surveyor in the State of Oregon, hereby certify that this plat and the notes hereon, or attached, are a true and correct representation of the survey I made in September and October, 1983, at the request of the USDA, Forest Service, in accordance with the statutes of the State of Oregon, and with the articles of my contract.

The South half of this township was originally surveyed by John B. David under GLO contract number 131, dated June 8, 1869, and the North half by Robb & Gradon under GLO contract number 383, dated March 26, 1881.

My survey was made by running West from the range line, searching as I run. As shown, most corners were found. I ran North from the Southeast and Southwest corners of Section 22 to confirm the excessive distance and North-South shift. The results are as shown. The construction of a road and clearing of junipers in the area of the South 1/4 corner of Section 22 probably accounts for this corner being lost. I found the marked stone near the Southwest corner of Section 19, however it was laying loose on the ground. The area has been extensively logged, and I found it to be approximately 65 feet West of the range line as located. I therefore ran South to the township corner. The 1/4 corner to Sections 25 & 30 is on a North-South fence line in an area which has also been logged. I feel sure the corner has been lost. I went on to the Section corner South. This area is in a very rocky flat and I can see no reason for the corner to be gone. There is a fence corner about 25 feet North of the search area. I am of the opinion that the marks were so light that they cannot be seen. I then went on South to the 1/4 corner to Sections 31 & 36. This search area falls in a road which I feel took the corner. I then went on to the township corner. I also failed to find the Northwest corner of Section 19. This area is on the South side of a steep rocky hill which shows evidence of considerable runoff. I feel the corner has probably washed away. I also did not find the North 1/4 corner. This area has been logged with vigor. Skid trails and general destruction I am sure took the corner. The South 1/4 corner of Section 19 is in a logging operation landing and has been lost. I set these missing corners by proportionate method as prescribed by law.

Duane I. Griffith
Baggett-Griffith & Associates
P.O. Box 576
La Grande, OR 97850

November 9, 1983

Basis of Bearing

A.M. Solar observation taken at a point 60 feet North and 700 feet East of the Southwest corner of Section 20, Township 12 South, Range 32 East of the Willamette Meridian.

Date August 19, 1983
Mean vertical angle 47° 54' 20"
Mean horizontal angle 50° 57' 06"
Mean declination 12° 47' 33"
Latitude 44° 30' 17"
Magnetic declination 17 1/2° East

REGISTERED PROFESSIONAL LAND SURVEYOR
DUANE I. GRIFFITH
644

RECEIVED AND FILED
NOV 30 1983

OFFICE OF COUNTY SURVEYOR
Attest: *Carole Christ*
Co. Sec.

BAGETT - GRIFFITH & ASSOCIATES
La Grande, Oregon

Map of Survey
Survey of National Forest Boundary located in Township 12 South, Range 32 East of the Willamette Meridian

GRANT COUNTY, OREGON	
SURVEYED FOR	Malheur National Forest
SURVEYED BY	d.i.g., g.i.b., r.d.b. 9810/83
Scale: 1" = 1000'	Drawn by: R.G.R. 11/83