

MALHEUR NATIONAL FOREST  
D.S. CADASTRAL SURVEY  
CONTRACT NO. 53-04KK-3-01176  
PRAIRIE CITY RANGER DISTRICT

RECEIVED AND  
FILED

DEC 28 1983


BOUNDARY SURVEY AND SECTION SUBDIVISION OF  
SECTION 9, TOWNSHIP 16 SOUTH, RANGE 33 1/2 EAST, W.M.,  
GRANT COUNTY, OREGON  
W.D. 83-406A

OFFICE OF COUNTY SURVEYOR

*Robert D. Bager*  
Attest: *James Lawrence*

LEGEND

- FOUND 2 1/2" O.D. ALUMINUM PIPE WITH 3 1/4" ALUMINUM CAP BY DOUGLAS M. FERGUSON, LS 848.
- FOUND A GRANT COUNTY SURVEYOR BRASS CAP MONUMENT BY DOUGLAS M. FERGUSON, LS 848.
- SET A 2 1/2" O.D. X 30" LONG ALUMINUM PIPE WITH 3 1/4" ALUMINUM CAP MARKED AS PER THE B.L.M. MANUAL OF INSTRUCTIONS 1973. DURING THIS SURVEY.
- INDICATES U.S.F.S. PROPERTY BOUNDARY POSTED UNDER THIS CONTRACT WITH 6 FOOT LONG STEEL FENCE POSTS WITH U.S.F.S. PROPERTY BOUNDARY SIGNS ATTACHED (54-2).
- [ ] RECORD SURVEY INFORMATION, ORIGINAL GLO BY HENRY W. COOKE IN 1884.
- △ CORNER MONUMENT NUMBER-SEE SHEETS 2-4.

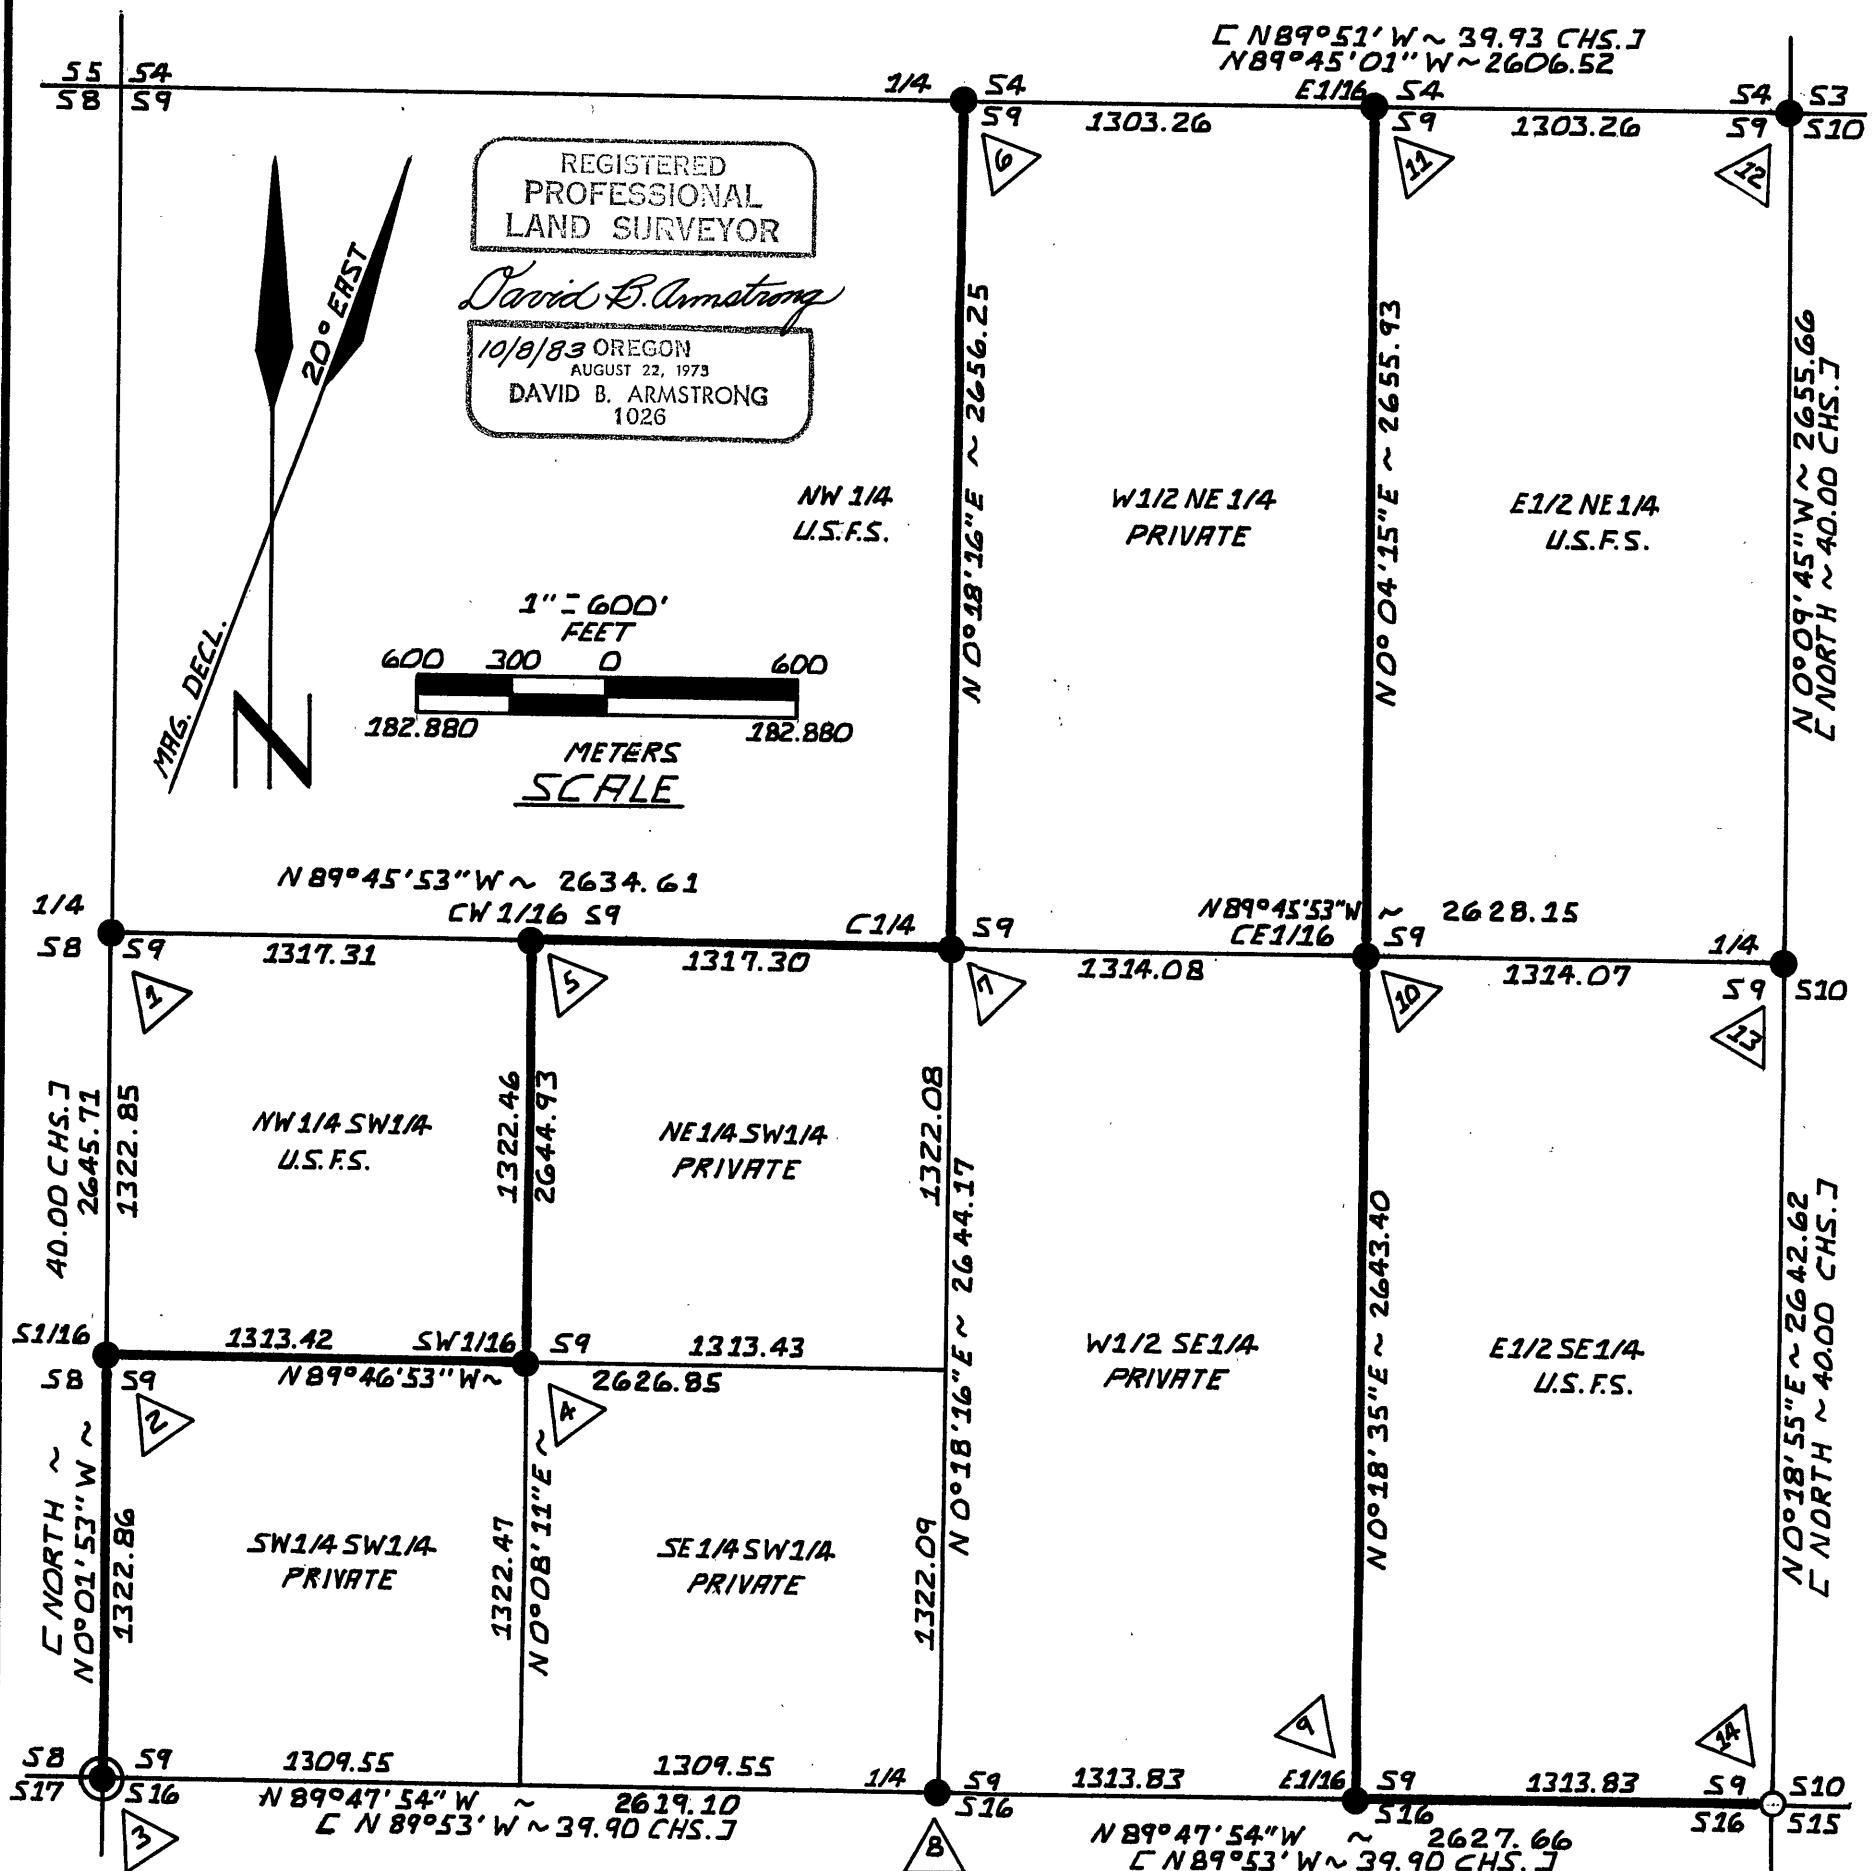

RECORDATION

OFFICE OF COUNTY SURVEYOR, COUNTY OF GRANT,  
STATE OF OREGON. I HEREBY CERTIFY THAT THE  
WITHIN INSTRUMENT WAS FILED FOR RECORD ON  
THE 28 DAY OF Dec, 1983.

*Robert D. Bager*  
GRANT COUNTY SURVEYOR

ARMSTRONG SURVEYING & ENGINEERING, INC.  
378 EAST SECOND STREET  
PRINEVILLE, OREGON 97754  
503/447-7791

SHEET 1 OF 4

W.D. 83-406A

MAP OF SURVEY NO. 794