

NORTH CRANE 1983

CADASTRAL SURVEY


MAGNETIC DEC. 20° EAST

SHEET 1 OF 1

RECEIVED AND
FILED

NOV 22 1983

OFFICE OF COUNTY SURVEYOR
Roy A. Smith
Attest: *James Lawrence*

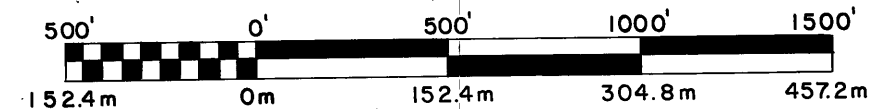

BASIS OF BEARINGS

Solar observation converted to local grid with true meridian running through the C of Section 34.

LEGEND

- Set 30"x2 1/2" Aluminum Pipe with 2 1/2" Aluminum Cap stamped as shown
- Found Brass Cap Monument of Record
- Property Line marked by setting steel posts with boundary signs at maximum intervals of ≈250'
- () Record Bearing or Distance from G.L.O. Contract No. 492
- * () Record Bearing or Distance from G.L.O. Contract No. 398
- - - Limits of Mining or Logging activity

MONUMENTATION

See corresponding Number, in circle, on the map. Aluminum Cap Monuments as described on the "LEGEND" are stamped as shown, in addition, Township, Range, Date & PLS 848 are stamped on each cap. Bearing Trees are scribed in accordance with the "Bureau of Land Management, Manual of Surveying Instructions, of 1973". Also nailed Bearing Tree signs above blaze, Brass Washers stamped PLS 848 on blaze & Warning signs on back of trees. Painted a 6" red band around each tree. Set either one or two steel posts on cardinal directions, within 5 ft. of each corner. See "Certified Record of Land Corner Monumentation forms", as on file in the office of the Grant County Surveyor, for complete information on History, Evidence Found, Monuments Established & Accessories.

- | | | | |
|----------------------|--|---|--|
| ① S27/S26
S34/S35 | A Lodgepole Pine, 6" dia. Bears N56°W, 8.0 ft.
A " " 7" dia. Bears N16°E, 5.4 ft.
A " " 6" dia. Bears S30°E, 19.2 ft.
A " " 5" dia. Bears S53°W, 28.2 ft. | ⑫ NW-SW
1/64 S34 | A Spruce 8" dia. Bears S82-1/2°W, 29.5 ft.
A Lodgepole Pine 7" dia. Bears N63°E, 77.4 ft. |
| ② S27
1/4 S34 | A Lodgepole Pine 6" dia. Bears N12°W, 36.1 ft.
A " " 6" dia. Bears S15°E, 13.0 ft. | ⑬ C-E-SW
1/64 S34 | A Spruce 10" dia. Bears S73°W, 44.5 ft.
A Lodgepole Pine 5" dia. Bears S39°E, 35.4 ft. |
| ③ S28/S27
S33/S34 | A Spruce 6" dia. Bears N48°W, 27.8 ft.
A " " 5" dia. Bears N8°E, 19.6 ft.
A " " 4" dia. Bears S55°W, 19.5 ft. | ⑭ CW-SW
1/64 S34 | A Spruce 8" dia. Bears S15°E, 16.5 ft.
A Tamarack 8" dia. Bears N75°W, 14.4 ft. |
| ④ SN 1/64
S33/S34 | A Lodgepole Pine 8" dia. Bears S66°E, 8.7 ft.
A Fir 7" dia. Bears S62°W, 28.4 ft. | ⑮ SE-SW
1/64 S34 | A Fir 10" dia. Bears S86°W, 30.3 ft.
A Lodgepole Pine 7" dia. Bears S60°E, 26.7 ft. |
| ⑤ SW-NW
1/64 S34 | A Tamarack 20" dia. Bears S4°E, 20.6 ft.
A Lodgepole Pine 8" dia. Bears N41°W, 11.6 ft. | ⑯ C-S-S
1/64 S34 | A Fir 12" dia. Bears N2°W, 15.6 ft.
A " " 13" dia. Bears S68°E, 30.5 ft. |
| ⑥ S34/S35 | A Lodgepole Pine 7" dia. Bears N33°E, 29.1 ft.
A " " 10" dia. Bears N77°W, 21.5 ft. | ⑰ C-S-S-S
1/256 S34 | A Tamarack 20" dia. Bears S10°E, 42.2 ft.
A " " 12" dia. Bears N7°E, 40.4 ft. |
| ⑦ E1/16
C-S34 | A Lodgepole Pine 14" dia. Bears S83°W, 69.4 ft.
A " " 5" dia. Bears S75-1/2°E, 17.7 ft. | ⑱ C-S-S-SE
1/256 S34 | A Fir 12" dia. Bears S45°E, 5.4 ft.
A " " 11" dia. Bears N10°W, 15.0 ft. |
| ⑧ C1/4
S34 | A Lodgepole Pine 7" dia. Bears S83°W, 7.1 ft.
A " " 6" dia. Bears S17°E, 33.1 ft. | ⑲ Maintained corner by scribing new Bearing Trees | A Spruce 13" dia. Bears N52°W, 44.8 ft.
A " " 14" dia. Bears S87°W, 24.9 ft. |
| ⑨ C-W-W
1/64 S34 | A Tamarack 8" dia. Bears N85°E, 13.0 ft.
A Lodgepole Pine 7" dia. Bears N4°E, 8.2 ft. | ⑳ 1/4 S34
S3 | A Tamarack 10" dia. Bears N76°E, 9.4 ft.
A Spruce 13" dia. Bears S47°W, 26.3 ft. |
| ⑩ 1/4
S33/S34 | A Lodgepole Pine 7" dia. Bears N38°E, 46.3 ft.
A Tamarack 18" dia. Bears S55°W, 38.3 ft. | ㉑ S33/S34
S4/S3 | A Fir 10" dia. Bears N20°W, 64.0 ft.
A Lodgepole Pine 5" dia. Bears N30°E, 11.6 ft.
A " " 8" dia. Bears S85°E, 18.6 ft.
A " " 5" dia. Bears S76°W, 31.5 ft. |
| ⑪ NS 1/64
S33/S34 | A Fir 7" dia. Bears N64°W, 48.5 ft.
A Lodgepole Pine 10" dia. Bears S42°E, 10.0 ft. | | |

HISTORY

The South Exterior of T.7S., R.35-1/2 E., originally Surveyed by Eugene P. McCornack, in 1882, under General Land Office Contract No. 398.

T.7S., R.35-1/2 E. was originally Surveyed (subdivided) by William Barr, in 1884, under General Land Office Contract No. 492. His notes indicate considerable development and mining activity in 1884.

In 1974 the Bureau of Land Management remonumented the Southeast corner of Section 34, from original evidence.

REGISTERED
PROFESSIONAL
LAND SURVEYOR

OREGON
JULY 12, 1968
DOUGLAS M. FERGUSON
848

FERGUSON SURVEYING & ENGINEERING

MT. VERNON, OR.

Map of Survey
SUBDIVISION OF SECTION 34, T.7S., R.35-1/2 E

GRANT COUNTY OREGON

FOR: Umatilla National Forest BY: Douglas M. Ferguson, Dan Martin & D. Mitchell Ferguson

DATE: Sept. 1983 DRAWN BY: D.M. Ferguson SCALE: 1" = 500'

