

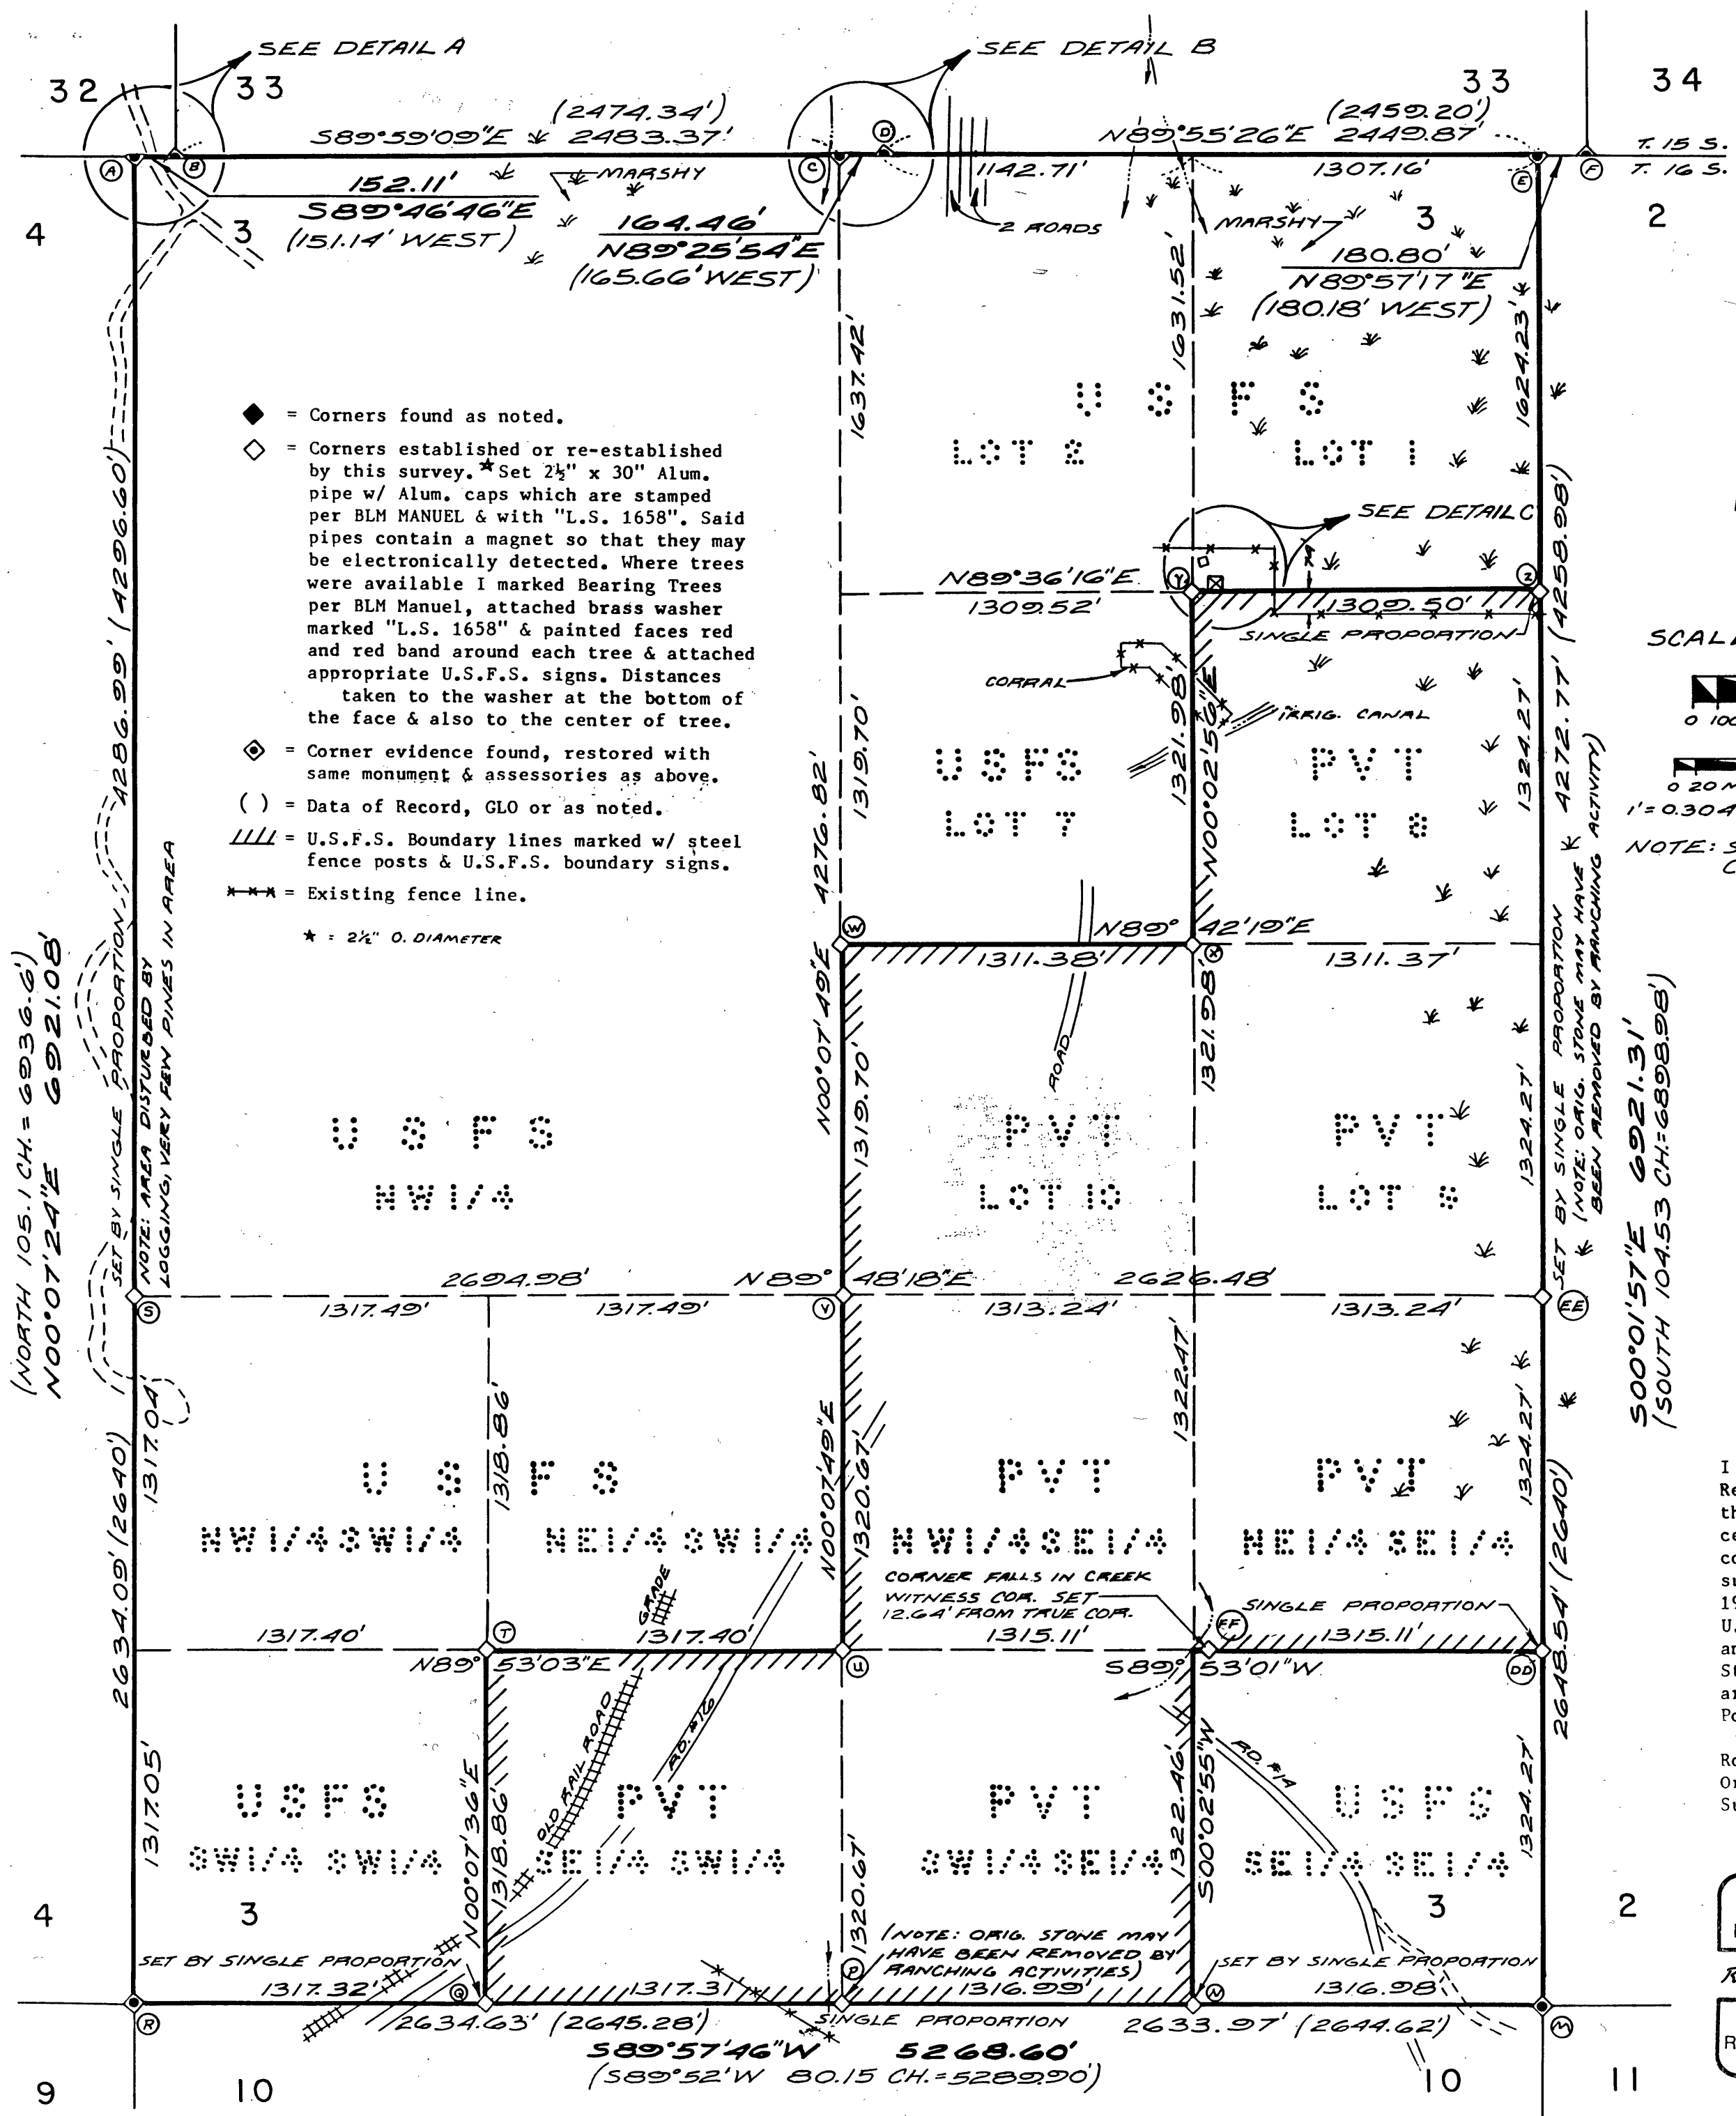


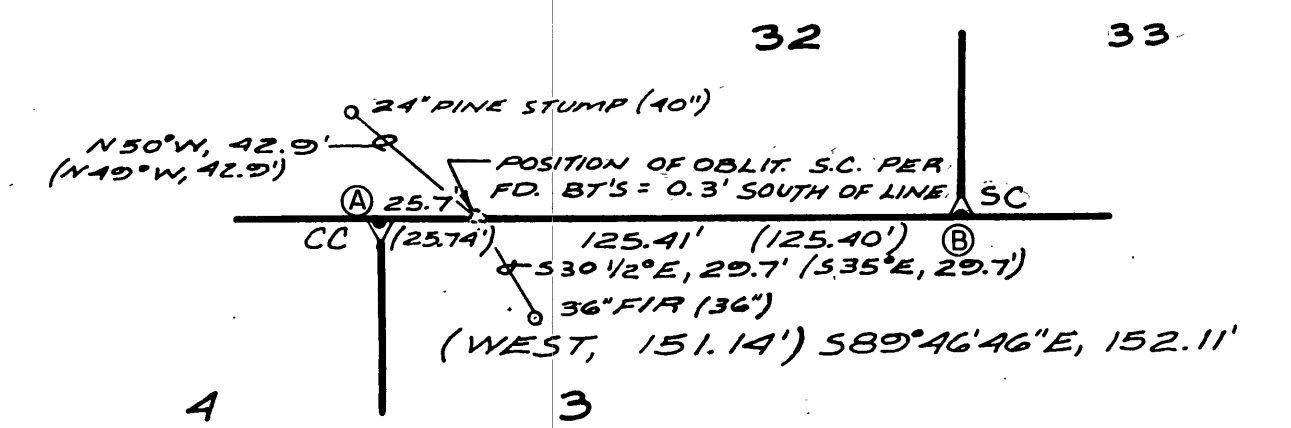


RECORD OF SURVEY
BY
J & R SURVEYORS OF DALLAS, OREGON
FOR THE
U.S. FOREST SERVICE
SUBDIVISION OF SEC. 3, T. 16 S., R. 34 E., WILLAMETTE MERIDIAN
GRANT COUNTY, OREGON
AUGUST 1983

NARRATIVE: The purpose of this survey is to subdivide Sections 2 & 3 and mark lines as shown hereon. Bearings are true per Solar Observation taken near the Northwest corner of section 2 and on the North line of said section. Field notes are on file in Book 1, Porock Cadastral Survey, Contract No. 53-04KK-2-01055, in the office of J & R SURVEYORS, Dallas, OR.

HISTORY: The South line of T15S, R35E was originally surveyed by Henry W. Cooke in 1883. Said line was re-surveyed by George R. Campbell in 1900-1902 to supposedly correct the faulty original survey by setting new Standard Corners and destroying the old ones. While doing so, Campbell also set the 1/4 corners for T16S, R34E and calls the closing corners on line. T16S, R34E was also originally surveyed by Henry W. Cooke but in 1884 and he did not set the 1/4 corners on the North lines of sections 2 & 3.
NOTE: Because of the above history all the corners along the Standard Parallel have equal weight in controlling both line & distance.
NOTE: While Campbell's line was fairly accurate his distances were not.

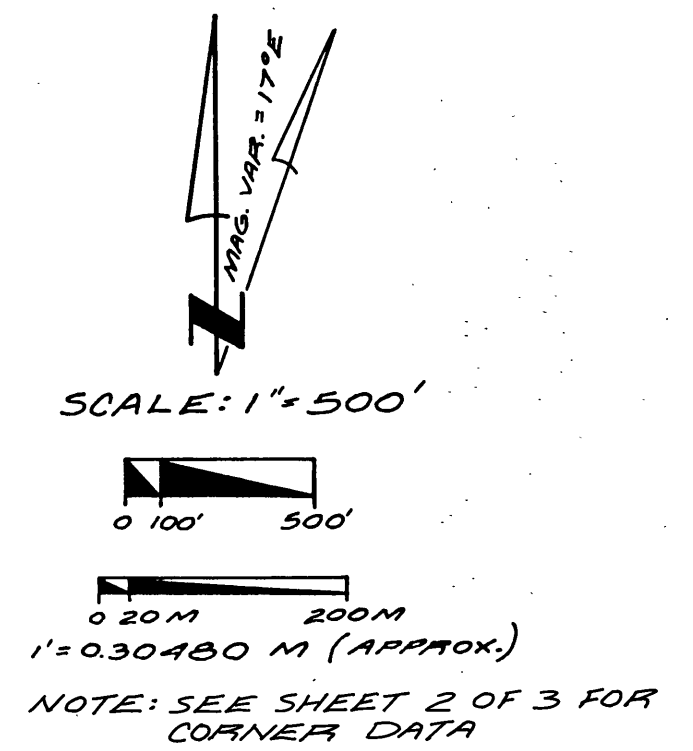


DETAIL A
SCALE: 1" = 50'

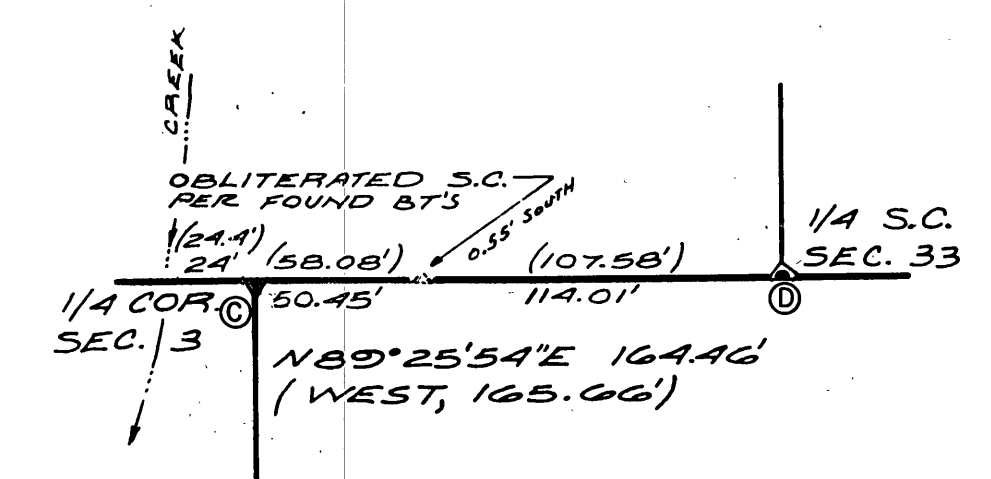

DETAIL B
SCALE: 1" = 60'

WOOD SHED
U.S.F.S.

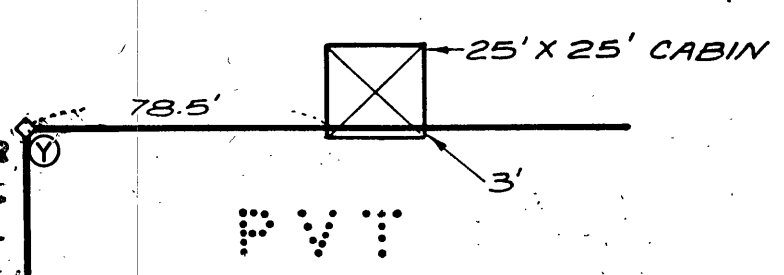

DETAIL C
SCALE: 1" = 50'

CERTIFICATION
I Ronald H. Schulson, a Registered Land Surveyor in the State of Oregon, hereby certify that this plat is a correct representation of a survey I performed during Oct., 1982 to August, 1983 for the U.S. Forest Service, in accordance with the Statutes of the State of Oregon and with the articles of my contract for Porock Cadastral Survey.

Ronald H. Schulson
Oregon Registered Land Surveyor No. 1658.

REGISTERED PROFESSIONAL LAND SURVEYOR
Ronald H. Schulson

OREGON
JULY 14, 1978
RONALD H. SCHULSON
1658

J & R SURVEYORS
P. O. BOX 418
DALLAS, OR 97338
PH. 623-4003

RECEIVED AND
FILED

NOV 30 1983

OFFICE OF COUNTY SURVEYOR
Grant County, Oregon
Michael D. Velt
Co. Clerk