
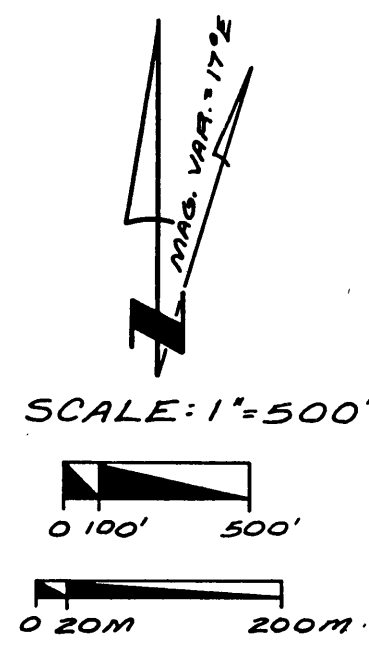



RECORD OF SURVEY
BY
J & R SURVEYORS OF DALLAS, OREGON
FOR THE
U.S. FOREST SERVICE
SUBDIVISION OF SEC. 2, T. 16 S., R. 34 E., WILLAMETTE MERIDIAN
GRANT COUNTY, OREGON
AUGUST 1983

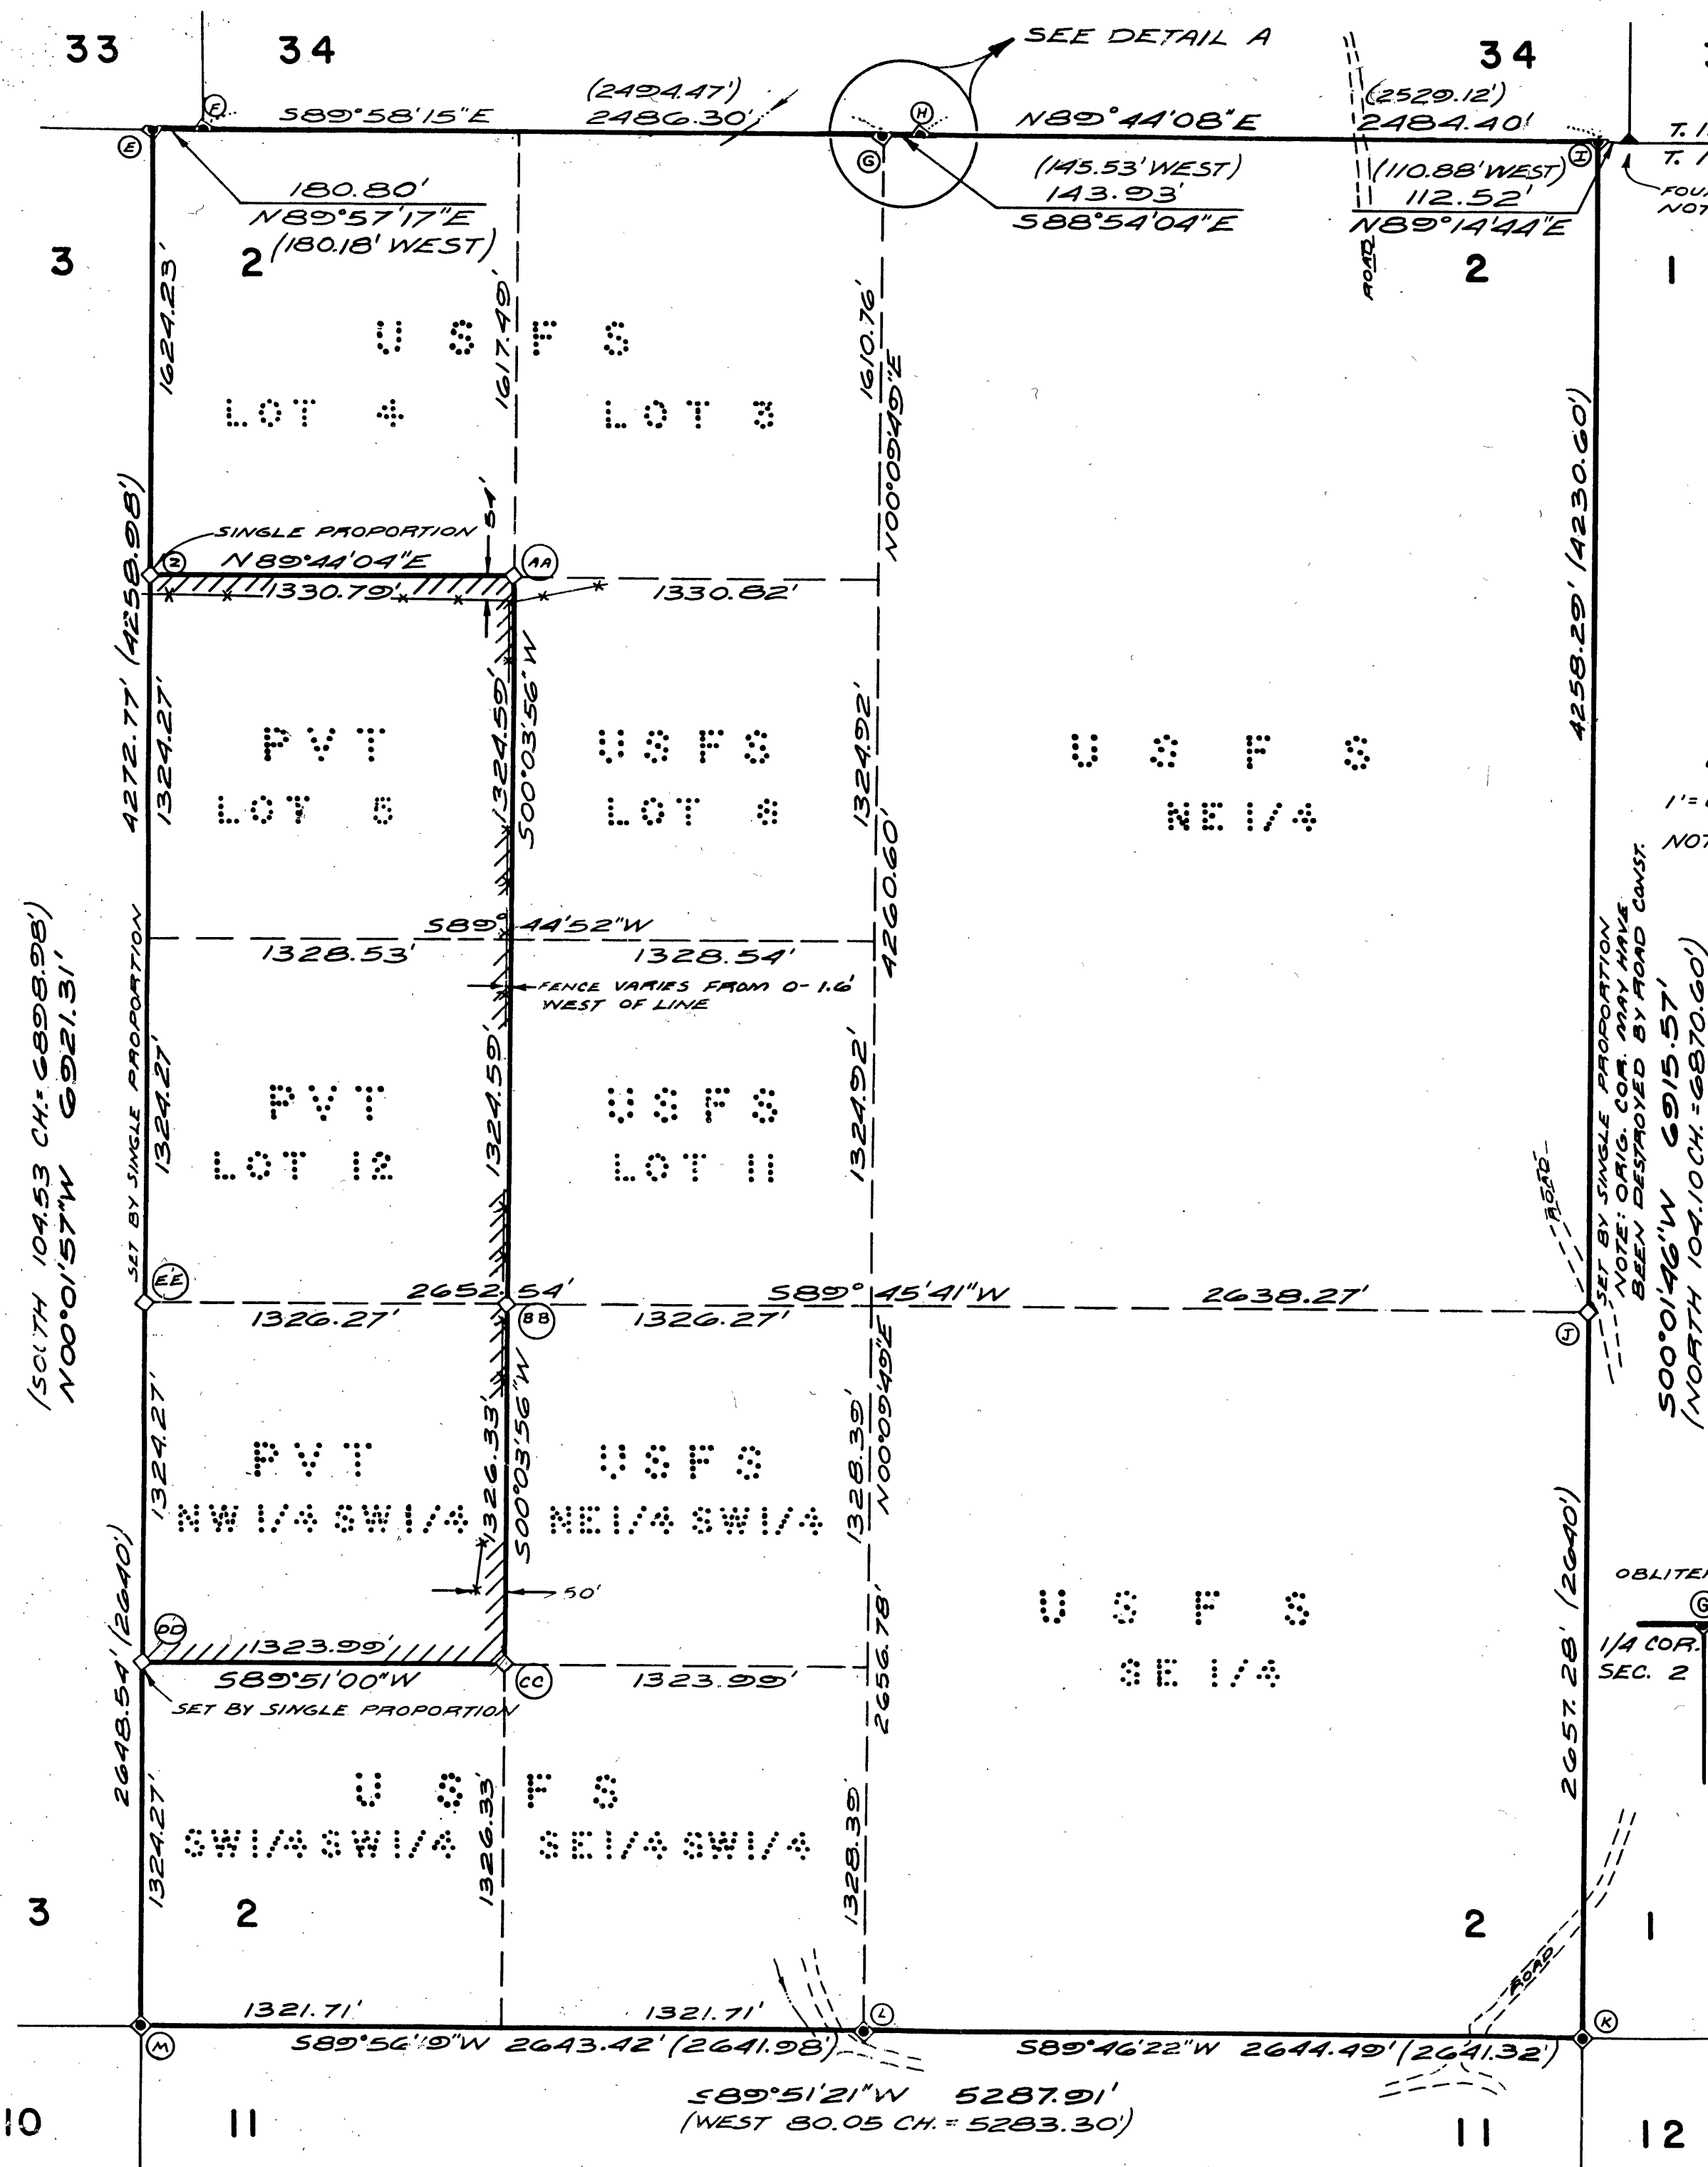

- ◆ = Corners found as noted.
- ◇ = Corners established or re-established by this survey.
- ★ Set 2 1/2" x 30" Alum. pipes w/ Alum. caps which are stamped per BLM MANUEL & with "L.S. 1658". Where available I marked bearing trees per BLM Manuel, attached brass washer marked "L.S. 1658" & painted faces red and red band around each tree & attached appropriate U.S.F.S. signs. Distances were taken to the washer at the bottom of the face & also to the center of tree.
- ◇ = Corner evidence found, restored with same monument & accessories as above.
- () = Data of Record, GLO or as noted.
- |||| = U.S.F.S. Boundary line marked w/ steel fence posts & U.S.F.S. boundary signs.
- ***** = Existing fence line.
- ★ = 2 1/2" O. DIAMETER

NARRATIVE: The purpose of this survey is to subdivide Sections 2 & 3 and mark lines as shown hereon. Bearings are true per Solar Observation taken near the Northwest corner of section 2 and on the North line of said section. Field notes are on file in Book 1, Porock Cadastral Survey, Contract No. 53-04KK-2-01055, in the office of J & R SURVEYORS, Dallas, OR.

HISTORY: The South line of T15S, R35E was originally surveyed by Henry W. Cooke in 1883. Said line was re-surveyed by George R. Campbell in 1900-1902 to supposedly correct the faulty original survey by setting new Standard Corners and destroying the old ones. While doing so, Campbell also set the 1/4 corners for T16S, R34E and calls the closing corners on line. T16S, R34E was also originally surveyed by Henry W. Cooke but in 1884 and he did not set the 1/4 corners on the North lines of sections 2 & 3.
NOTE: Because of the above history all the corners along the Standard Parallel have equal weight in controlling both line & distance.
NOTE: While Campbell's line was fairly accurate his distances were not.

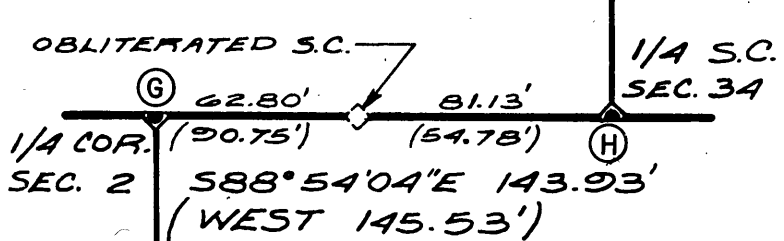

DETAIL A
SCALE: 1" = 60'

RECEIVED AND
FILED

NOV 30 1983
OFFICE OF COUNTY SURVEYOR
Attest: *[Signature]*
Co. 008

REGISTERED
PROFESSIONAL
LAND SURVEYOR

Ronald H. Schulson
RONALD H. SCHULSON
1658

Ronald H. Schulson
Oregon Registered Land Surveyor
No. 1658.

J & R SURVEYORS
P.O. BOX 418
DALLAS, OR 97338
Ph. 623-4003