


MAP OF SURVEY
RIGHT OF WAY FOR A PORTION OF COUNTY ROAD NO. 68
SITUATED IN
SECTIONS 33 & 34, T17S, R28E, W.M.
SECTIONS 3 & 10, T18S, R28E, W.M.

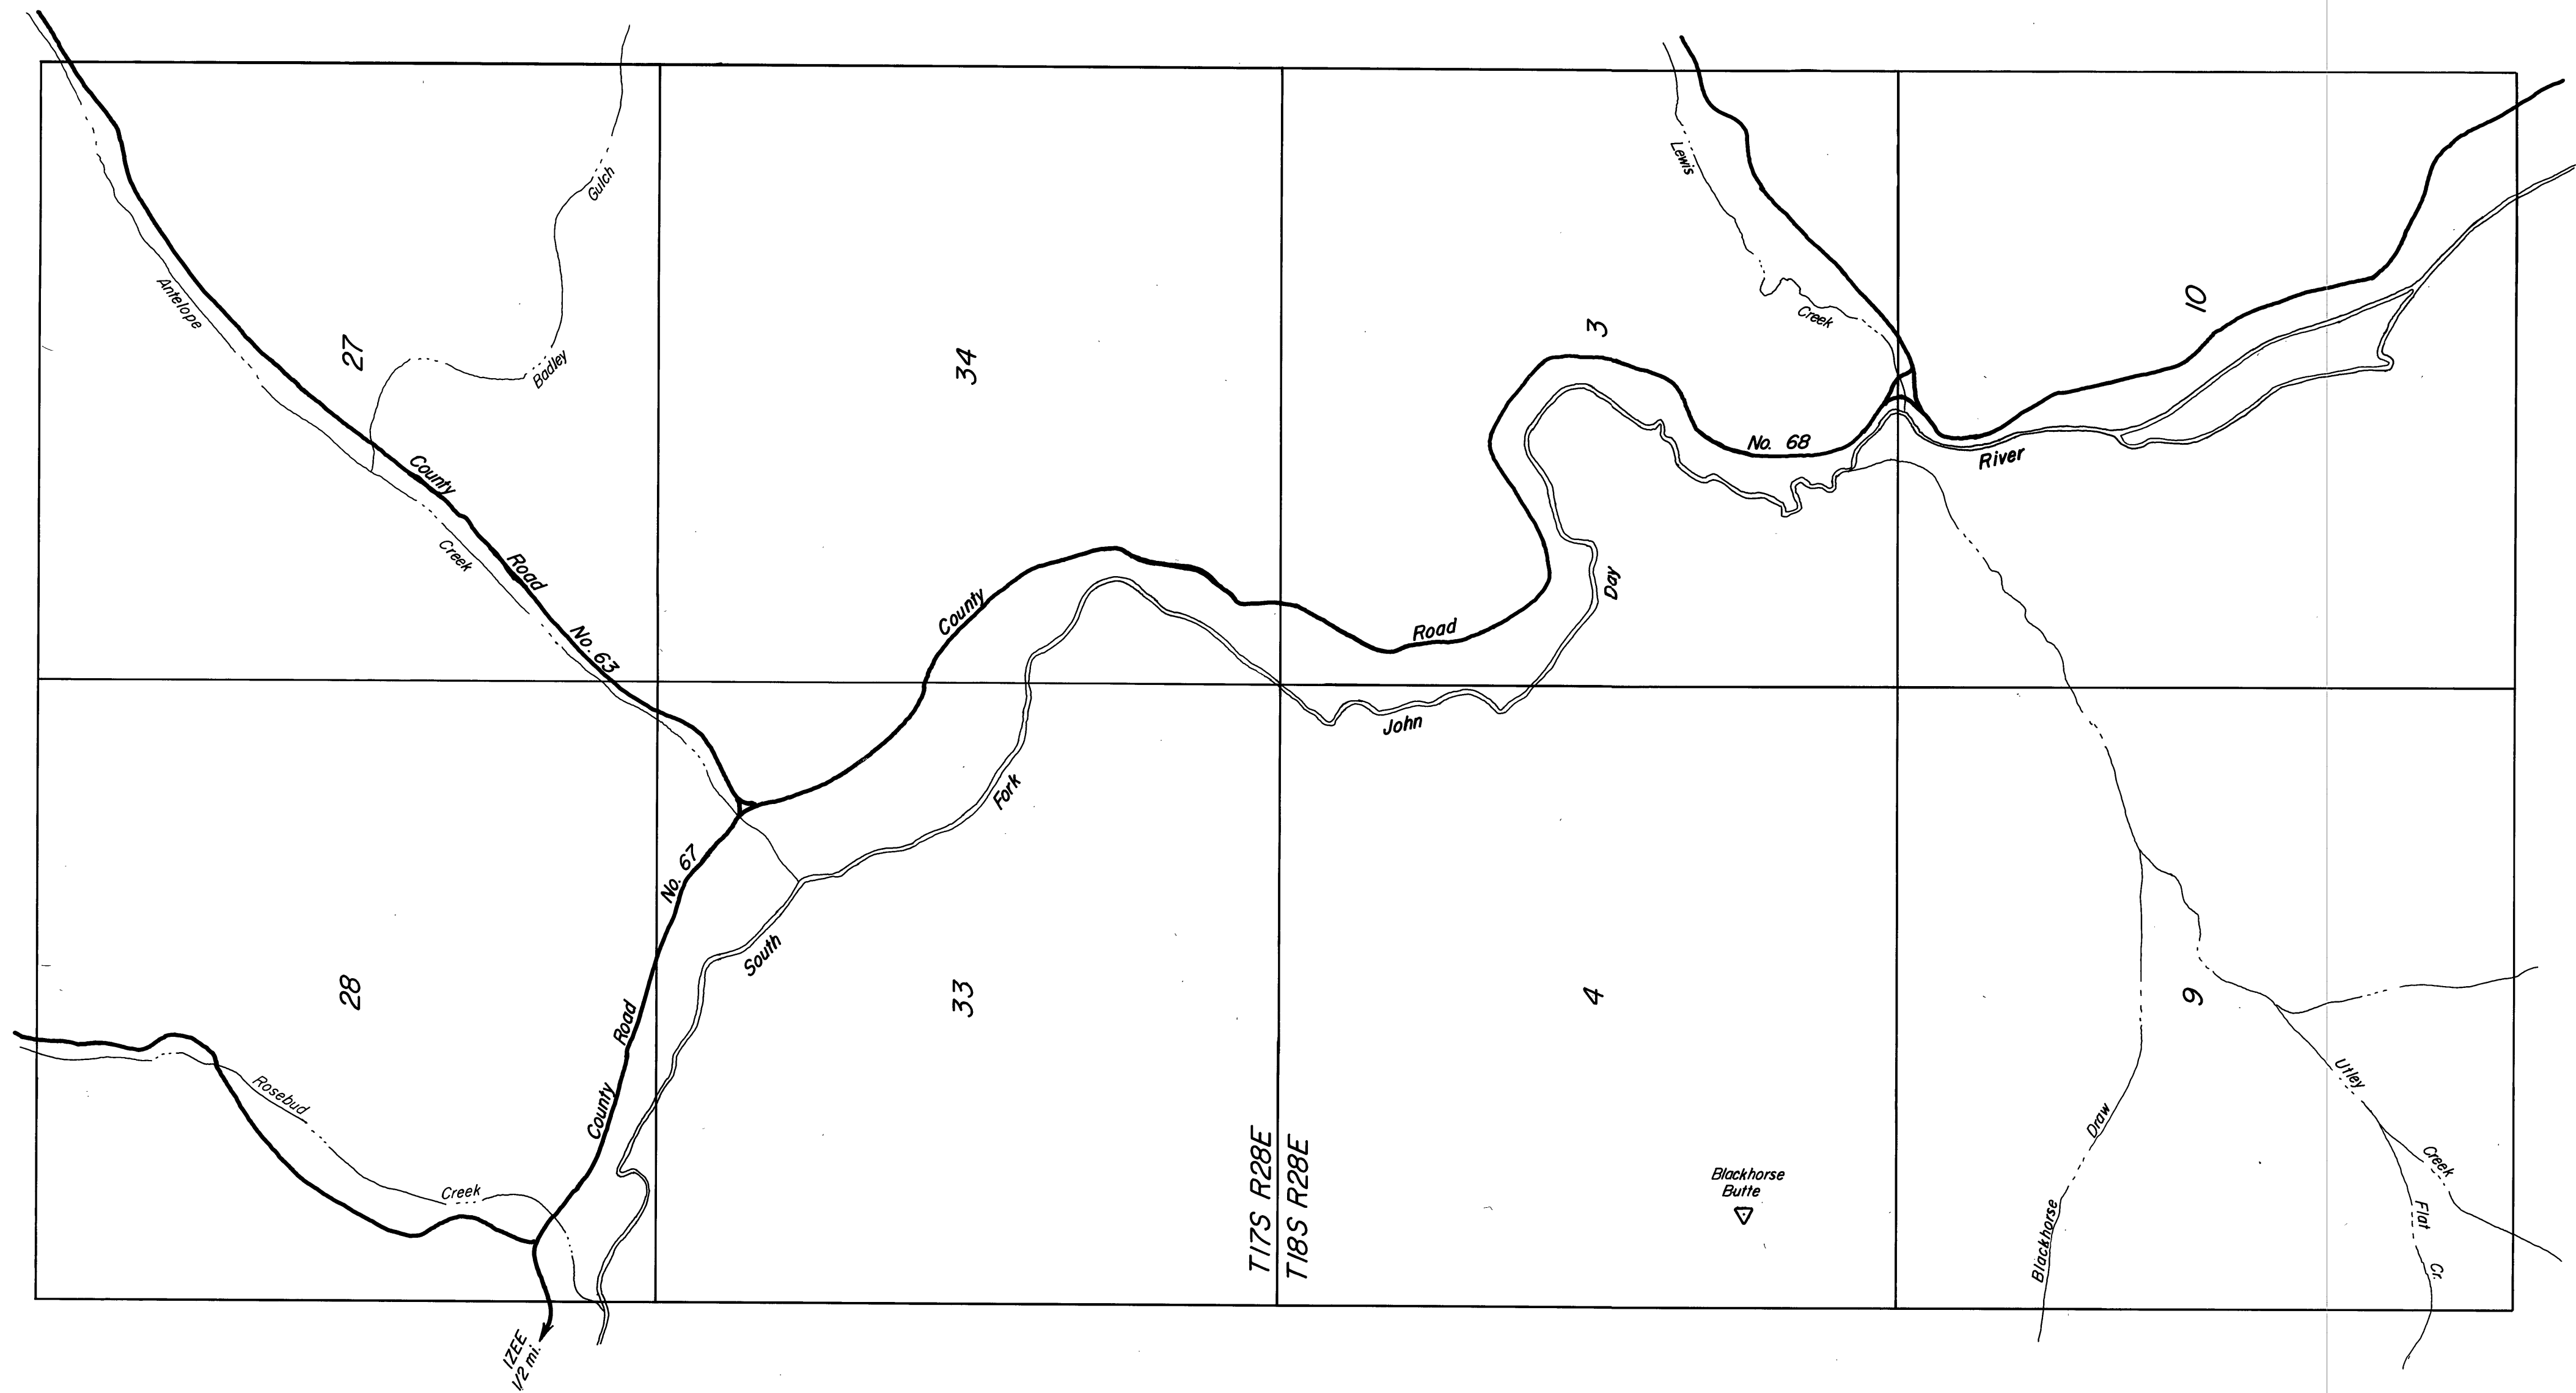

NARRATIVE: This survey was performed at the request of the Grant County Roadmaster to establish the right-of-way for the lower portion of County Road No. 68 as shown hereon. A search was made of the available records pertaining to this survey. I find no deeded right-of-way on this portion of the road. Field measurements were made to locate the centerline and the necessary right-of-way widths for this road. New monuments were set along the right-of-way lines as shown hereon.

NOTE: The section lines and section subdivisional lines shown on sheets 2 through 7 are approximations protracted from the few section corners that we found and tied to this road survey.



BASIS OF BEARINGS
SOLAR OBSERVATION

RECEIVED AND
FILED

APR 4 1984

OFFICE OF COUNTY SURVEYOR
Robert D. Baggett
Attest: *Jamie Lawrence*

REGISTERED
PROFESSIONAL
LAND SURVEYOR
Robert D. Baggett
OREGON
JULY 12, 1983
ROBERT D. BAGGETT
598

BAGETT - GRIFFITH & ASSOCIATES John Day, Oregon		
VICINITY MAP		
GRANT COUNTY, OREGON		
SURVEYED FOR	GRANT COUNTY ROAD DEPARTMENT	
SURVEYED BY	R.D.B. & J.L.W.	3/22 & 2/84
Scale: 1" = 1000'	Drawn by: J.L.W.	2/84