


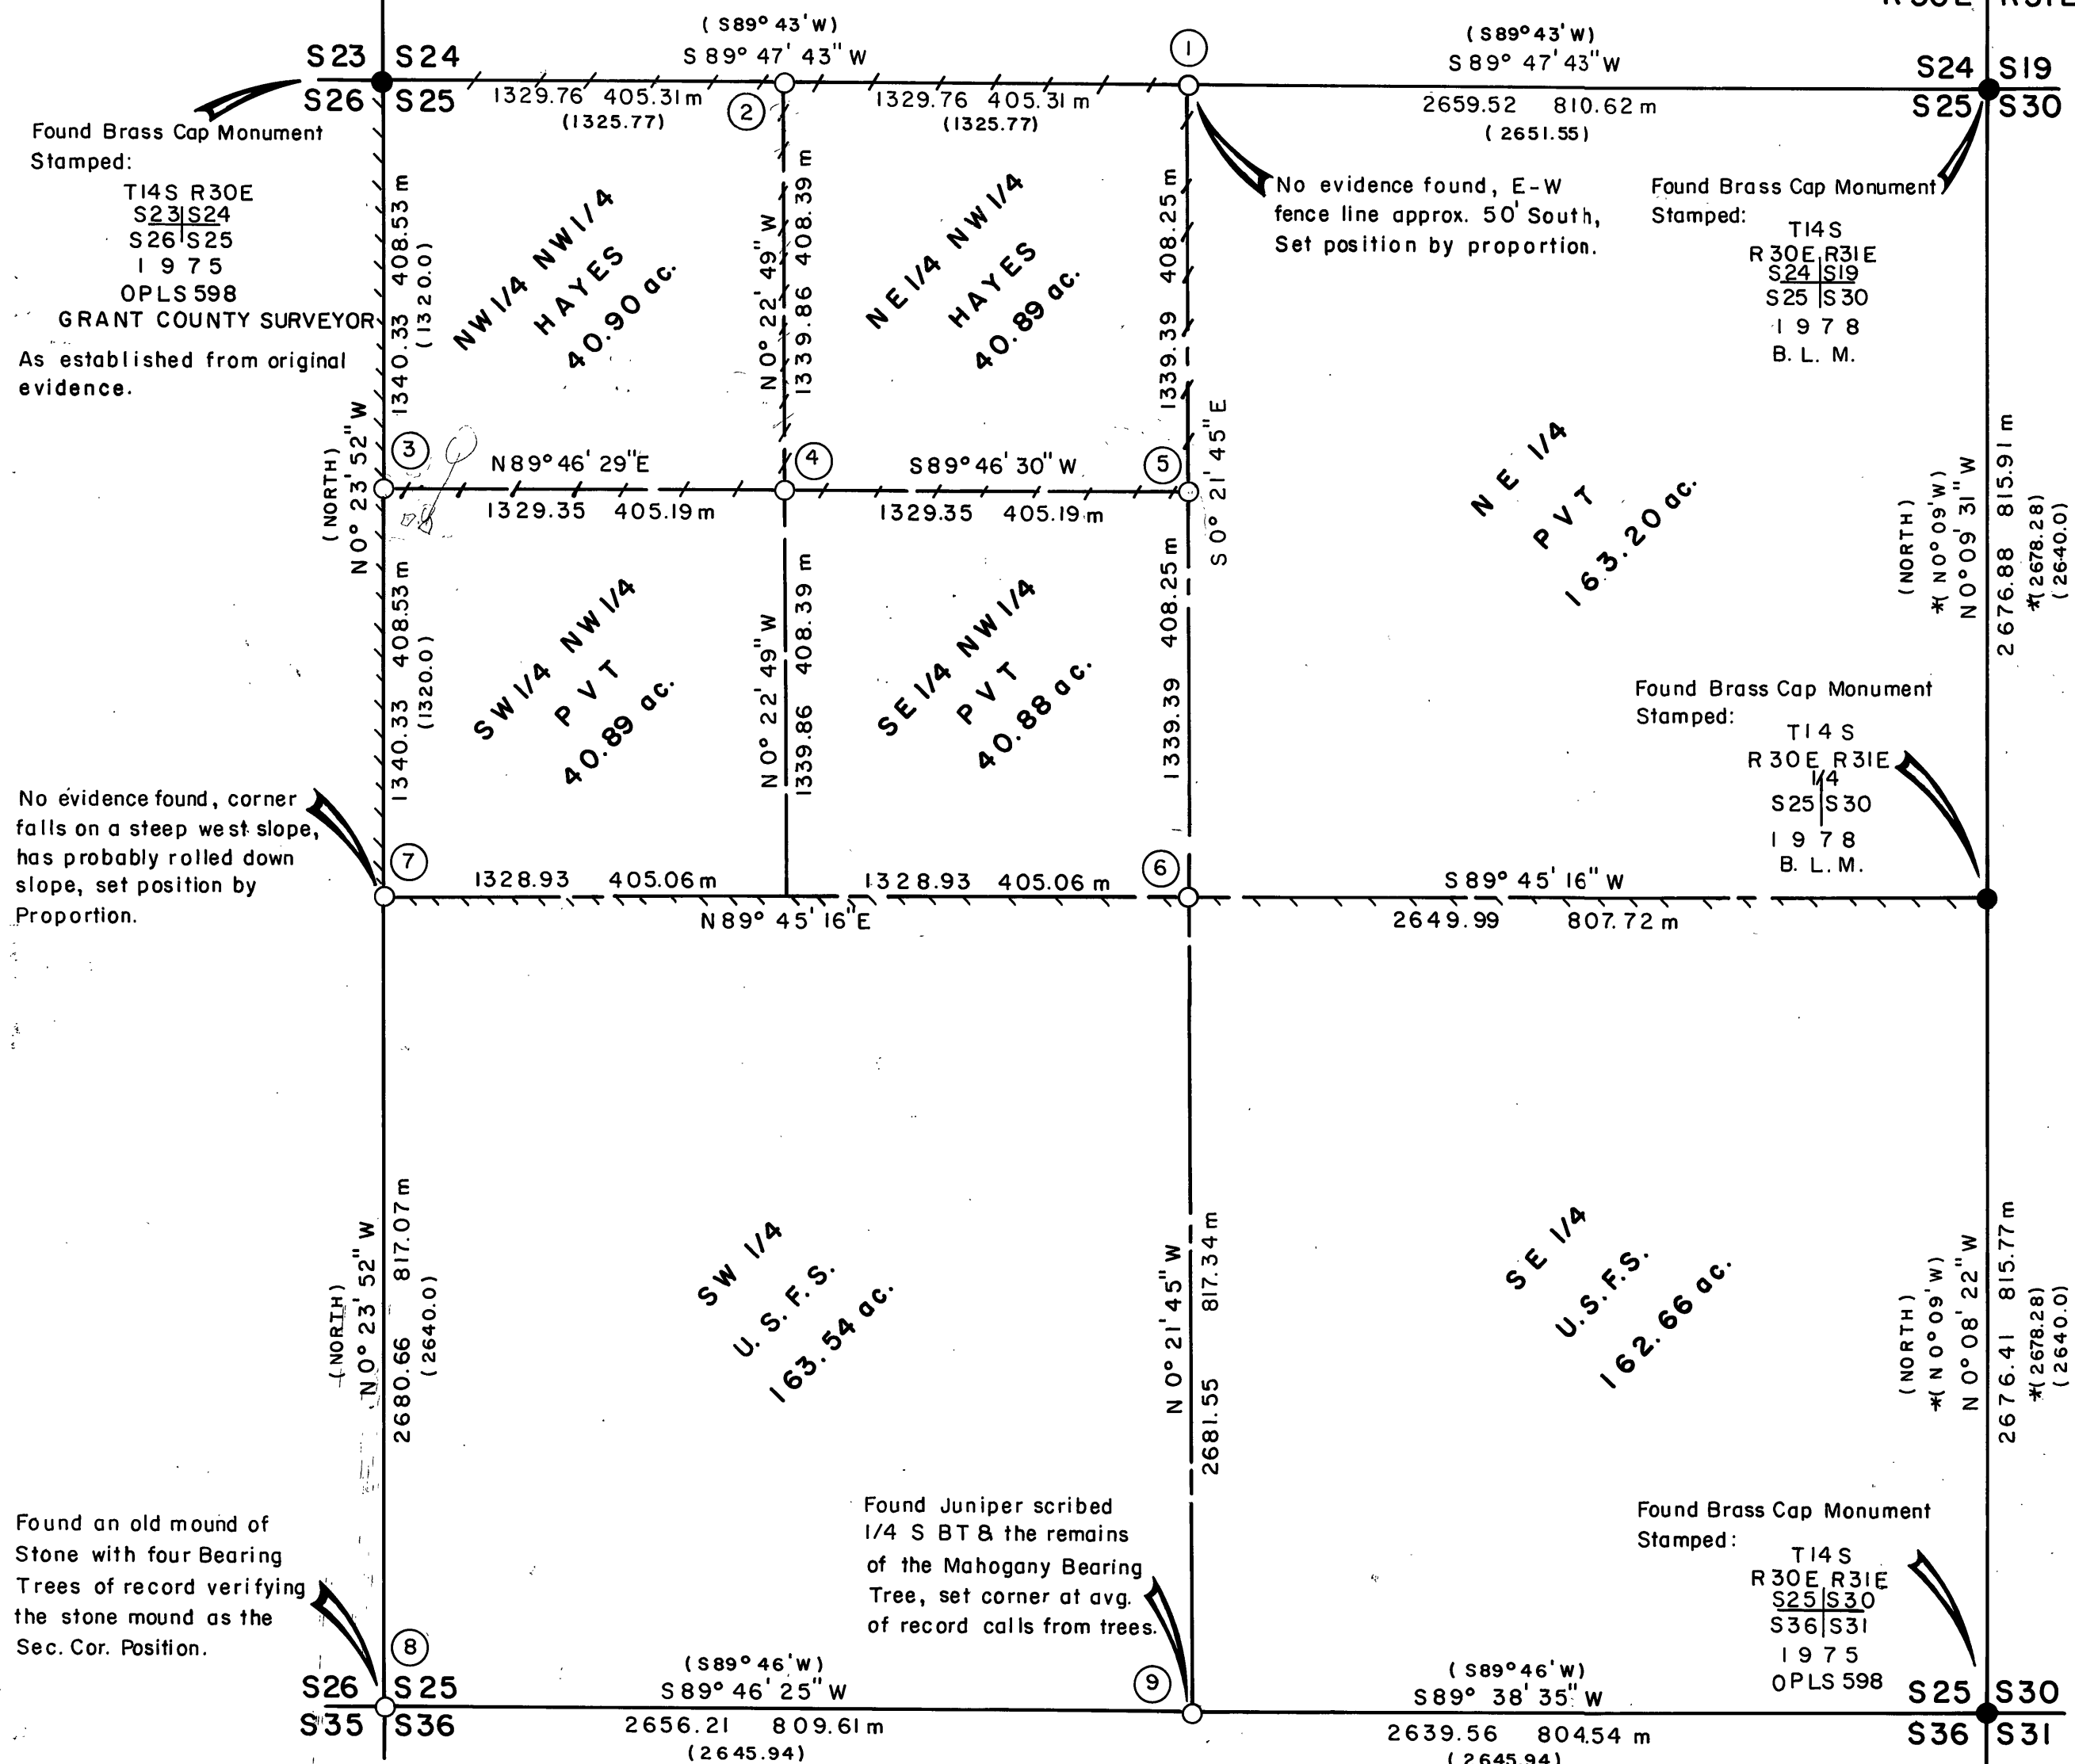

Found Brass Cap Monument
Stamped:
T14S R30E
S23 S24
S26 S25
1975
OPLS 598
GRANT COUNTY SURVEYOR
As established from original
evidence.

Found Brass Cap Monument
Stamped:
T14S
R30E R31E
S24 S19
S25 S30
1978
B. L. M.

Found Brass Cap Monument
Stamped:
T14S
R30E R31E
S25 S30
1978
B. L. M.

Found Brass Cap Monument
Stamped:
T14S
R30E R31E
S25 S30
S36 S31
1975
OPLS 598

No evidence found, corner
falls on a steep west slope,
has probably rolled down
slope, set position by
Proportion.

No evidence found, E-W
fence line approx. 50' South,
Set position by proportion.

Found an old mound of
Stone with four Bearing
Trees of record verifying
the stone mound as the
Sec. Cor. Position.

Found Juniper scribed
1/4 S BT & the remains
of the Mahogany Bearing
Tree, set corner at avg.
of record calls from trees.

Found Brass Cap Monument
Stamped:
T14S
R30E R31E
S25 S30
S36 S31
1975
OPLS 598

HISTORY

Exteriors of Sec. 25 where originally Surveyed by S.W. Lackland, in 1880, under General Land Office Contract No. 357

In 1975 the N.W. Cor. and the S.E. Cor. of this Section 25 where re-monumented from original, existing evidence, by P.L.S. 598.

In 1978, the N.E. Cor. of this Section 25 was re-monumented from original existing evidence and the East 1/4 Cor. of this Section was re-established by Single Proportion & monumented, all by the Bureau of Land Management, as shown by Map of Survey No. 613, as filed in the Grant County Surveyors Office.

NARRATIVE

This Survey is performed at the request of Mrs. Hayes and the Malheur National Forest, the purpose of which is to determine the boundaries of the N. 1/2 of the N.W. 1/4 of this Section 25 (Hayes Property) and divide that parcel into the N.W. 1/4 of the N.W. 1/4 & N.E. 1/4 of the N.W. 1/4, as shown. Also the Malheur National Forest boundaries in Section 25 are located and marked as shown on the map, above.

RECEIVED AND
FILED

APR 12 1984

OFFICE OF COUNTY SURVEYOR

Attest: *[Signature]*
Co. Clerk

REGISTERED
PROFESSIONAL
LAND SURVEYOR

OREGON
JULY 12, 1969
DOUGLAS M. FERGUSON
848


FERGUSON SURVEYING & ENGINEERING
Mt. Vernon Oregon

SUBDIVISION OF SECTION 25, T14S, R30E.
GRANT COUNTY OREGON

For: Mrs. Hayes & Malheur National Forest

By: Douglas M. Ferguson Date: Nov. 1983 - March 1984

Magnetic Dec. = 20°E

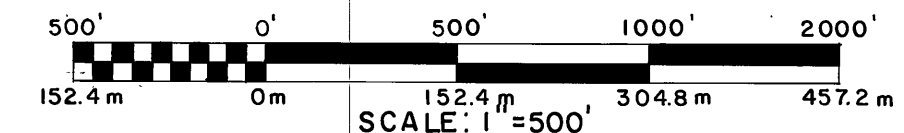

BASIS OF BEARINGS

Solar Observation taken on the West line of Sec. 25,
corrected + 0° 00' 26" to local grid, with true bearing
through Q of the section.

LEGEND

- Set 2-1/2" x 30" Aluminum pipe with 2-1/2" Aluminum Cap
- Found Brass Cap monument of Record
- Property line mark by setting steel posts with U.S.F.S. Boundary Signs
Set at max. intervals of 200
- Property line marked by blazing and painting (red) trees
- () Record Bearing or Distance from original G.L.O. Survey
- * () Record Bearing or Distance from Map of Survey No. 613
By the Bureau of Land Management (B.L.M.)

MONUMENTATION

See corresponding number, in circle on the map. Caps are also stamped with, Twp., Range, year set & P.L.S. 848. Bearing Trees are scribed in accordance with 1973 Manual of Surveying Instructions. Nailed Bearing Treesigns, Warning signs & Brass Washers stamped P.L.S. 848 to each Tree. Set steel posts on property line or on cardinal direction within 5 ft. of each corner.
(See monumentation Records as on file in the Grant County Surveyors Office.)

- R / 23 (1) 1/4 S24 A Pine 10" dia. Bears N12°E, 13.5 ft.
S25 A Pine 9" dia. Bears S47°W, 9.0 ft.
- R / 22 (2) W1/16 S24 A Pine 14" dia. Bears N78°E, 24.3 ft.
S25 A Pine 14" dia. Bears S37°W, 8.2 ft.
- S / 21 (3) N1/16 S26 A Pine 10" dia. Bears N33°E, 5.4 ft.
S25 A Pine 12" dia. Bears S54°W, 26.4 ft.
- S / 22 (4) NW 1/6 S25 A Juniper 10" dia. Bears N64°E, 65.2 ft.
S25 A Pine 10" dia. Bears S52°W, 39.2 ft.
- S / 23 (5) NW 1/6 S25 A Juniper 13" dia. Bears N12°E, 4.9 ft.
S25 A Pine 7" dia. Bears S12°E, 31.7 ft.
- T / 23 (6) C1/4 S25 A Juniper 8" dia. Bears S83°E, 13.0 ft.
S25 A Pine 6" dia. Bears N49°W, 12.8 ft.
- T / 21 (7) 1/4 S26 A Pine 8" dia. Bears N6°E, 36.0 ft.
S25 A Pine 20" dia. Bears S36°W, 10.6 ft.
- V / 21 (8) S26 S25 A Pine 20" dia. (an original Bearing Tree) Bears N40°W, 33.6 ft.
S35 S36 A Pine 18" dia. () Bears N 8° E, 23.0 ft.
A Pine 18" dia. Bears S44°E, 39.0 ft.
A Pine 10" dia. Bears S70°W, 15.5 ft.
- V / 23 (9) 1/4 S25 A Juniper 20" dia. (an original Bearing Tree) Bears S58°W, 20.0 ft.
S26 A Fir 24" dia. Bears N14°E, 31.5 ft.