


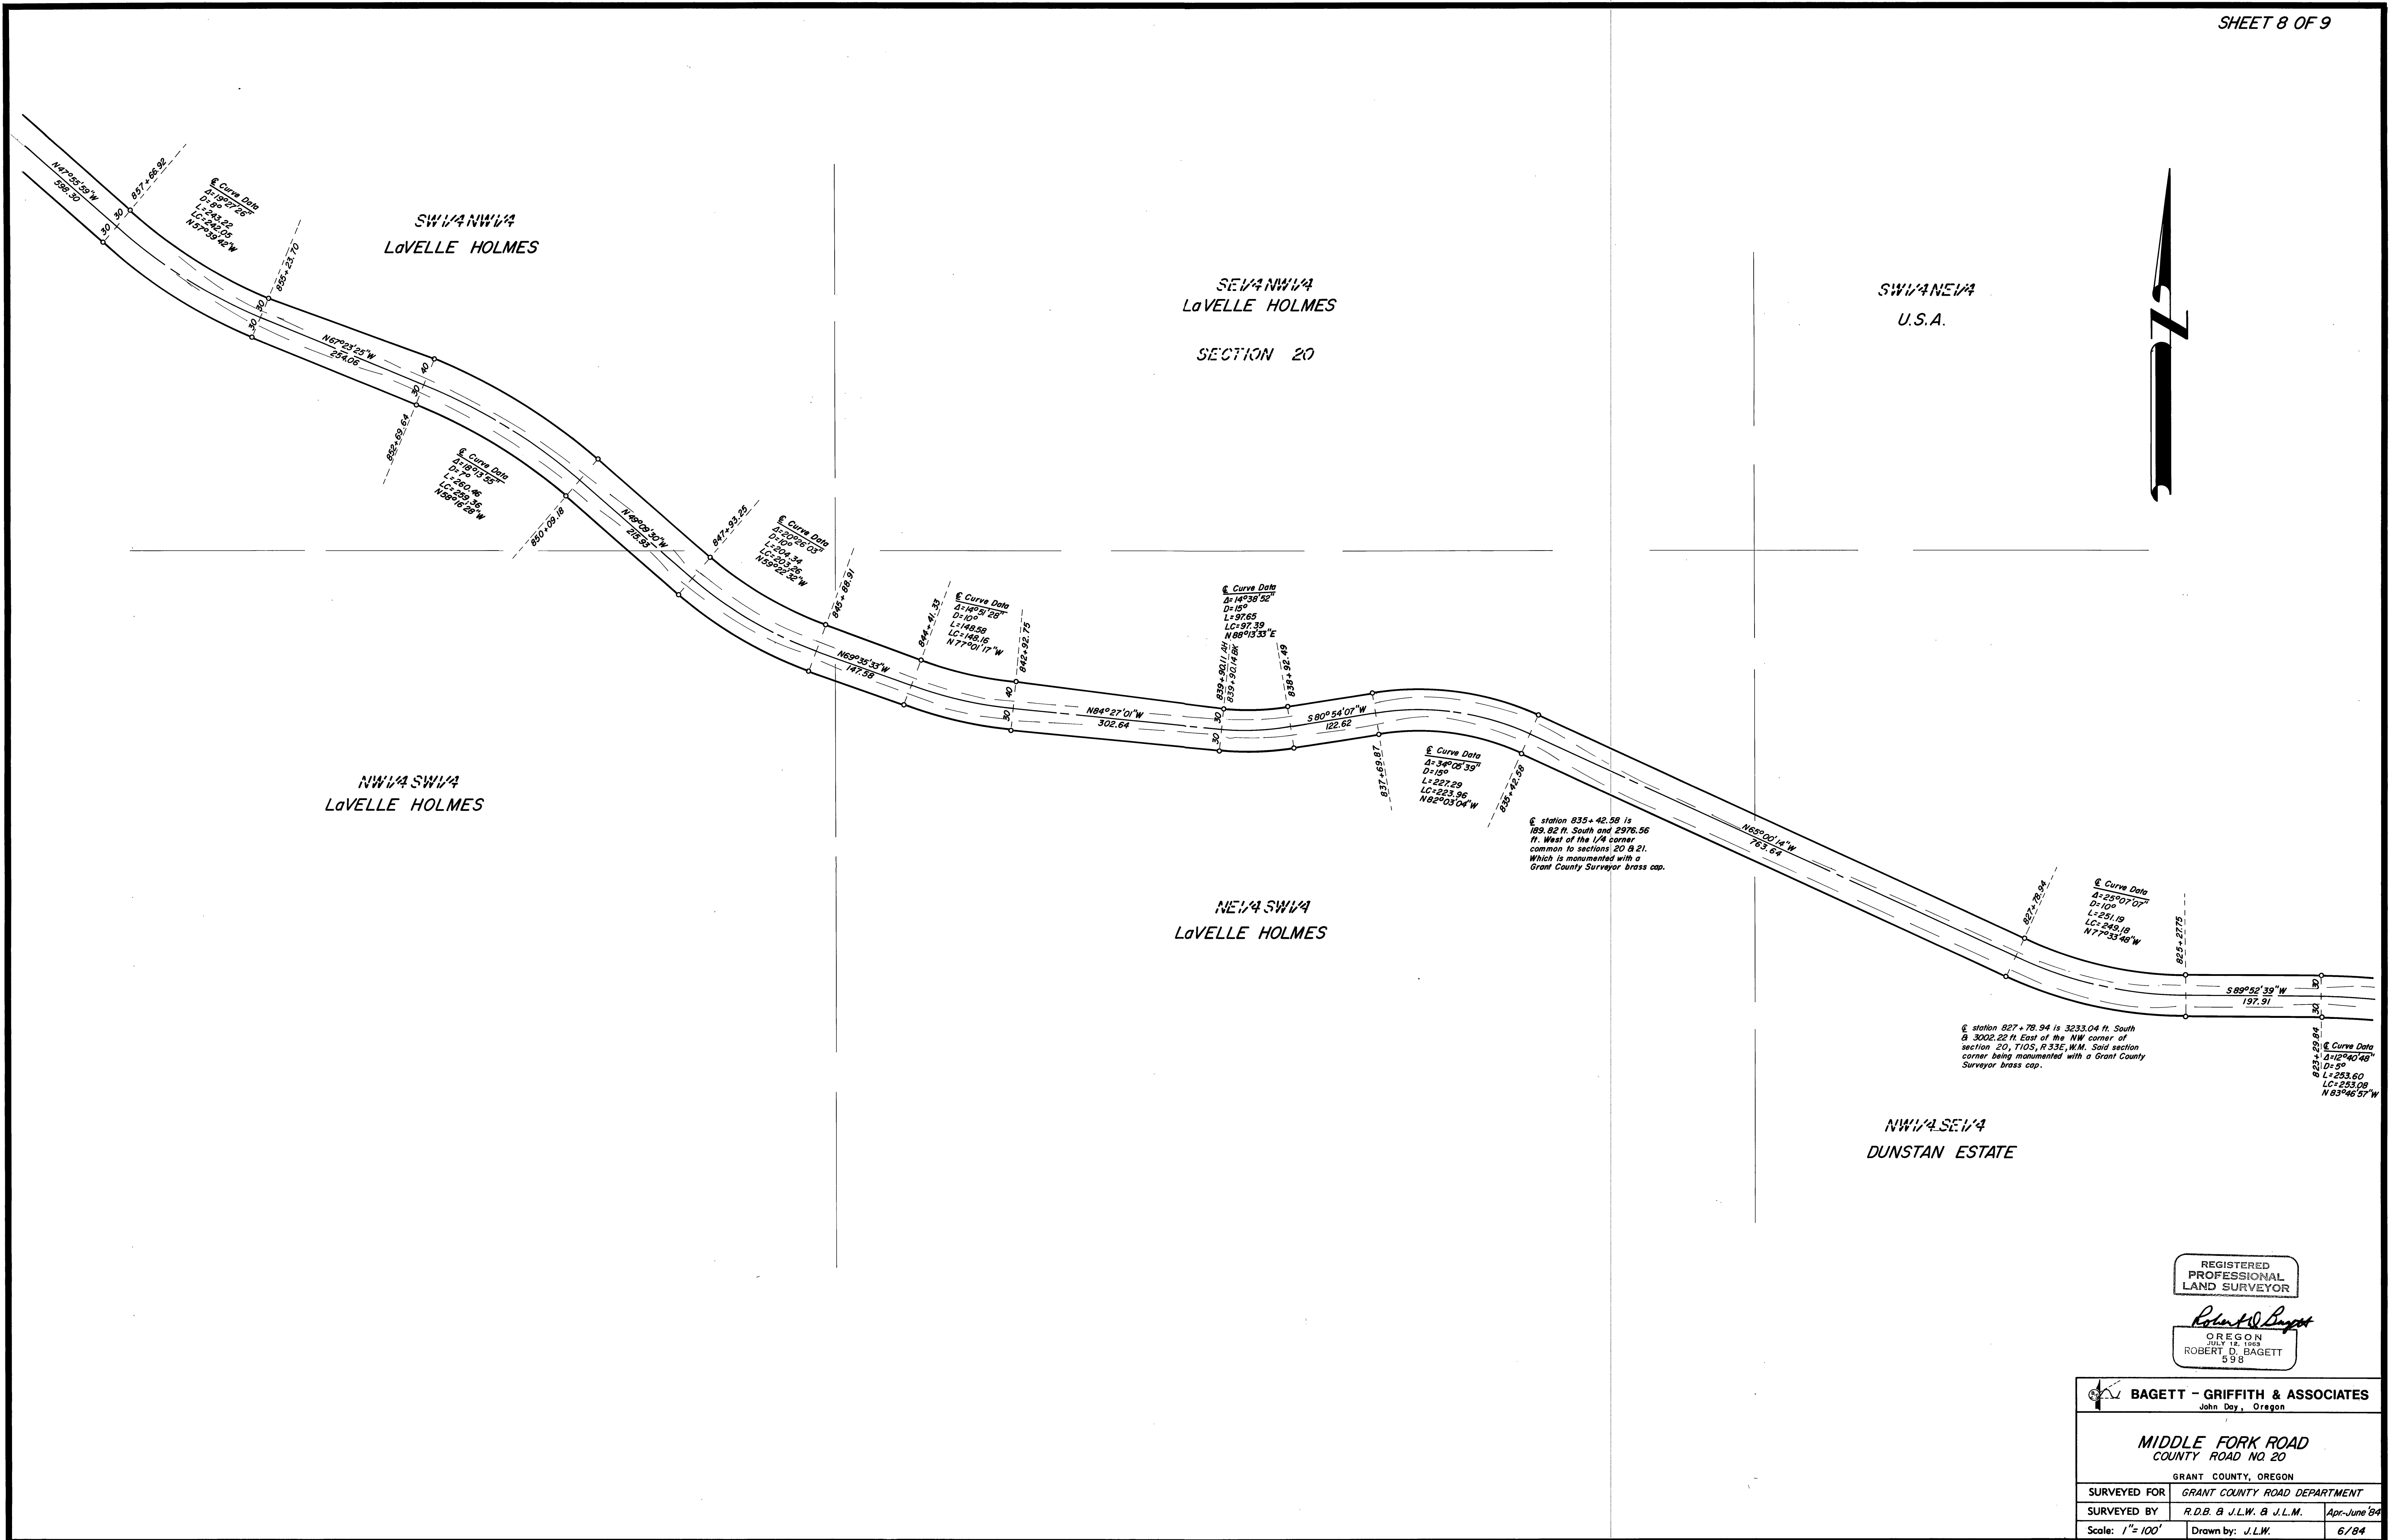

REGISTERED
PROFESSIONAL
LAND SURVEYOR

Robert D. Baggett
OREGON
ROBERT D. BAGGETT
598

BAGETT - GRIFFITH & ASSOCIATES John Day, Oregon		
MIDDLE FORK ROAD COUNTY ROAD NO. 20		
GRANT COUNTY, OREGON		
SURVEYED FOR	GRANT COUNTY ROAD DEPARTMENT	
Scale: 1"=100'	Drawn by: J.L.W.	6/84

RECORD MAP OF SURVEY NO. 820