



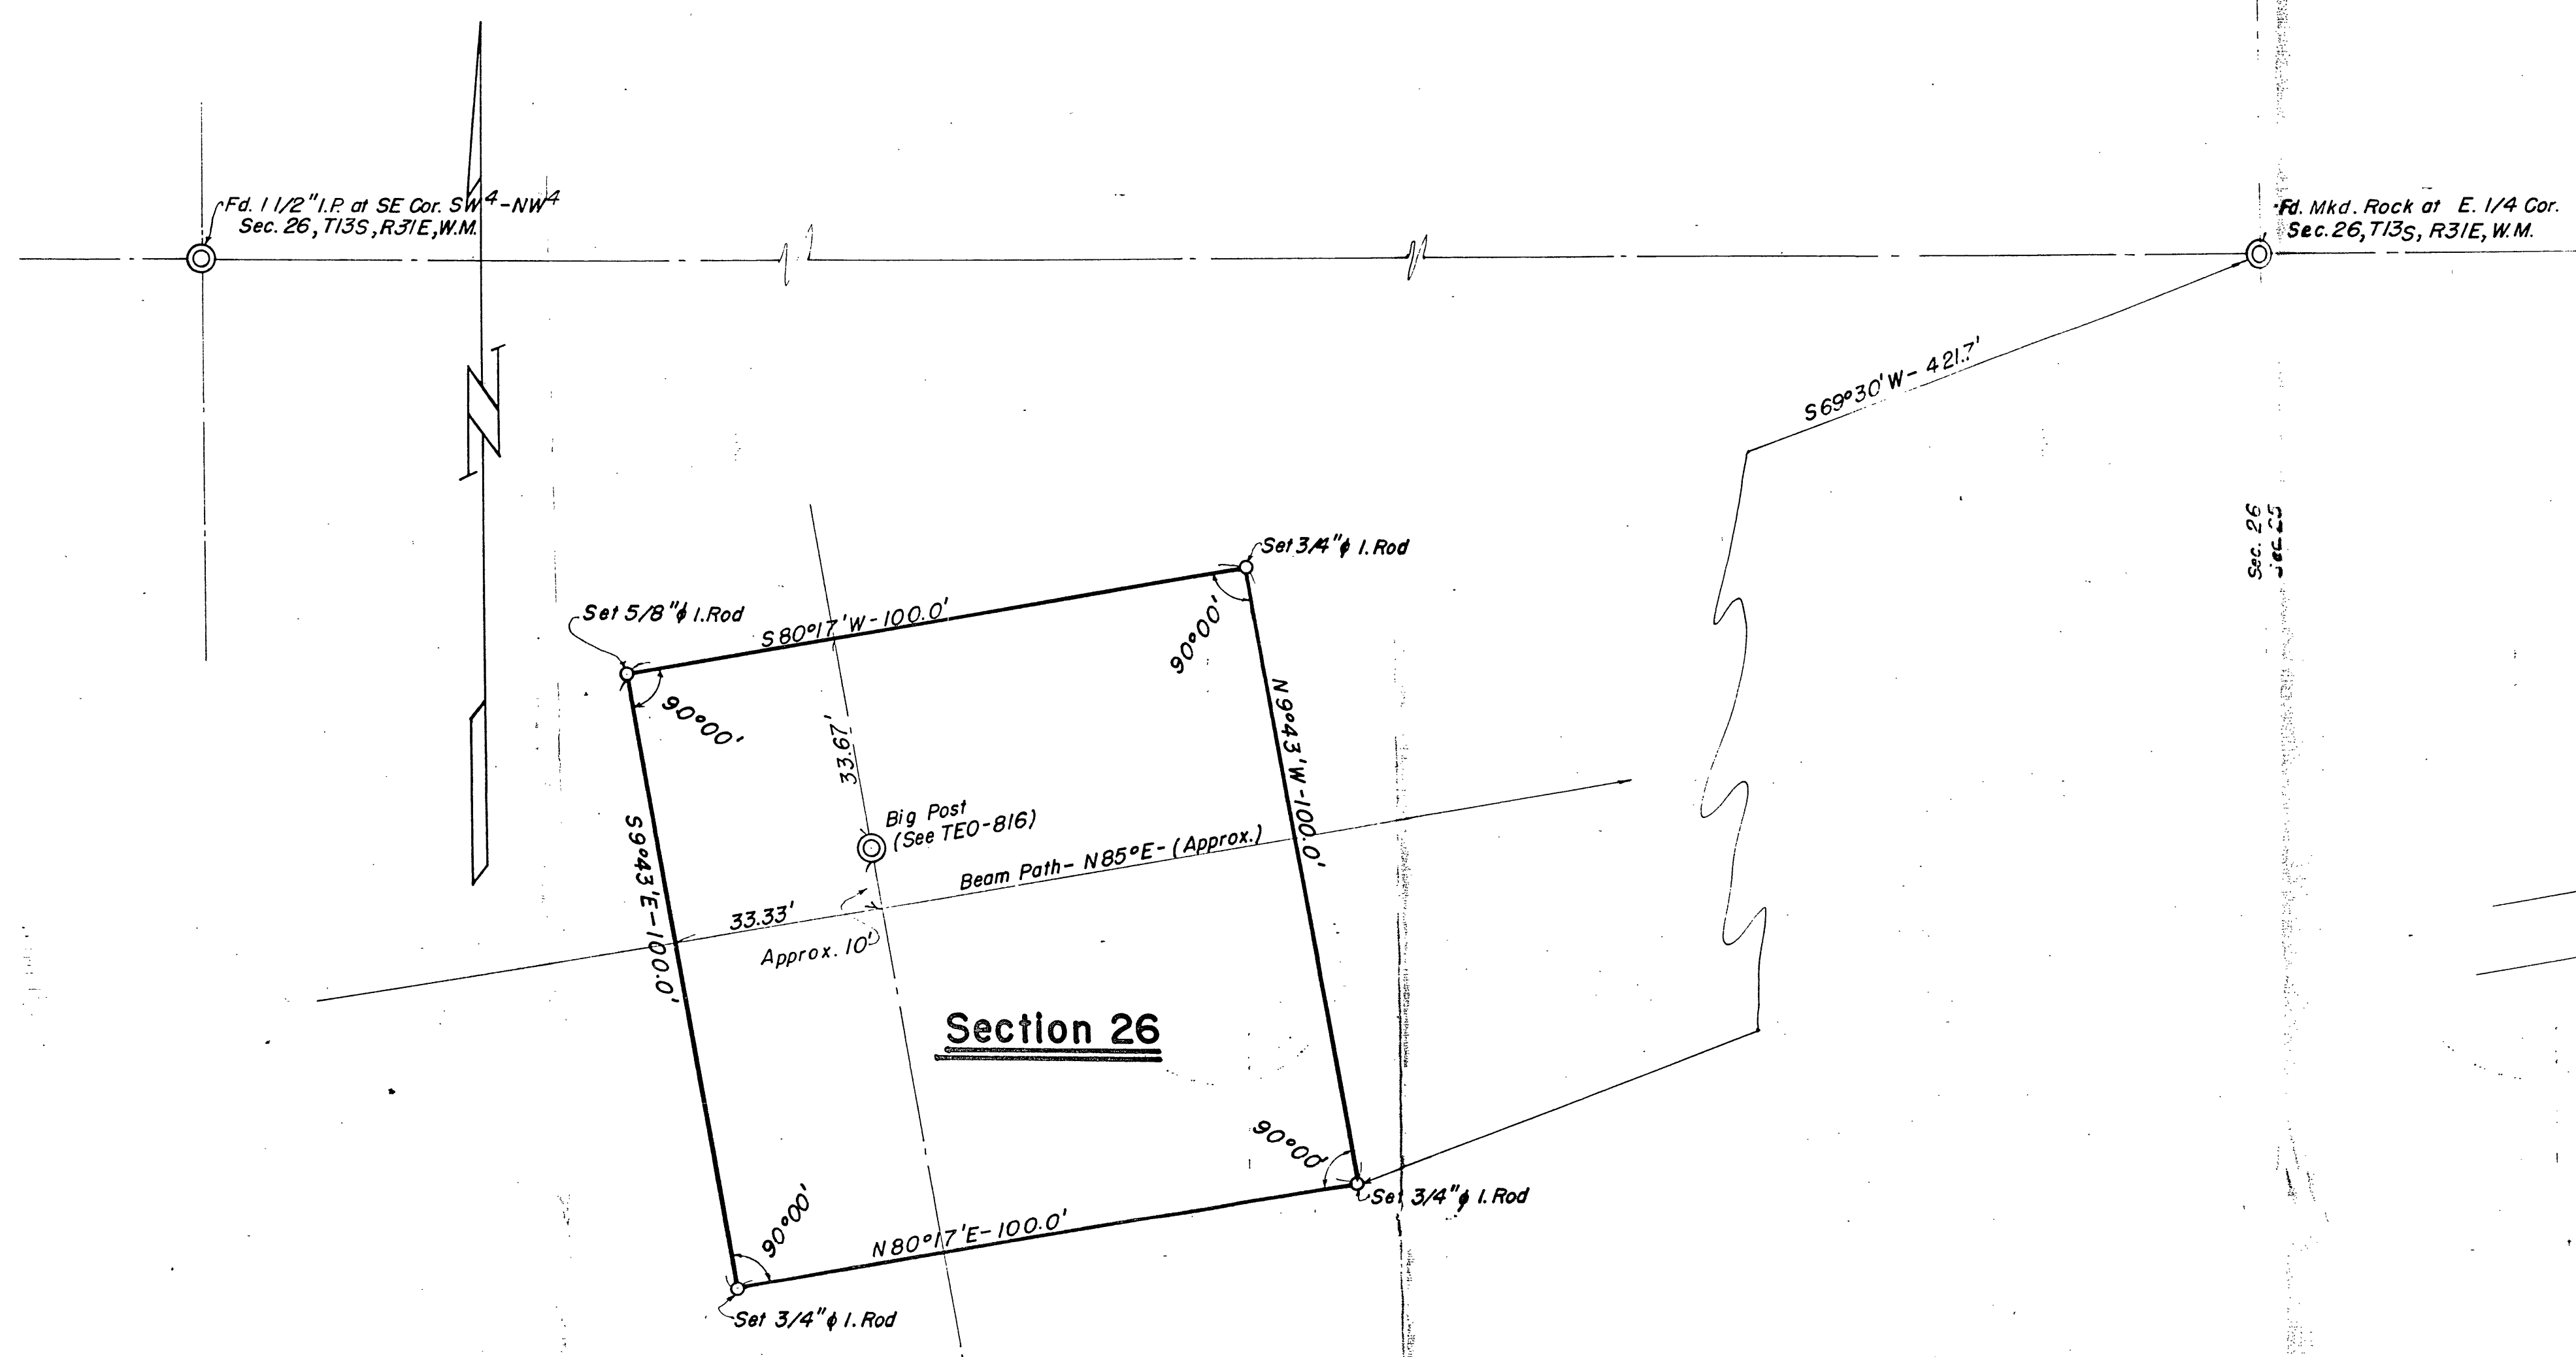


SURVEY
SCALE: $1" = 20'$

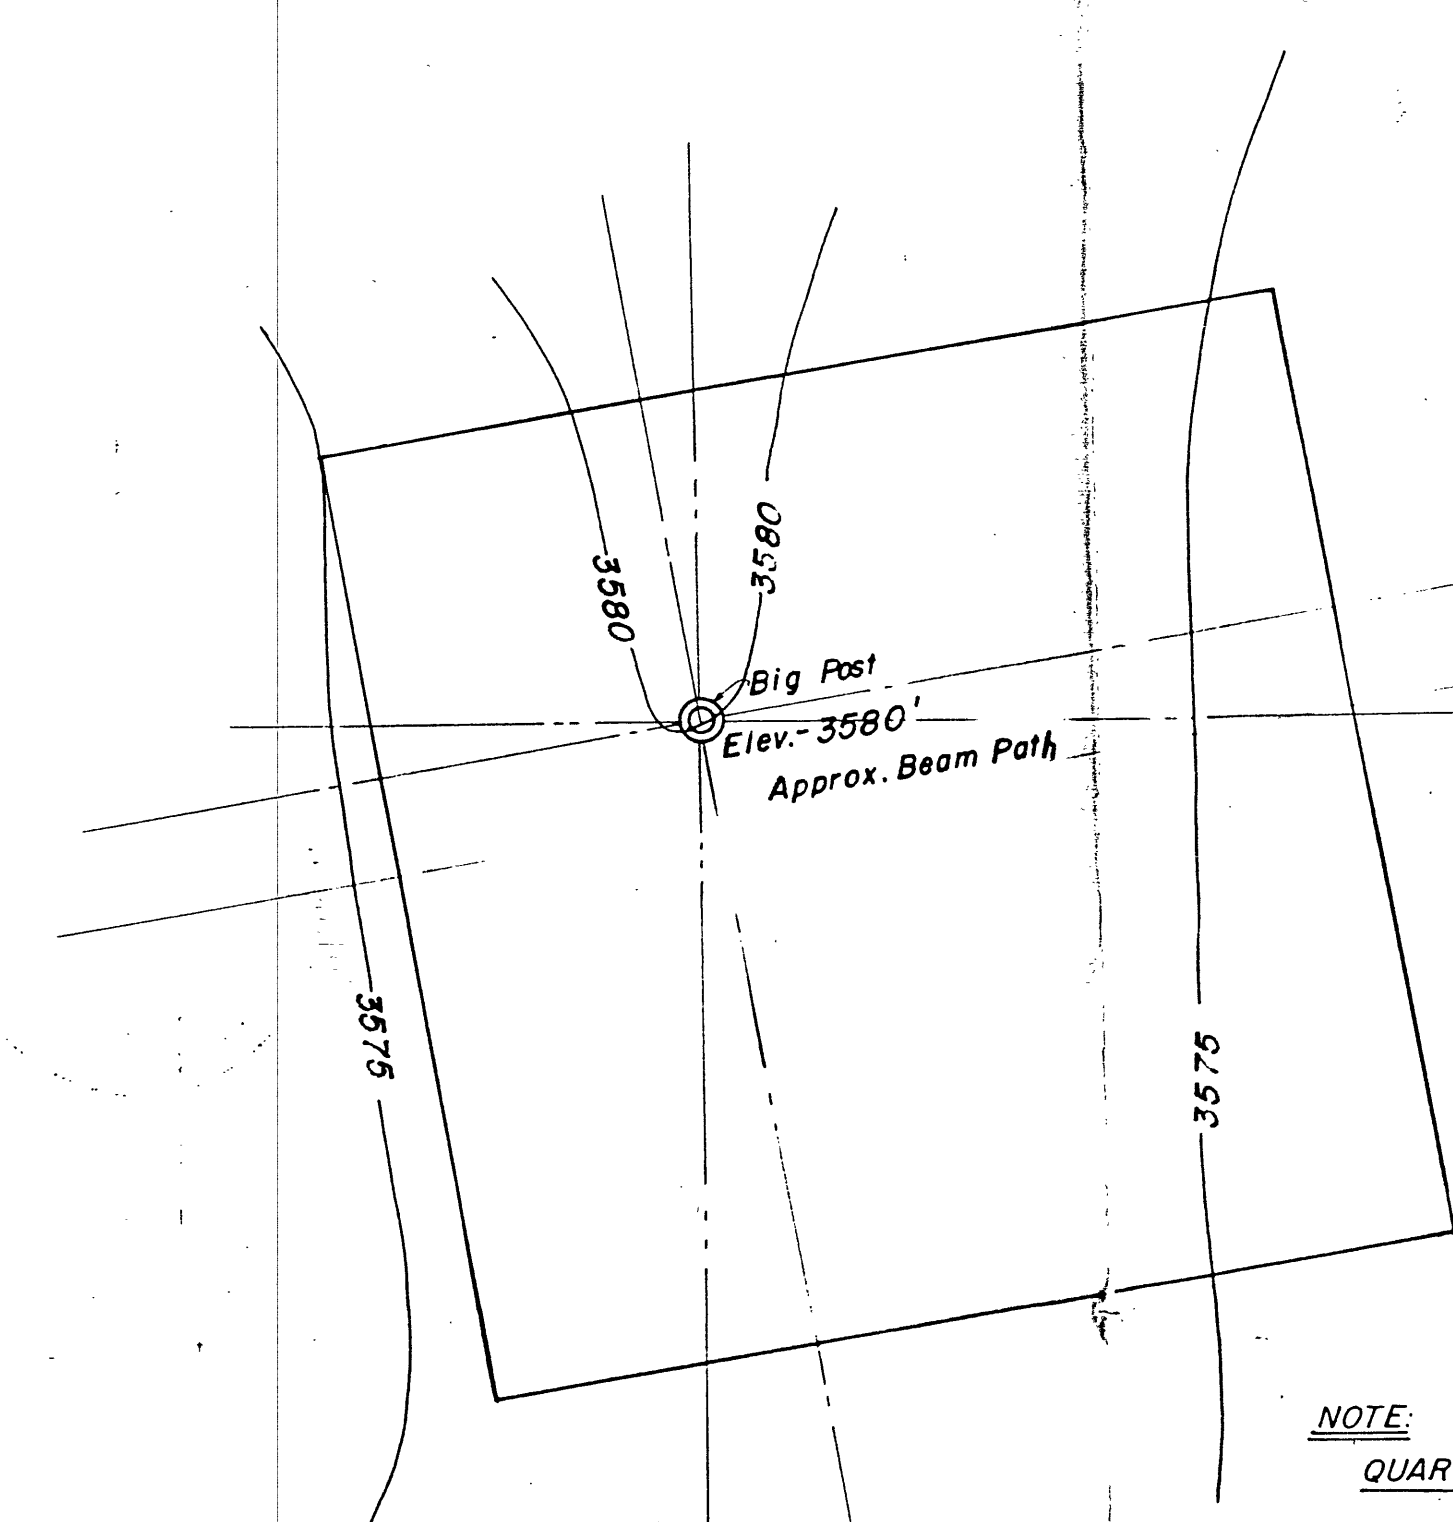

NOTE:
QUARTZ & BASALT Rock at undetermined Depth.

TOPOGRAPHY
SCALE: $1" = 20'$

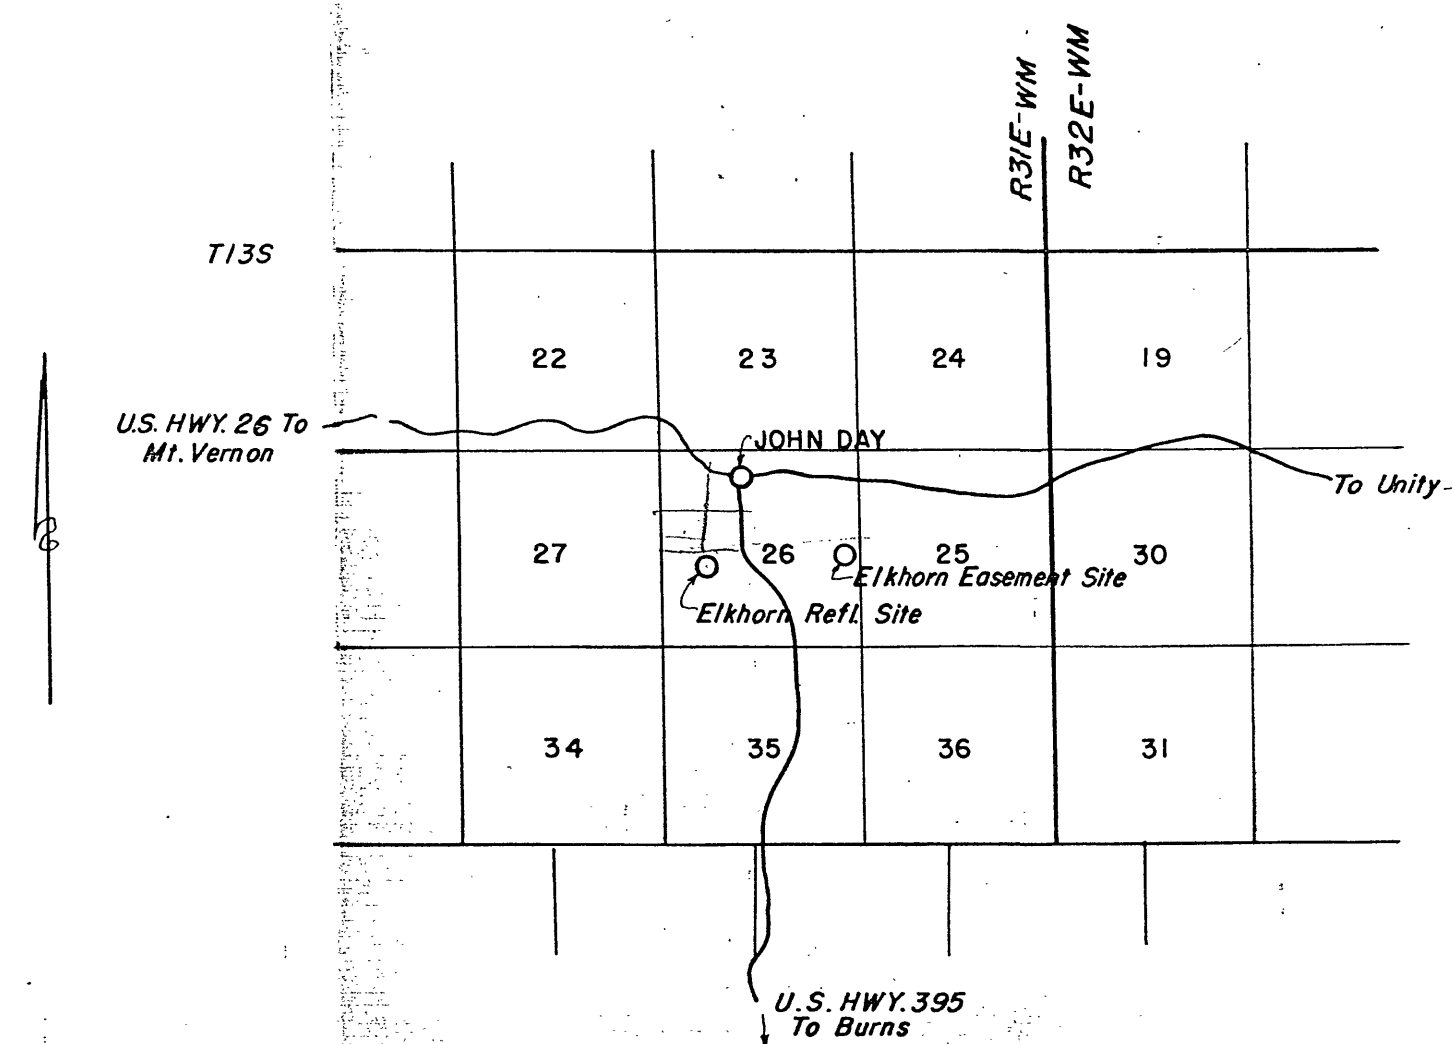

VICINITY MAP
SCALE: $1" = 1 \text{ Mile}$

John R. Gray R.P.E. 3352 359 N.E. 130 th. Place AL 4-7550 Portland 30, Oregon		
SURVEY & TOPOGRAPHY ELKHORN M.W.R. EASEMENT John Day, Grant County, Oregon		
Dr. by: <i>JRG</i>	11-15-58	1 of 1 JOB 58-9
Check by: <i>JRG</i>	11-15-58	