


TOWNSHIP 7 SOUTH, RANGE 35 EAST, W.M. GRANT COUNTY, OREGON
SECTIONS 10 & 11
PARTIAL SECTION BREAKDOWN

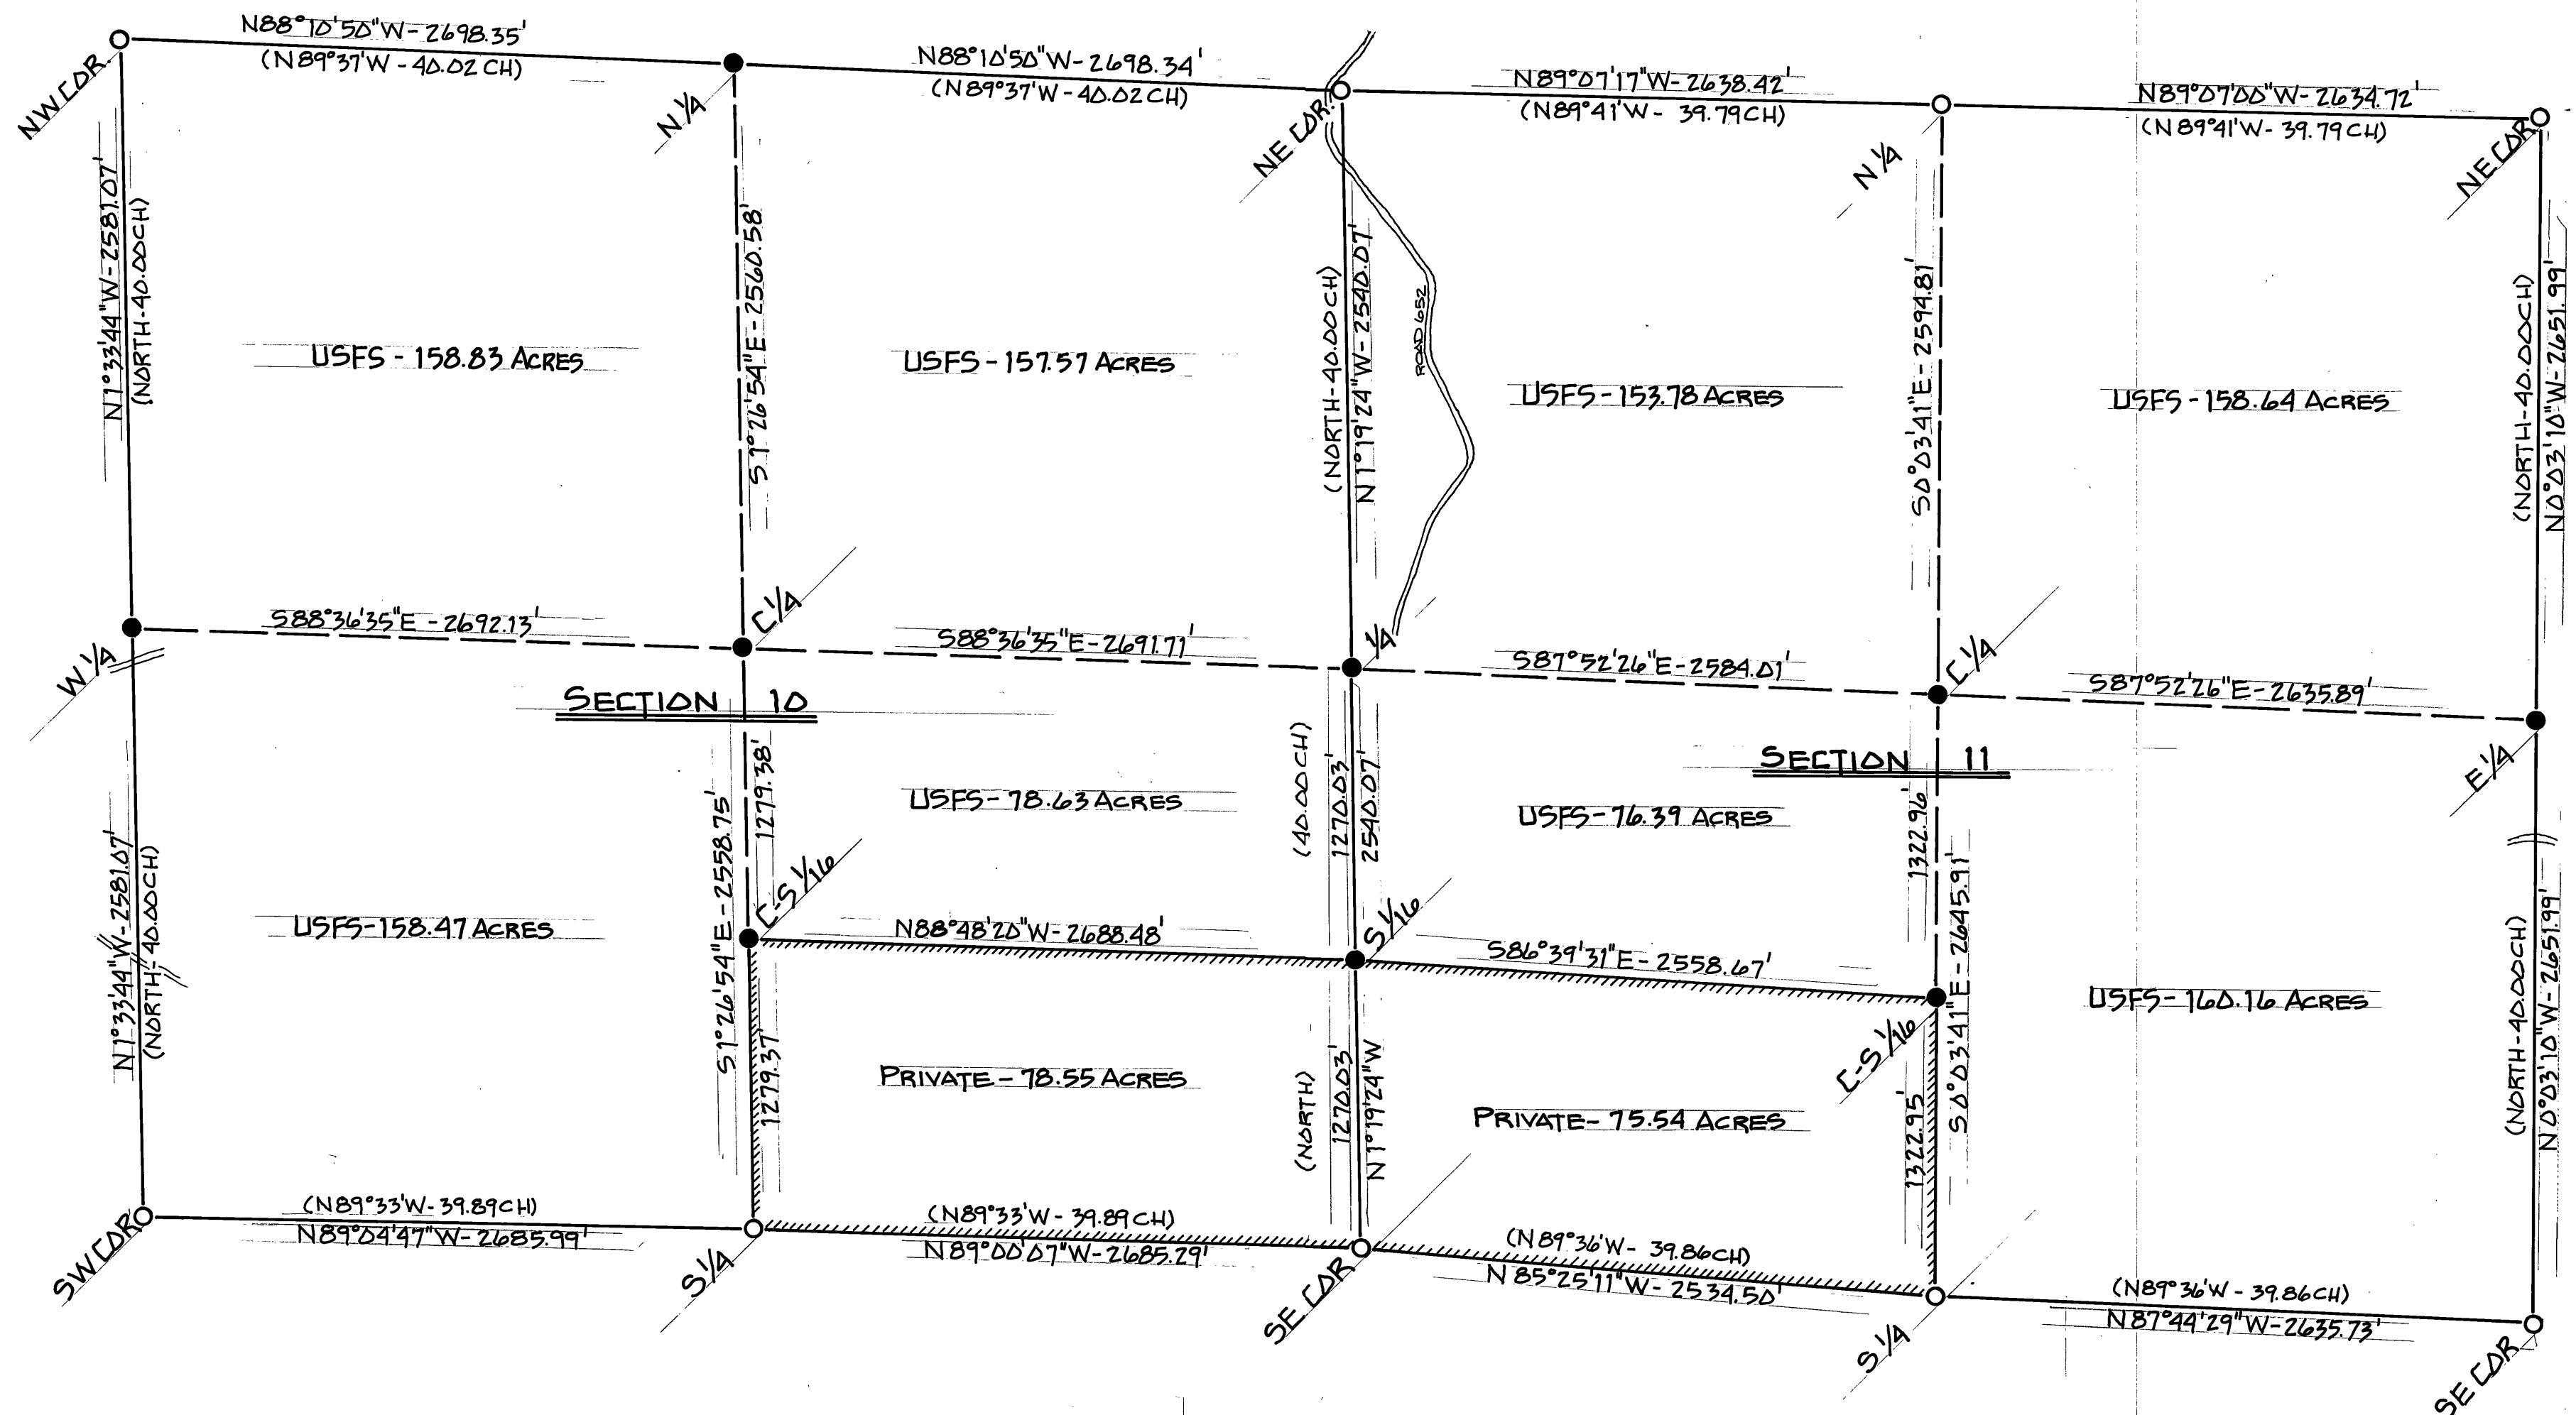

NARRATIVE OF SURVEY

FOR SURVEY NARRATIVE AND HISTORY OF PREVIOUS SURVEYS SEE SHEET 2 OF 3.

LEGEND

- SET 2 1/2" X 30" ALUM. PIPE WITH 2 1/2" ALUM. CAP FROM EXISTING ORIGINAL EVIDENCE.
- SET 2 1/2" X 30" ALUM. PIPE WITH 2 1/2" ALUM. CAP BY TRAVERSE SURVEY.
- NATIONAL FOREST BOUNDARY - BOUNDARY POSTED
- ROAD CROSSINGS ON TRAVERSE LINE.
- (XXX) RECORD BEARINGS AND DISTANCES.

NOTES

FOR ADDITIONAL INFORMATION ON CORNERS MONUMENTED SEE CERTIFIED RECORD OF LAND CORNER MONUMENTATION FORMS FILED HERewith.

FIELD BOOK REFERENCE - TRAVERSE BOOKS #1 THROUGH #5 AND MONUMENTATION BOOKS #6 AND #7.

SURVEYOR'S CERTIFICATION:

I, WILLIAM R. WELLS, A REGISTERED PROFESSIONAL LAND SURVEYOR IN THE STATE OF OREGON, HEREBY CERTIFY, THAT THIS PLAT AND THE NOTES HEREON ARE A CORRECT REPRESENTATION OF A SURVEY PERFORMED UNDER MY DIRECT SUPERVISION DURING THE MONTHS OF JUNE THROUGH OCTOBER, 1983, AT THE REQUEST OF USDA, FOREST SERVICE. SAID PLAT AND NOTES WERE PREPARED IN ACCORDANCE WITH THE STATUTES OF THE STATE OF OREGON AND THE ARTICLES OF THE CONTRACT.

William R. Wells
WILLIAM R. WELLS, PLS
OREGON LICENSE NO. 1106

REGISTERED
PROFESSIONAL
LAND SURVEYOR

William R. Wells
OREGON
JULY 22, 1977
WILLIAM R. WELLS
1106

SHEET 1 OF 3

RECEIVED AND
FILED

OCT 15 1984

OFFICE OF COUNTY SURVEYOR

Attest: Carol D. Gage, Co. Clerk

182.880M 300' 182.880M
1 Meter = 3.28083 Feet

BEARINGS ARE BASED ON SOLAR
OBSERVATION NEAR THE SE COR. OF
SECTION 14, T7S, R35E, W.M.

WILLIAM R. WELLS, PLS
LAND SURVEYING SERVICES
P.O. BOX 1696
PENDLETON, OREGON 97801
PHONE: 503 276 6362

PROJECT:
TROUT TRAIL 1983
CADASTRAL SURVEY

CONTRACT NO. 53-04R3-3-01345
S.N.D. R6-14-83-29

Date: 11-21-83
Dr. By: WRW
Ck. By: WRW
No: 3-12