



TOWNSHIP 7 SOUTH, RANGE 35 EAST, W.M. GRANT COUNTY, OREGON
SECTIONS 13 & 14
PARTIAL SECTION BREAKDOWN

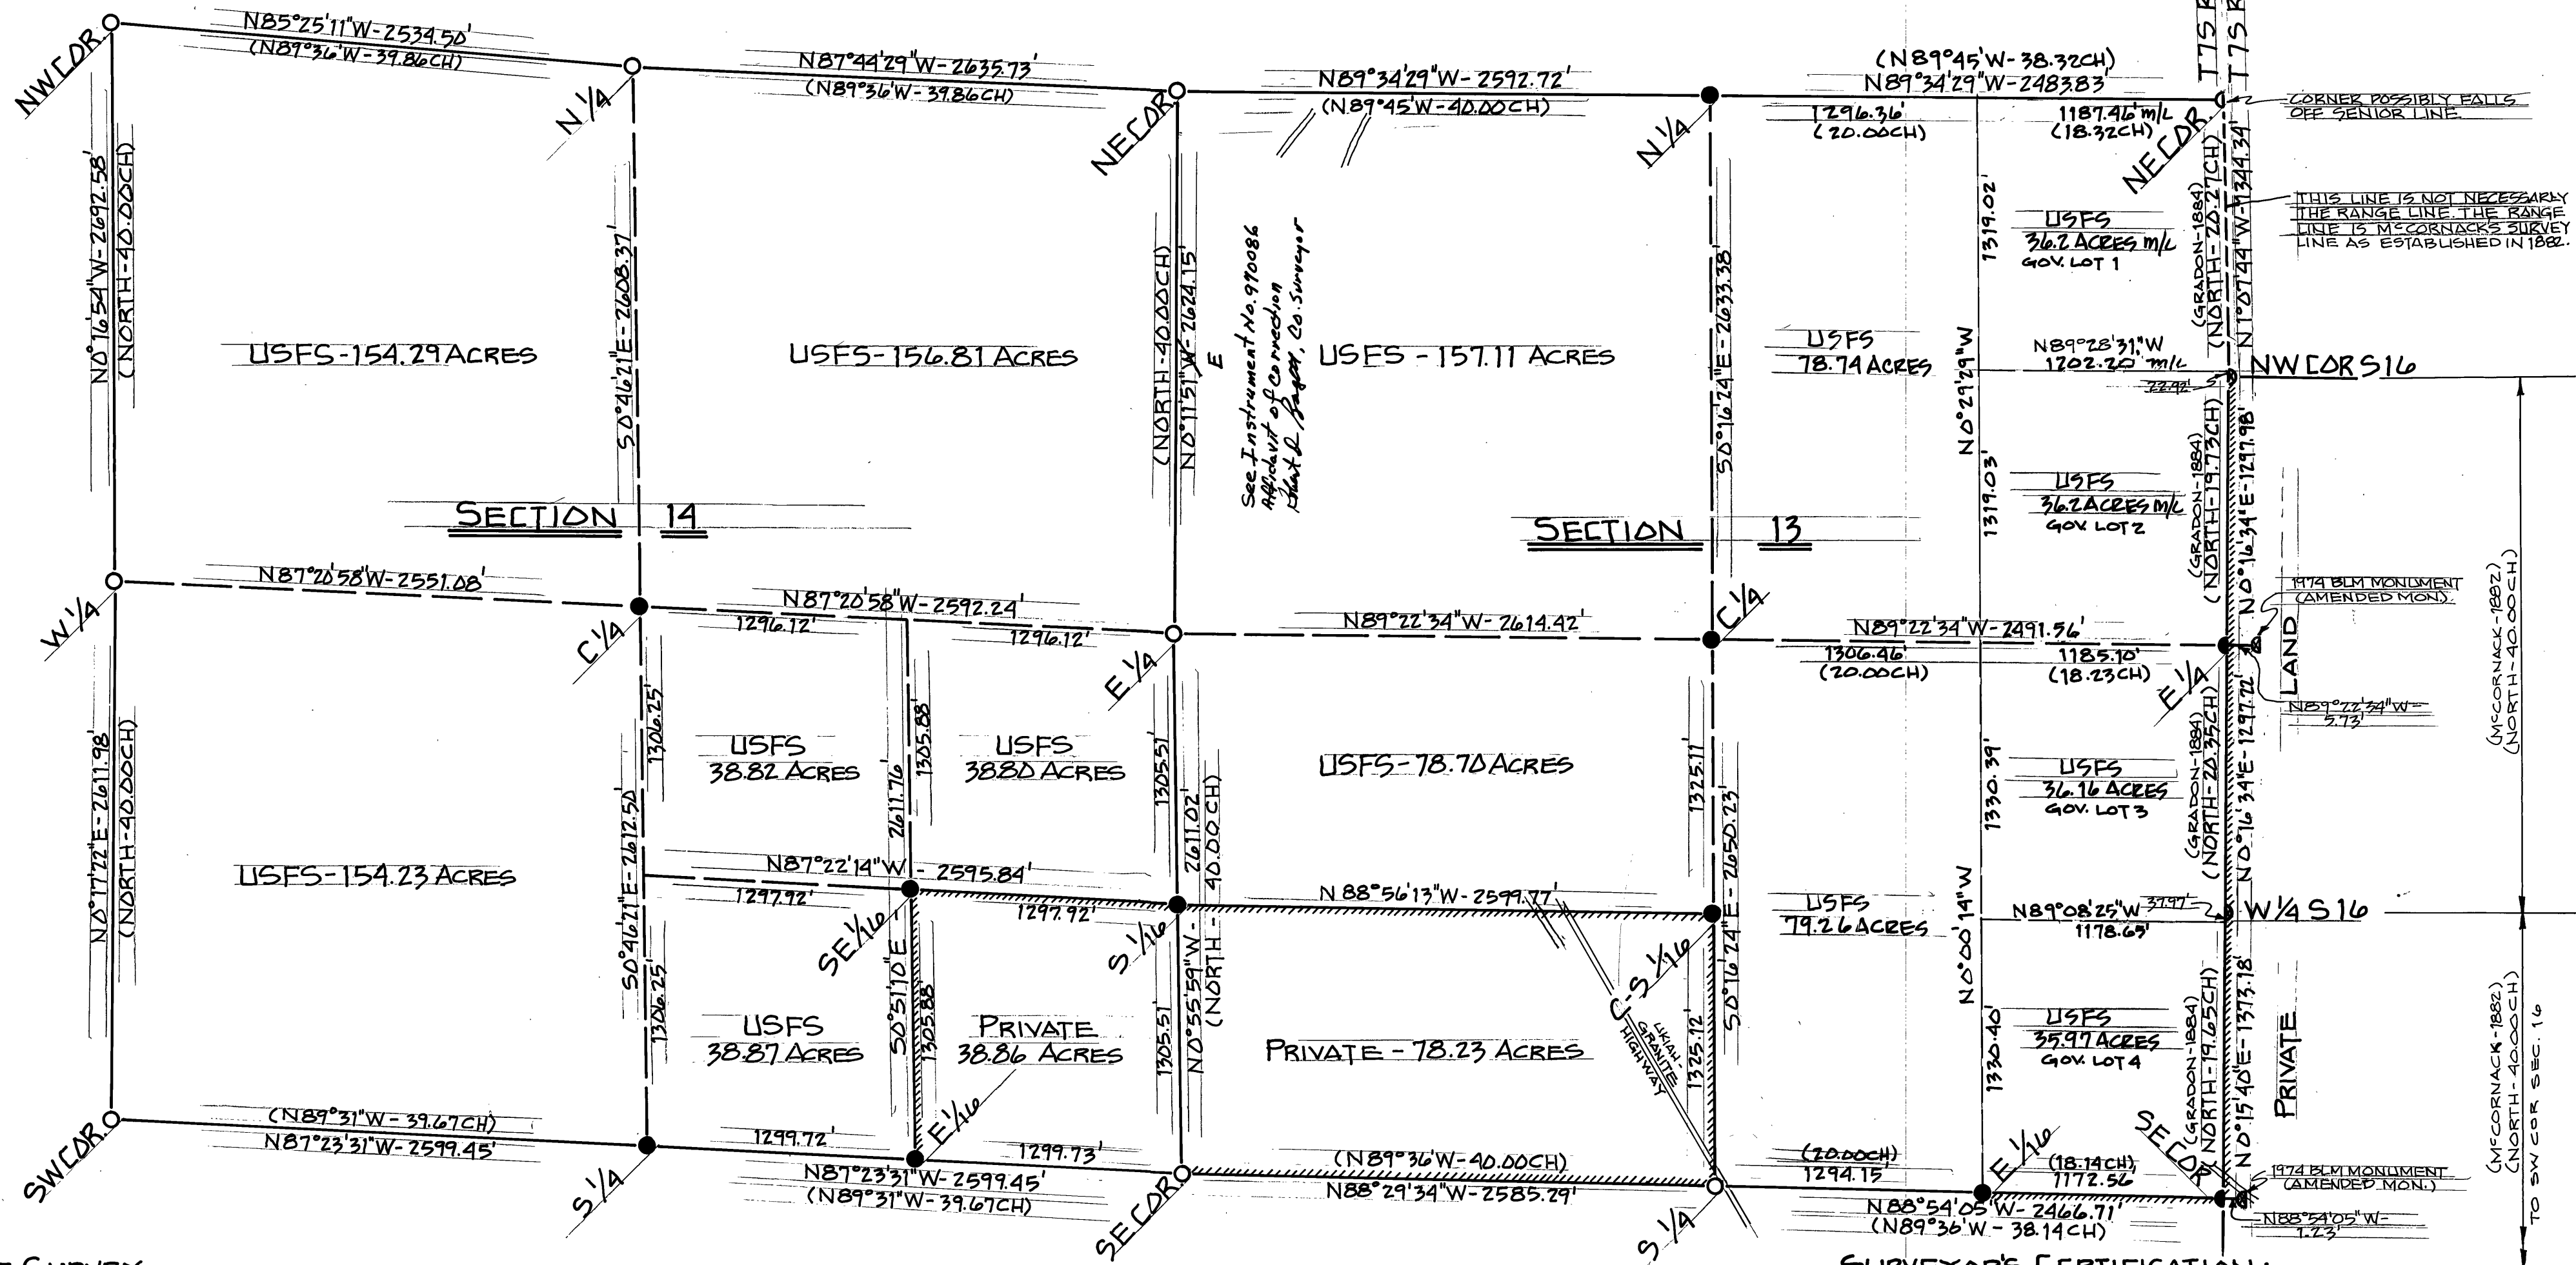

NARRATIVE OF SURVEY

THIS SURVEY INVOLVED PARTIAL SUBDIVISION OF SECTIONS 10, 11, 13, 14, 23 & 24 IN T 7 S, R 35 E, W. M.. ALSO INCLUDED WAS MONUMENTATION OF PORTIONS OF THE AUXILIARY MERIDIAN BETWEEN T 7 S, RANGES 35 AND 35 1/2 EAST, W.M. THE ORIGINAL SUBDIVISION OF T 7 S R 35 E, W.M. WAS PERFORMED BY HERMAN GRADOLIN UNDER CONTRACT NO. 494 DATED MARCH 1884. THE ORIGINAL SURVEY FOR THE AUXILIARY MERIDIAN BETWEEN T 7 S, R 35 AND 35 1/2 EAST WAS PERFORMED BY EUGENE MCCORNACK UNDER CONTRACT NO. 398 DATED JULY 2, 1882. FOR ADDITIONAL INFORMATION ON LOST CORNERS WHICH WERE REESTABLISHED, SEE FORMS R 6-7100-57 RECORDED AS PART OF THIS SURVEY. NATIONAL FOREST BOUNDARY WAS POSTED TO FOREST SERVICE STANDARDS AS SHOWN ON EACH MAP SHEET. ALONG THE AUXILIARY MERIDIAN BETWEEN T 7 S, R 35 AND 35 1/2 EAST WHERE JUNIOR CORNER MONUMENTS WERE LOCATED, A THEODOLITE LINE OR SURVEY LINE, A MONUMENT WAS SET AT THE TRUE INTERSECTION OF THE JUNIOR SURVEY LINE WITH THE SENIOR AUXILIARY MERIDIAN. JUNIOR CORNER MONUMENTS FALLING OFF THE SENIOR LINE WERE STAMPED "AM" FOR "AMENDED MONUMENT". OUR SURVEYS WERE PERFORMED WITH A 1" THEODOLITE, STEEL TAPE, AND INFA-RED DISTANCE MEASURING EQUIPMENT.

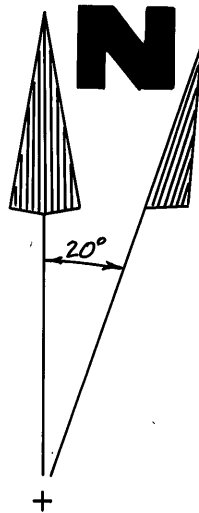



 182.880m Δ 300' 182.880m

1 METER = 3.28083 FEET

BEARINGS ARE BASED ON SOLAR
OBSERVATION NEAR THE S.E. COR. OF
SECTION 14, T7S, R35E, W.M.

LEGEND:

- SET 2 1/2" X 30" ALUM. PIPE WITH 2 1/2" ALUM. CAP FROM EXISTING ORIGINAL EVIDENCE.
 - SET 2 1/2" X 30" ALUM. PIPE WITH 2 1/2" ALUM. CAP BY TRAVERSE SURVEY.
 - ④ FOUND 3" BRASS CAP ON 2 1/2" GALV. I. PIPE SET BY BLM FROM EXISTING EVIDENCE.
- /// NATIONAL FOREST BOUNDARY- BOUNDARY POSTED.
- == ROAD CROSSINGS ON TRAVERSE LINE.
- (000) RECORD BEARINGS AND DISTANCES.

NOTES

FOR ADDITIONAL INFORMATION ON CORNERS MONUMENTED
SEE CERTIFIED RECORD OF LAND CORNER MONUMENTATION
FORMS FILED HEREWITH.

FIELD BOOK REFERENCE - TRAVERSE BOOKS #1
THROUGH #5 AND MONUMENTATION BOOKS #6 AND #7.

SURVEYOR'S CERTIFICATION:

I, WILLIAM R. WELLS, A REGISTERED PROFESSIONAL LAND SURVEYOR IN THE STATE OF OREGON, HEREBY CERTIFY THAT THIS PLAT, AND THE NOTES HEREON, ARE A CORRECT REPRESENTATION OF A SURVEY PERFORMED UNDER MY DIRECT SUPERVISION DURING THE MONTHS OF JUNE THROUGH OCTOBER, 1983, AT THE REQUEST OF USDA, FOREST SERVICE, SAID PLAT AND NOTES WERE PREPARED IN ACCORDANCE WITH THE STATUTES OF THE STATE OF OREGON AND THE ARTICLES OF THE CONTRACT.

William R. Wells
WILLIAM R. WELLS, PLS
OREGON LICENSE NO. 1106

**REGISTERED
PROFESSIONAL
LAND SURVEYOR**

William R. Wells
OREGON
JULY 22, 1977
WILLIAM R. WELLS
1106

SHEET 2 OF 3

WILLIAM R. WELLS, PLS
LAND SURVEYING SERVICES
P.O. BOX 1696
PENDLETON, OREGON 97801
PHONE : 503 276 6362

PROJECT:
TROUT TRAIL 1983
CADASTRAL SURVEY

CONTRACT NO. 53-04R3-3-01345
S. NO. R6-14-83-29

Date: 6-10-84
11-22-83

Ck.By: WRW

Dr.By:	WRW
No:	3-12

RECEIVED AND
FILED

OCT 15 1984

OFFICE OF COUNTY SURVEYOR

Attest: Carol S. [Signature], Co. Clk.