


TOWNSHIP 7 SOUTH, RANGE 35 EAST, W.M. GRANT COUNTY, OREGON
SECTIONS 23 & 24
PARTIAL SECTION BREAKDOWN

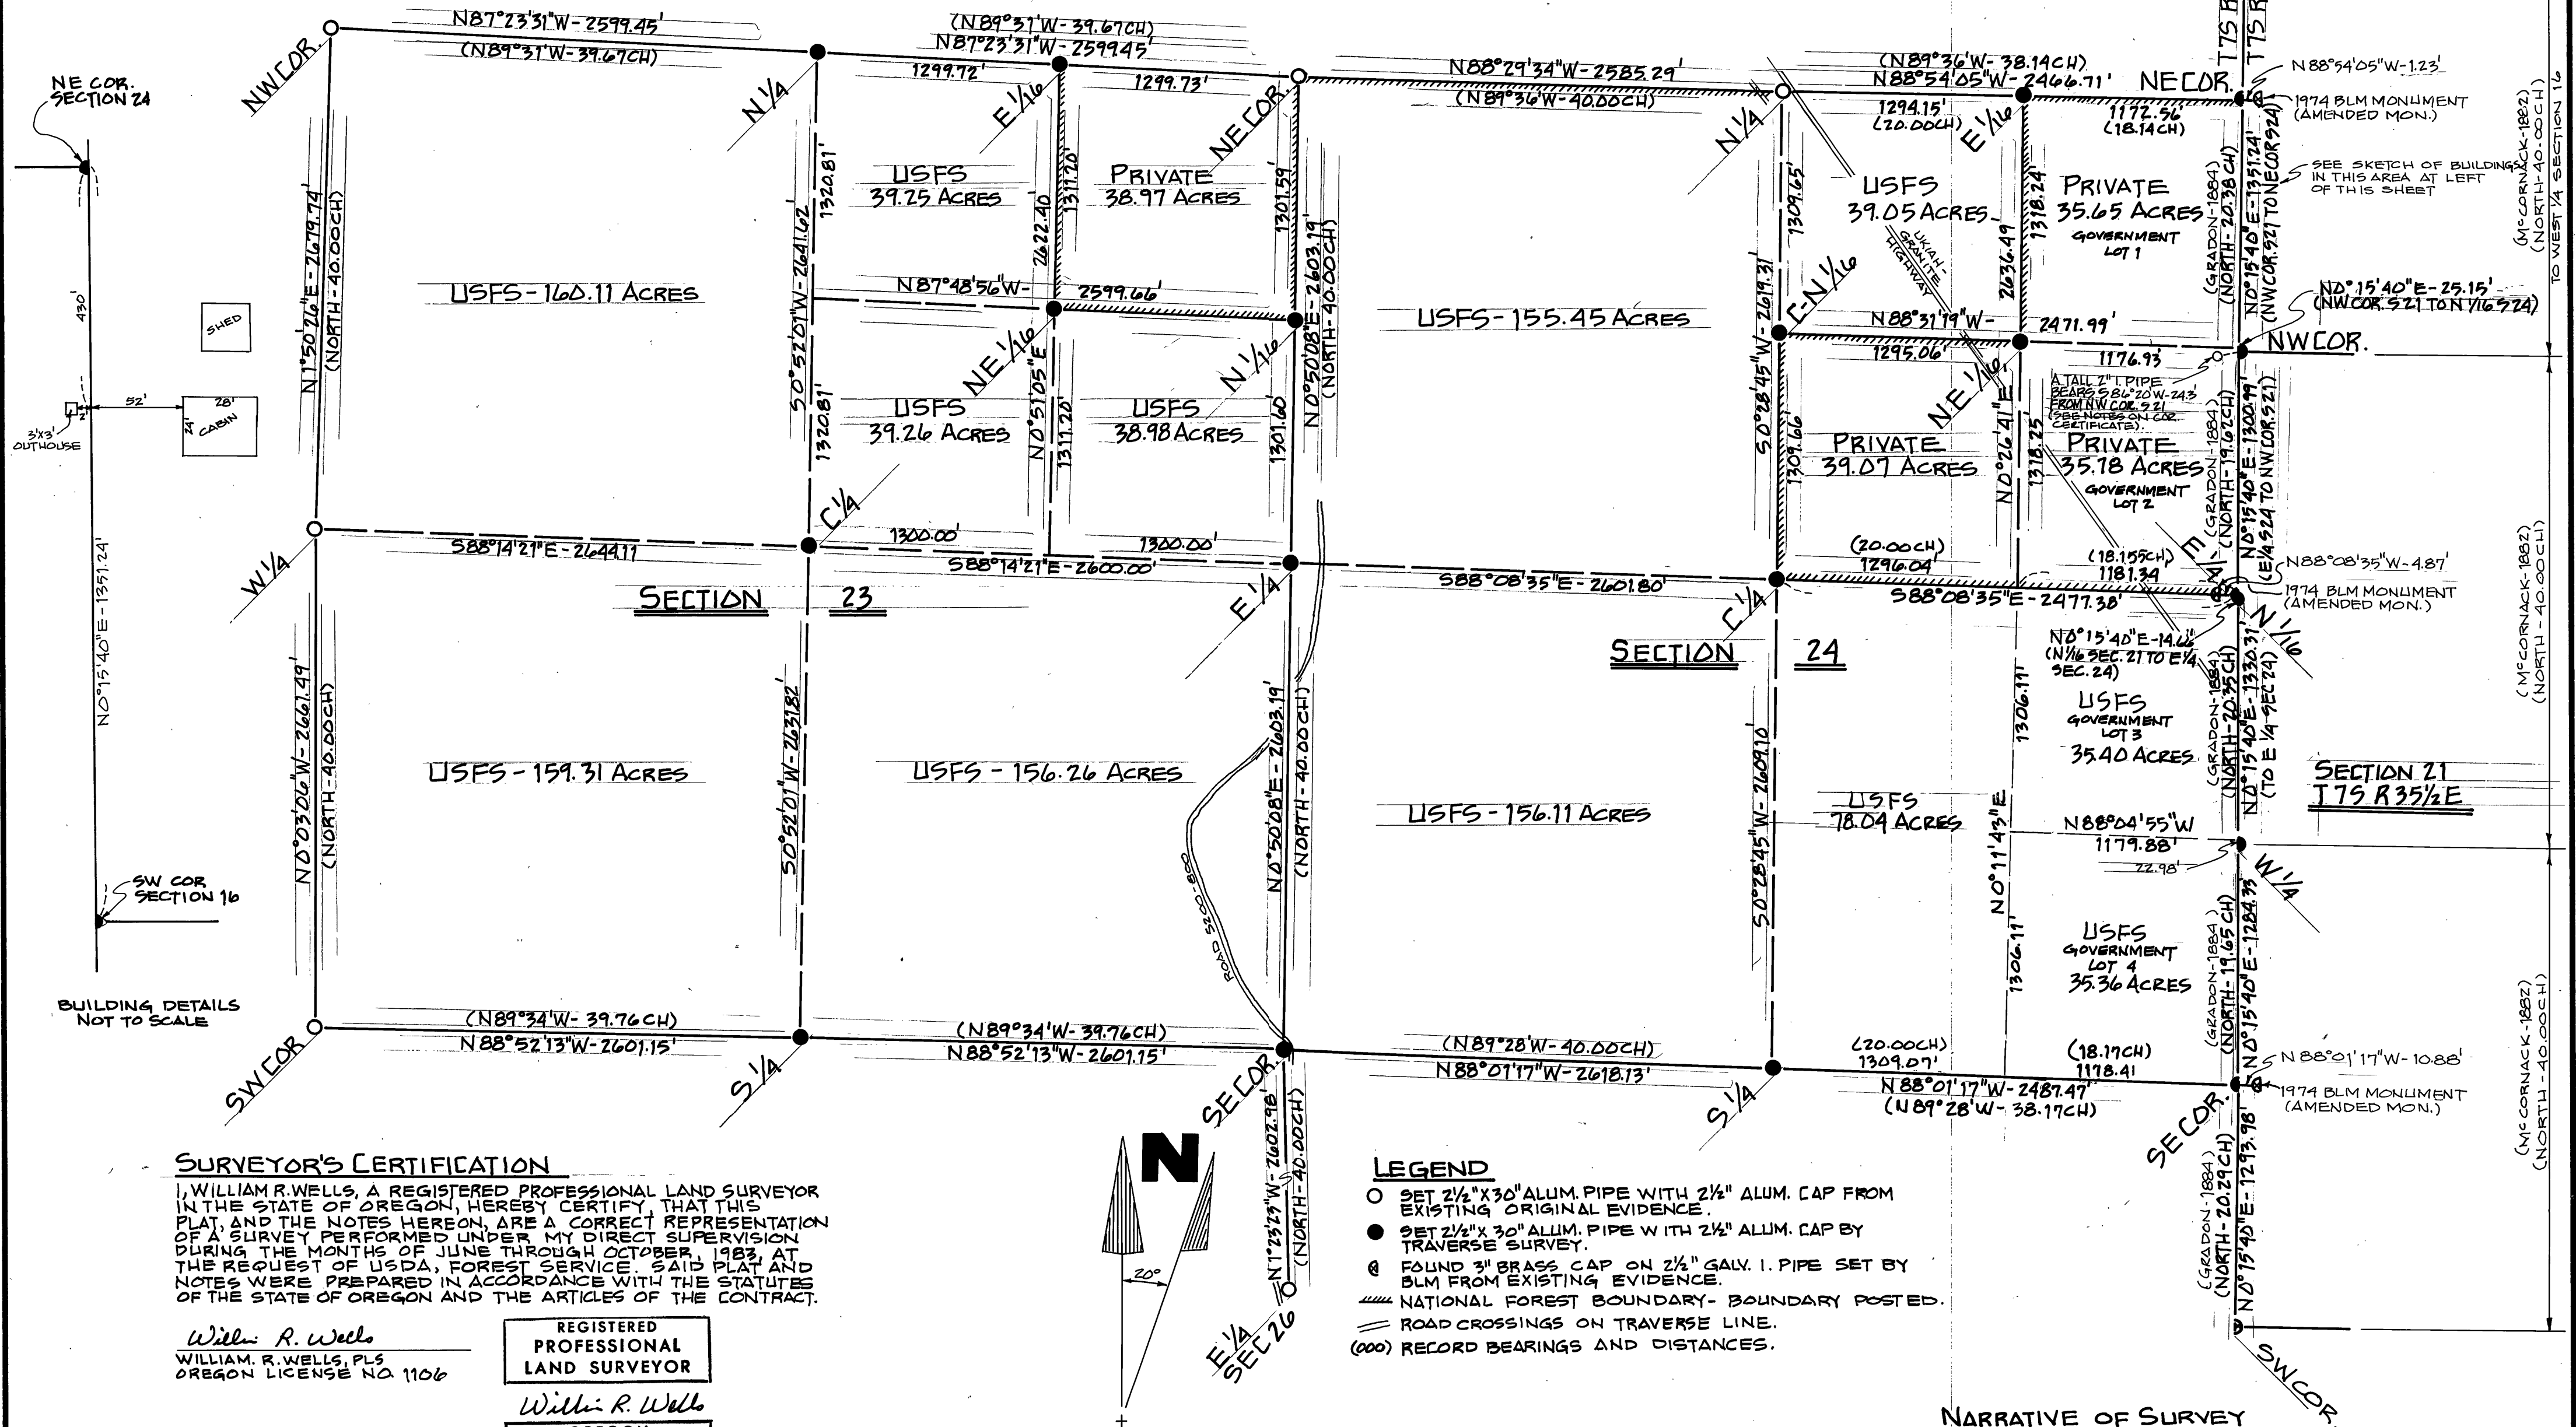

SURVEYOR'S CERTIFICATION

I, WILLIAM R. WELLS, A REGISTERED PROFESSIONAL LAND SURVEYOR IN THE STATE OF OREGON, HEREBY CERTIFY THAT THIS PLAT AND THE NOTES HEREON, ARE A CORRECT REPRESENTATION OF A SURVEY PERFORMED UNDER MY DIRECT SUPERVISION DURING THE MONTHS OF JUNE THROUGH OCTOBER, 1983, AT THE REQUEST OF USDA, FOREST SERVICE. SAID PLAT AND NOTES WERE PREPARED IN ACCORDANCE WITH THE STATUTES OF THE STATE OF OREGON AND THE ARTICLES OF THE CONTRACT.

William R. Wells
WILLIAM R. WELLS, PLS
OREGON LICENSE NO. 1106

REGISTERED
PROFESSIONAL
LAND SURVEYOR

William R. Wells
OREGON
JULY 22, 1977
WILLIAM R. WELLS
1106

LEGEND

- SET 2 1/2" X 30" ALUM. PIPE WITH 2 1/2" ALUM. CAP FROM EXISTING ORIGINAL EVIDENCE.
- SET 2 1/2" X 30" ALUM. PIPE WITH 2 1/2" ALUM. CAP BY TRAVERSE SURVEY.
- ⊕ FOUND 3/4" BRASS CAP ON 2 1/2" GALV. I. PIPE SET BY BLM FROM EXISTING EVIDENCE.
- ==== NATIONAL FOREST BOUNDARY- BOUNDARY POSTED.
- == ROAD CROSSINGS ON TRAVERSE LINE.
- (000) RECORD BEARINGS AND DISTANCES.

NOTES

FOR ADDITIONAL INFORMATION ON CORNERS MONUMENTED SEE FORMS RG-7100-57 FILED HEREWITH.

FIELD BOOK REFERENCE-TRAVERSE BOOK #1 THROUGH #5 AND MONUMENTATION BOOKS #6 AND #7.

NARRATIVE OF SURVEY

FOR SURVEY NARRATIVE AND HISTORY OF PREVIOUS SURVEYS SEE SHEET 2 OF 3.

SHEET 3 OF 3

**RECEIVED AND
FILED**

OCT 15 1984

OFFICE OF COUNTY SURVEYOR

Robert D. Bessert
Attest: Carol D. Co. clk.

WILLIAM R. WELLS, PLS
LAND SURVEYING SERVICES
P.O. BOX 1696
PENDLETON, OREGON 97801
PHONE: 503 276 6362

Date: 6-10-84
11-23-83
Dr. By: WRW
No: 3-12
Ck. By: WRW

PROJECT:
TROUT TRAIL 1983
CADASTRAL SURVEY

CONTRACT NO. 53-0483-3-01345
S. NO. RG-14-83-29