
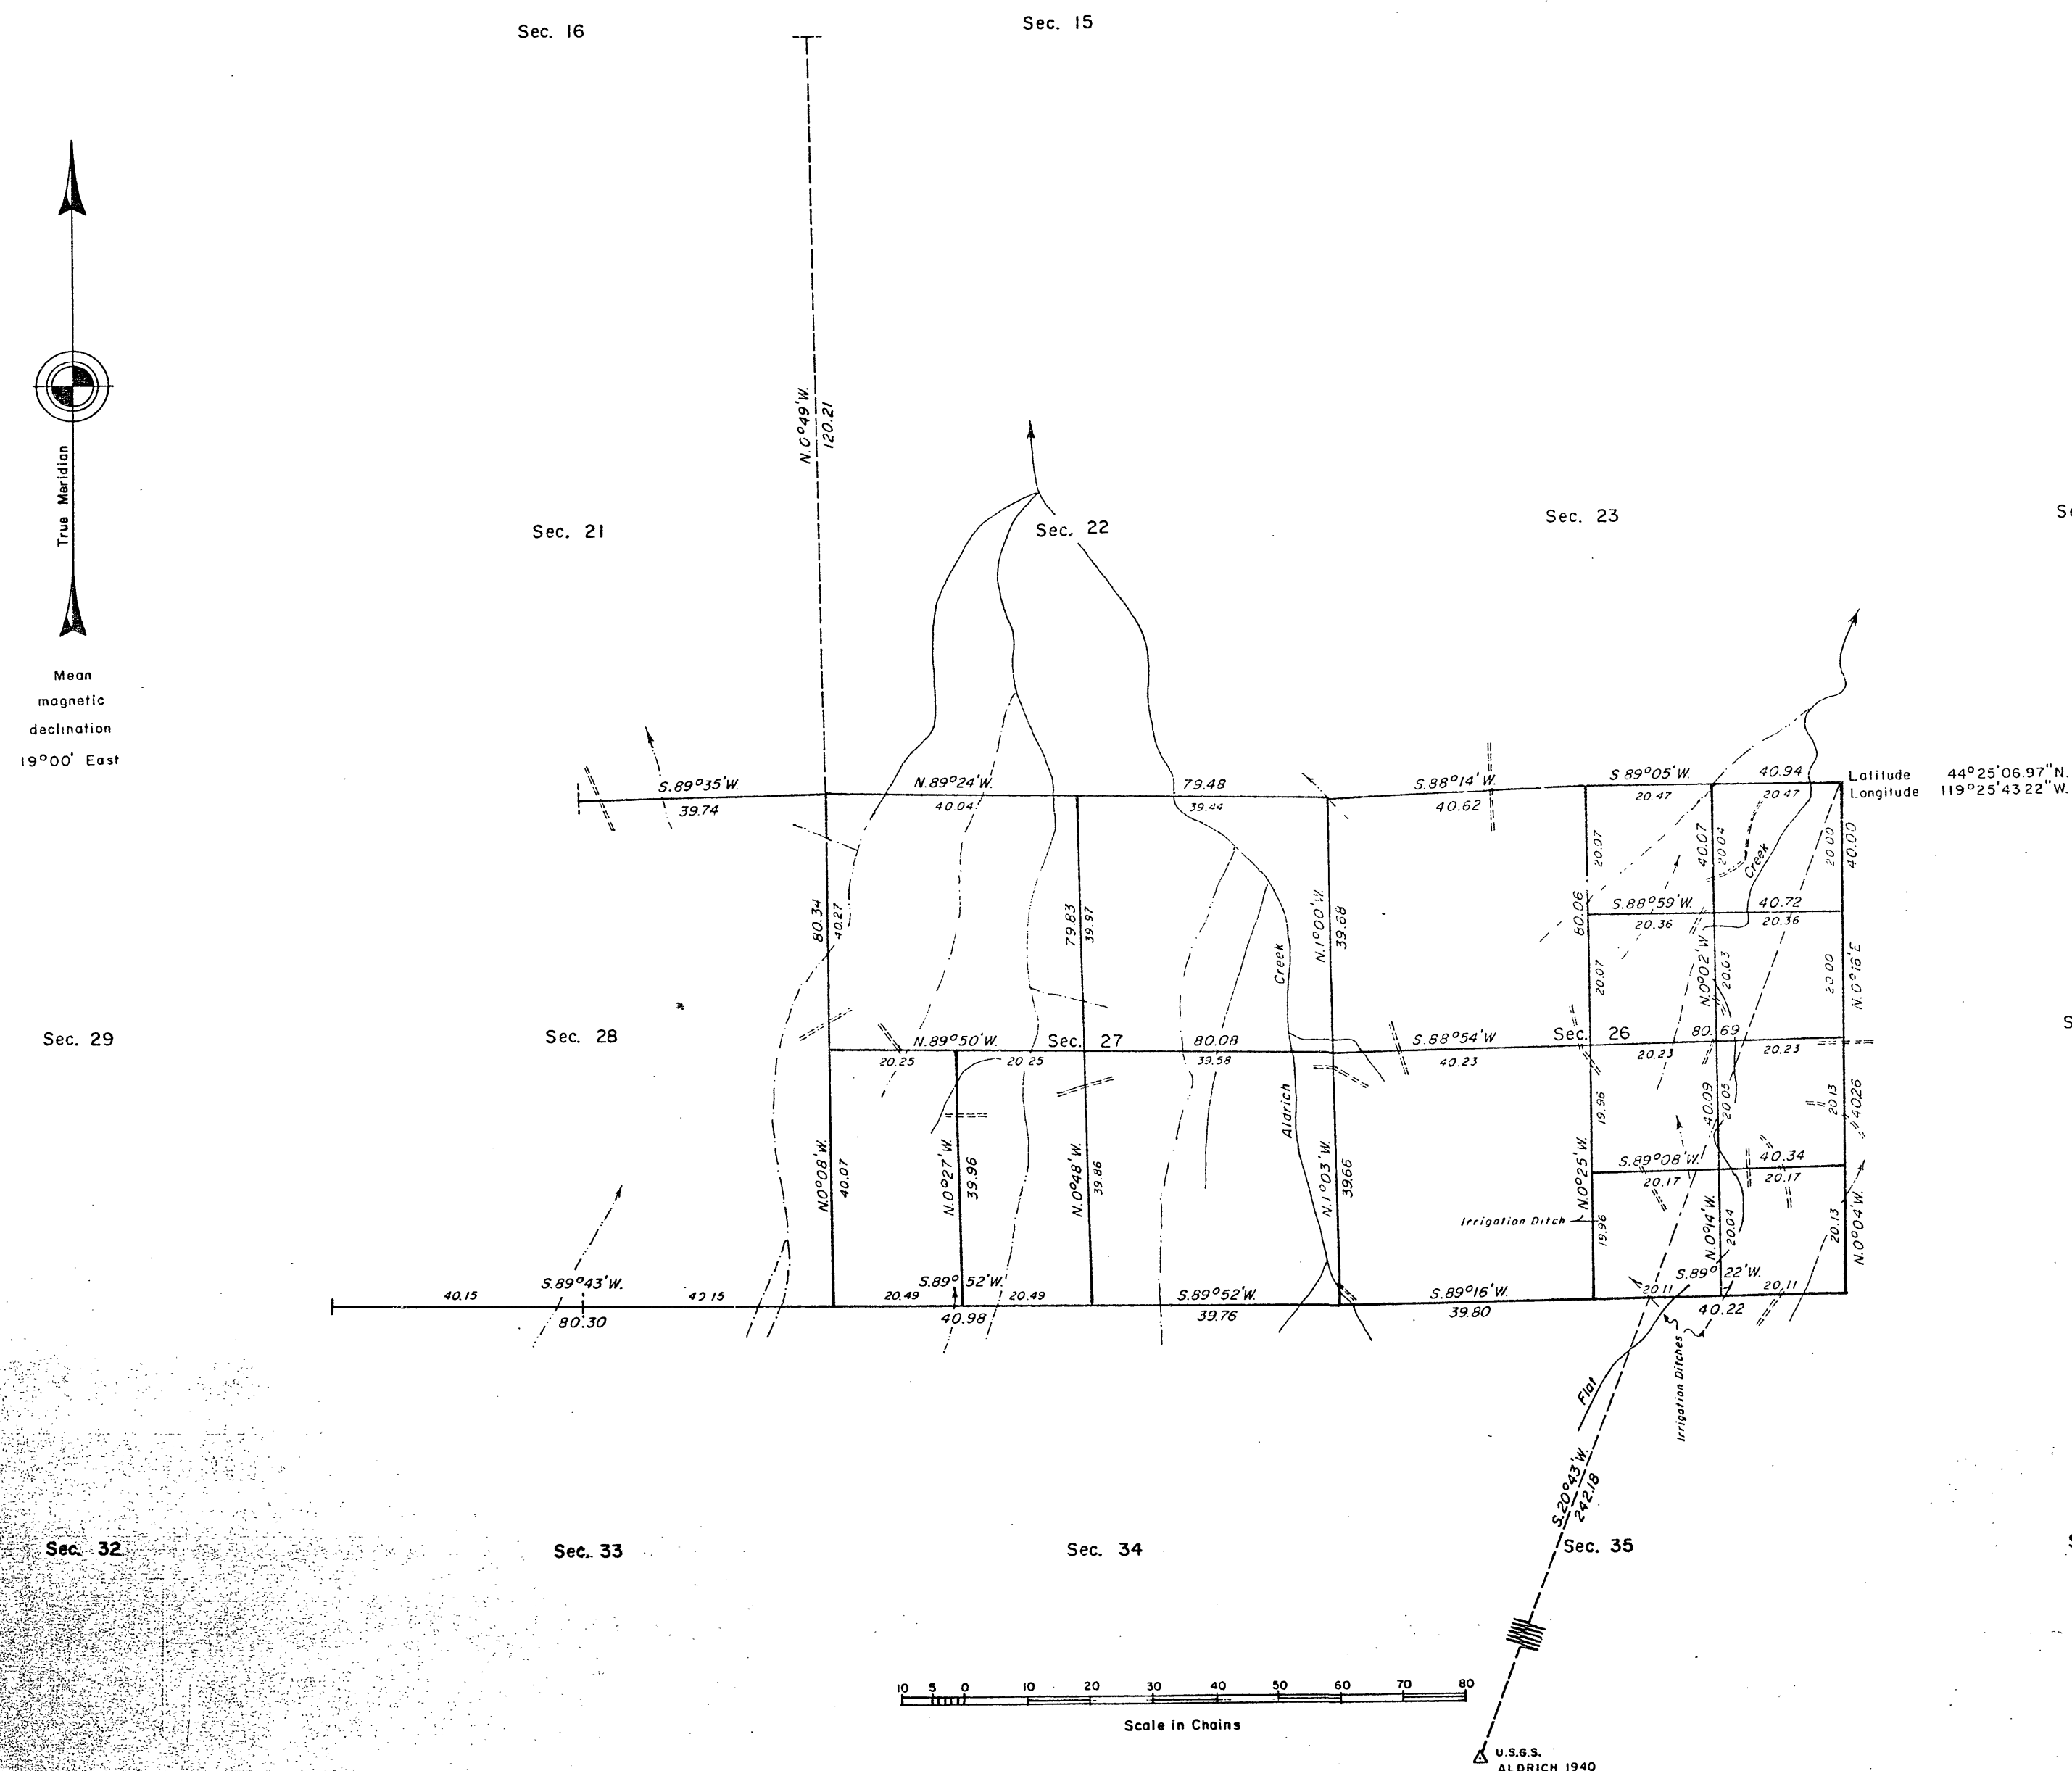


TOWNSHIP 13 SOUTH, RANGE 27 EAST, OF THE WILLAMETTE MERIDIAN, OREGON.

DEPENDENT RESURVEY AND SUBDIVISION OF SECTIONS 26 AND 27

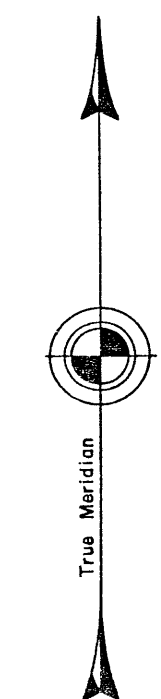

A history of surveys is contained in the field notes.

This plat represents a dependent resurvey of a portion of the subdivisional lines, T. 13 S., R. 27 E., Willamette Meridian, Oregon, designed to restore the corners in their true original locations according to the best available evidence, and the subdivision of sections 26 and 27.

The lottings and areas are as shown on the plats approved March 31, 1874 and November 29, 1881.

The survey was executed by Scott R. McMullin, Cadastral Surveyor, beginning August 2, 1982, and completed May 18, 1983, pursuant to Special Instructions dated July 21, 1982, for Group No. 1115, Oregon.

Timber in this area consists of pine, fir, larch, and juniper.

UNITED STATES DEPARTMENT OF THE INTERIOR
BUREAU OF LAND MANAGEMENT
Portland, Oregon October 26, 1984

This plat is strictly conformable to the approved field notes, and the survey, having been correctly executed in accordance with the requirements of law and the regulations of this Bureau, is hereby accepted.

For the Director

William W. Llanus

Chief Cadastral Surveyor of Oregon

RECEIVED AND
FILED

DEC 4 - 1984

OFFICE OF COUNTY SURVEYOR

Robert L. [Signature]
Attest: *Carol [Signature]*