


TOWNSHIP 11 SOUTH, RANGE 27 EAST, OF THE WILLAMETTE MERIDIAN, OREGON.

DEPENDENT RESURVEY AND SUBDIVISION OF SECTIONS 4, 5, 6, AND 9

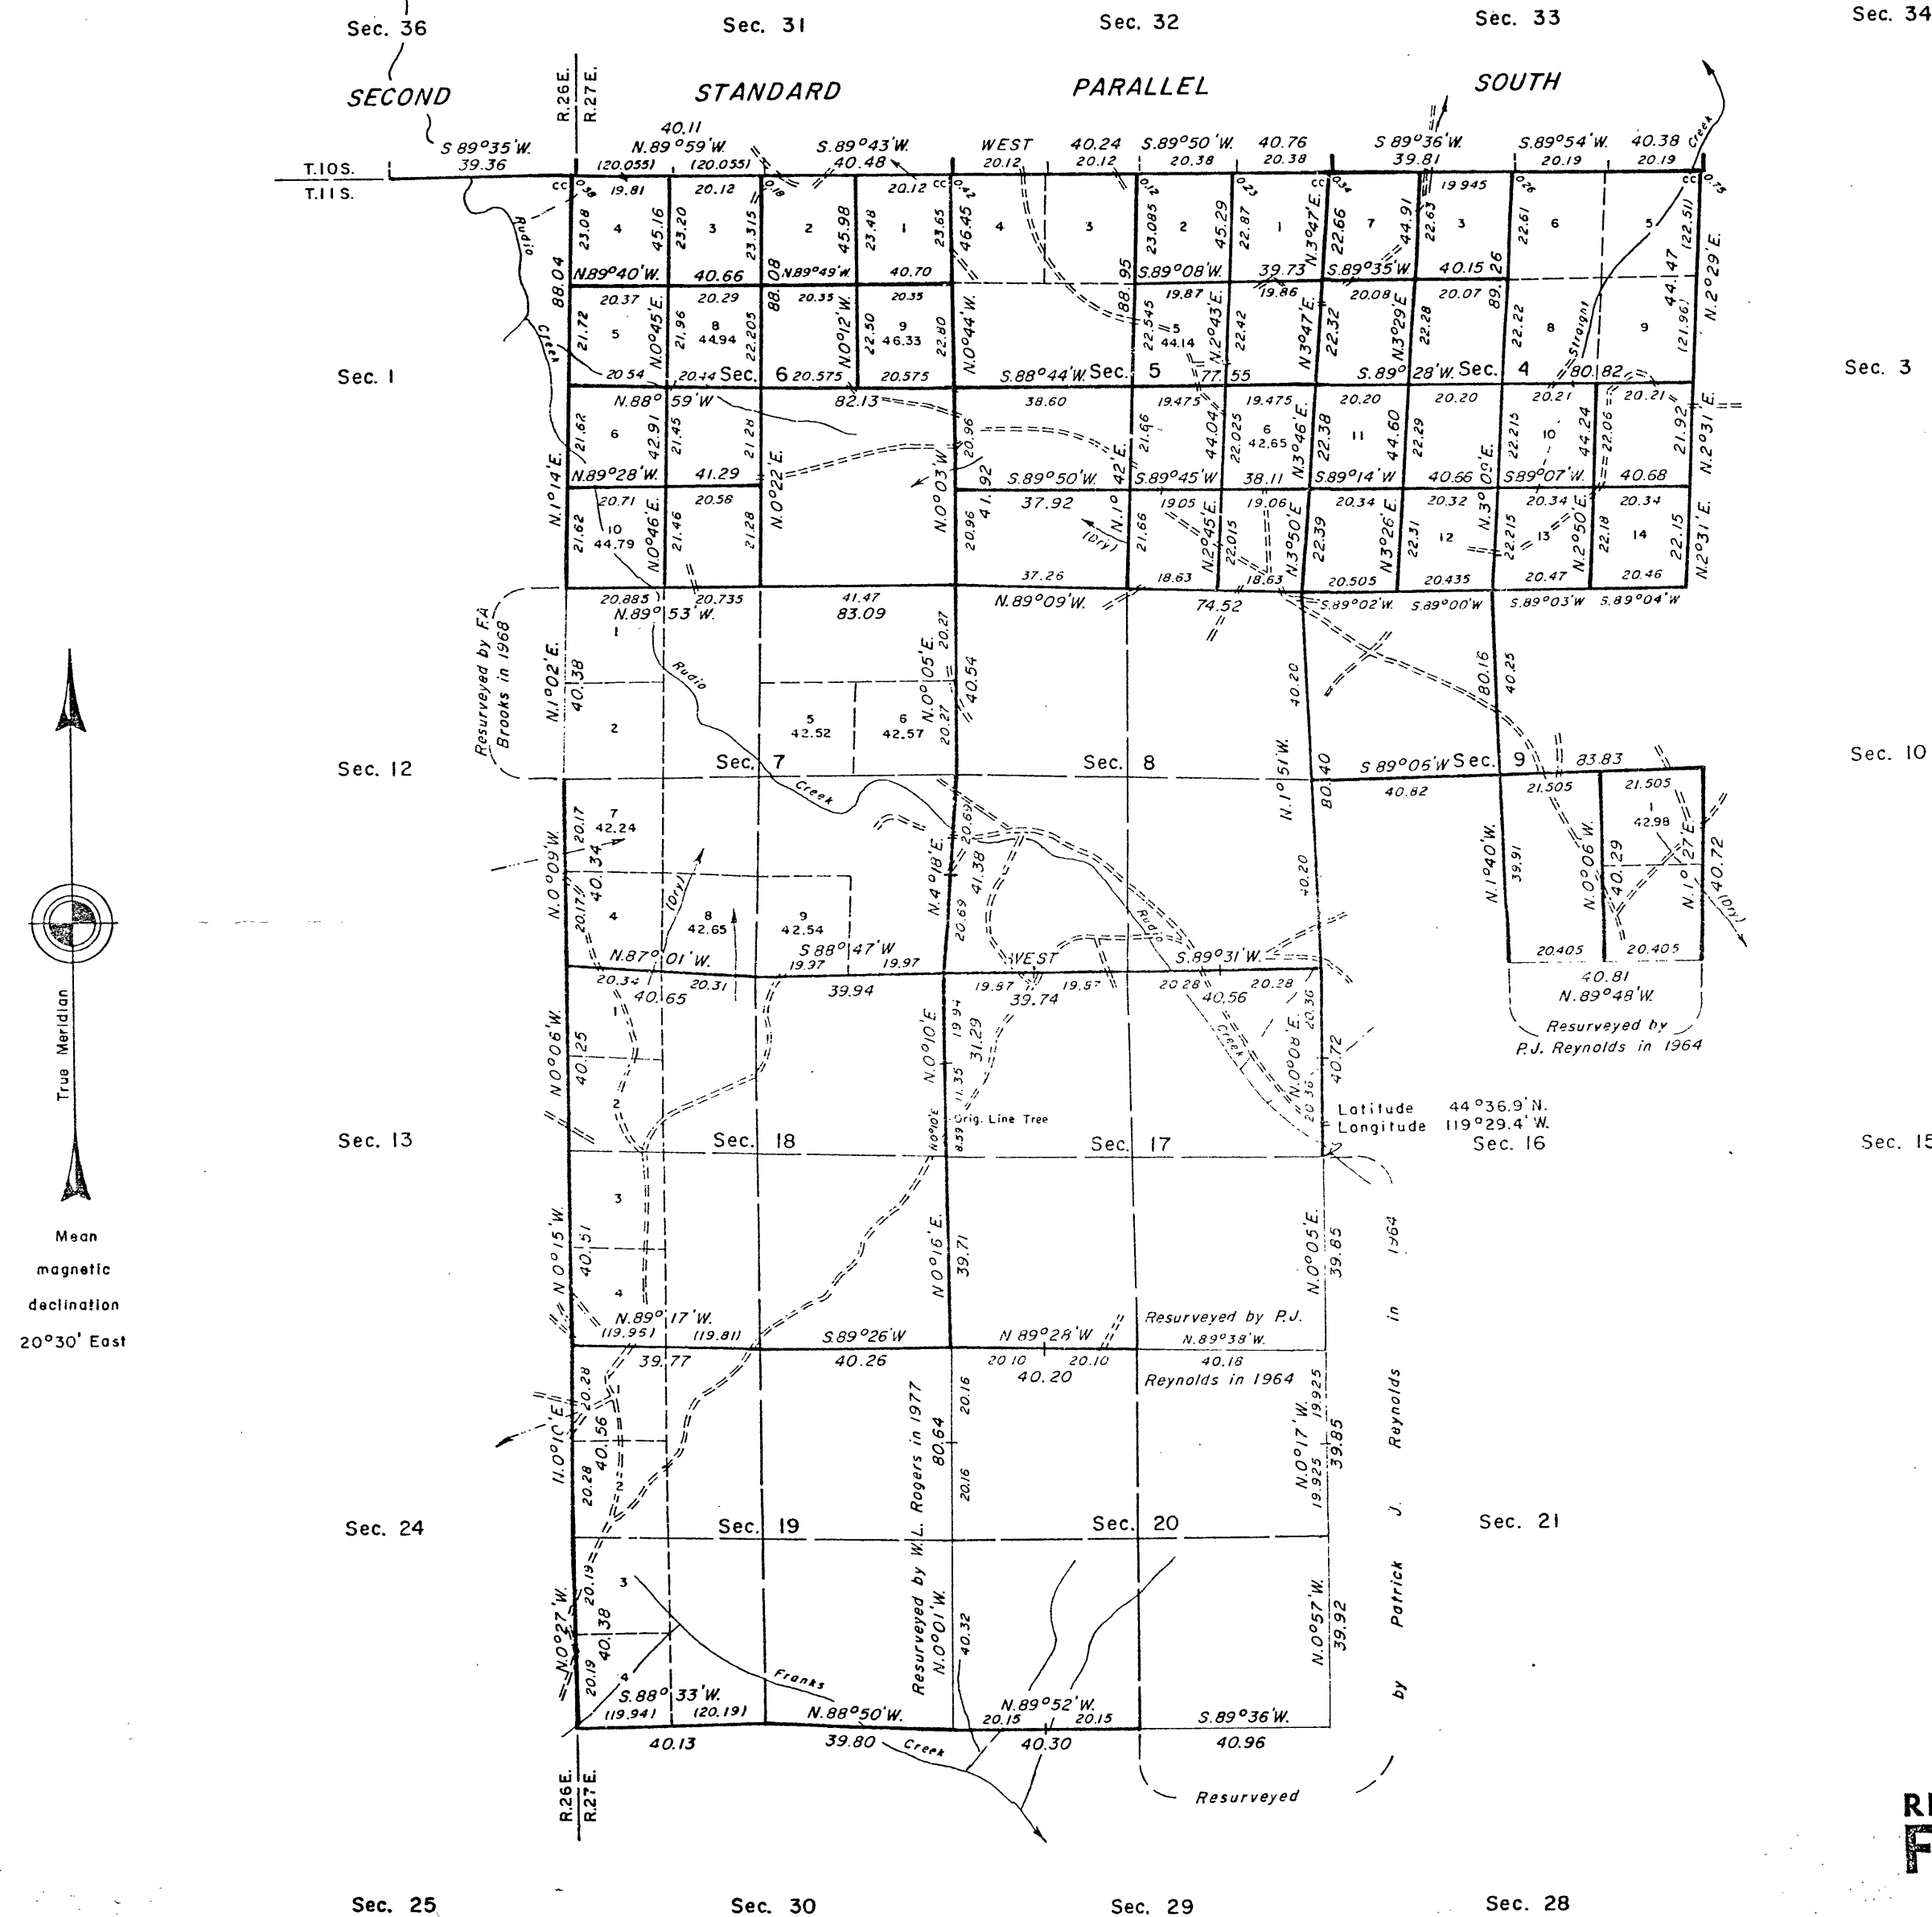

A history of surveys is contained in the field notes.

This plat represents a dependent resurvey of a portion of the Second Standard Parallel South through Ranges 26 and 27 East, and portions of the west boundary and subdivisional lines, T. 11 S., R. 27 E., Willamette Meridian, Oregon, designed to restore the corners in their true original locations according to the best available evidence, and the subdivision of sections 4, 5, 6, and 9.

Except as shown hereon, the lottings and areas are as shown on the plat approved January 17, 1881, and accepted August 28, 1980.

The survey was executed by Scott R. McMullin and Thomas E. Caster, Cadastral Surveyors, beginning September 13, 1982, and completed August 25, 1983, pursuant to Special Instructions dated August 16, 1982, and Supplemental Special Instructions dated March 7, 1983, for Group No. 1116, Oregon.

Timber in this area consists of fir, pine, larch, and juniper.

UNITED STATES DEPARTMENT OF THE INTERIOR
BUREAU OF LAND MANAGEMENT
Portland, Oregon October 26, 1984

This plat is strictly conformable to the approved field notes, and the survey, having been correctly executed in accordance with the requirements of law and the regulations of this Bureau, is hereby accepted.

For the Director

William W. Hlem

Chief Cadastral Surveyor of Oregon

RECEIVED AND
FILED

DEC 4 - 1984

OFFICE OF COUNTY SURVEYOR

Attest: *Robert D. Rogers*
Attest: *Carole D. Rogers*