


LEGEND

SET A 2 1/2" O.D. X 30" LONG ALUMINUM PIPE WITH 3 1/4" ALUMINUM CAP MARKED AS PER CORNER DIAGRAM SHOWN ON CORNER SUMMARY.

INDICATES U.S.F.S. PROPERTY BOUNDARY POSTED UNDER THIS CONTRACT WITH 6 FOOT LONG STEEL FENCE POSTS WITH U.S.F.S. PROPERTY BOUNDARY SIGNS ATTACHED (54-2).

RECORD SURVEY INFORMATION BY JAMES P. CURRIN, DEPUTY SURVEYOR, UNDER GENERAL LAND OFFICE CONTRACT NO. 348 DATED JANUARY 22, 1880.

CORNER MONUMENT NUMBER-SEE CORNER SUMMARY FOR ADDITIONAL INFORMATION.

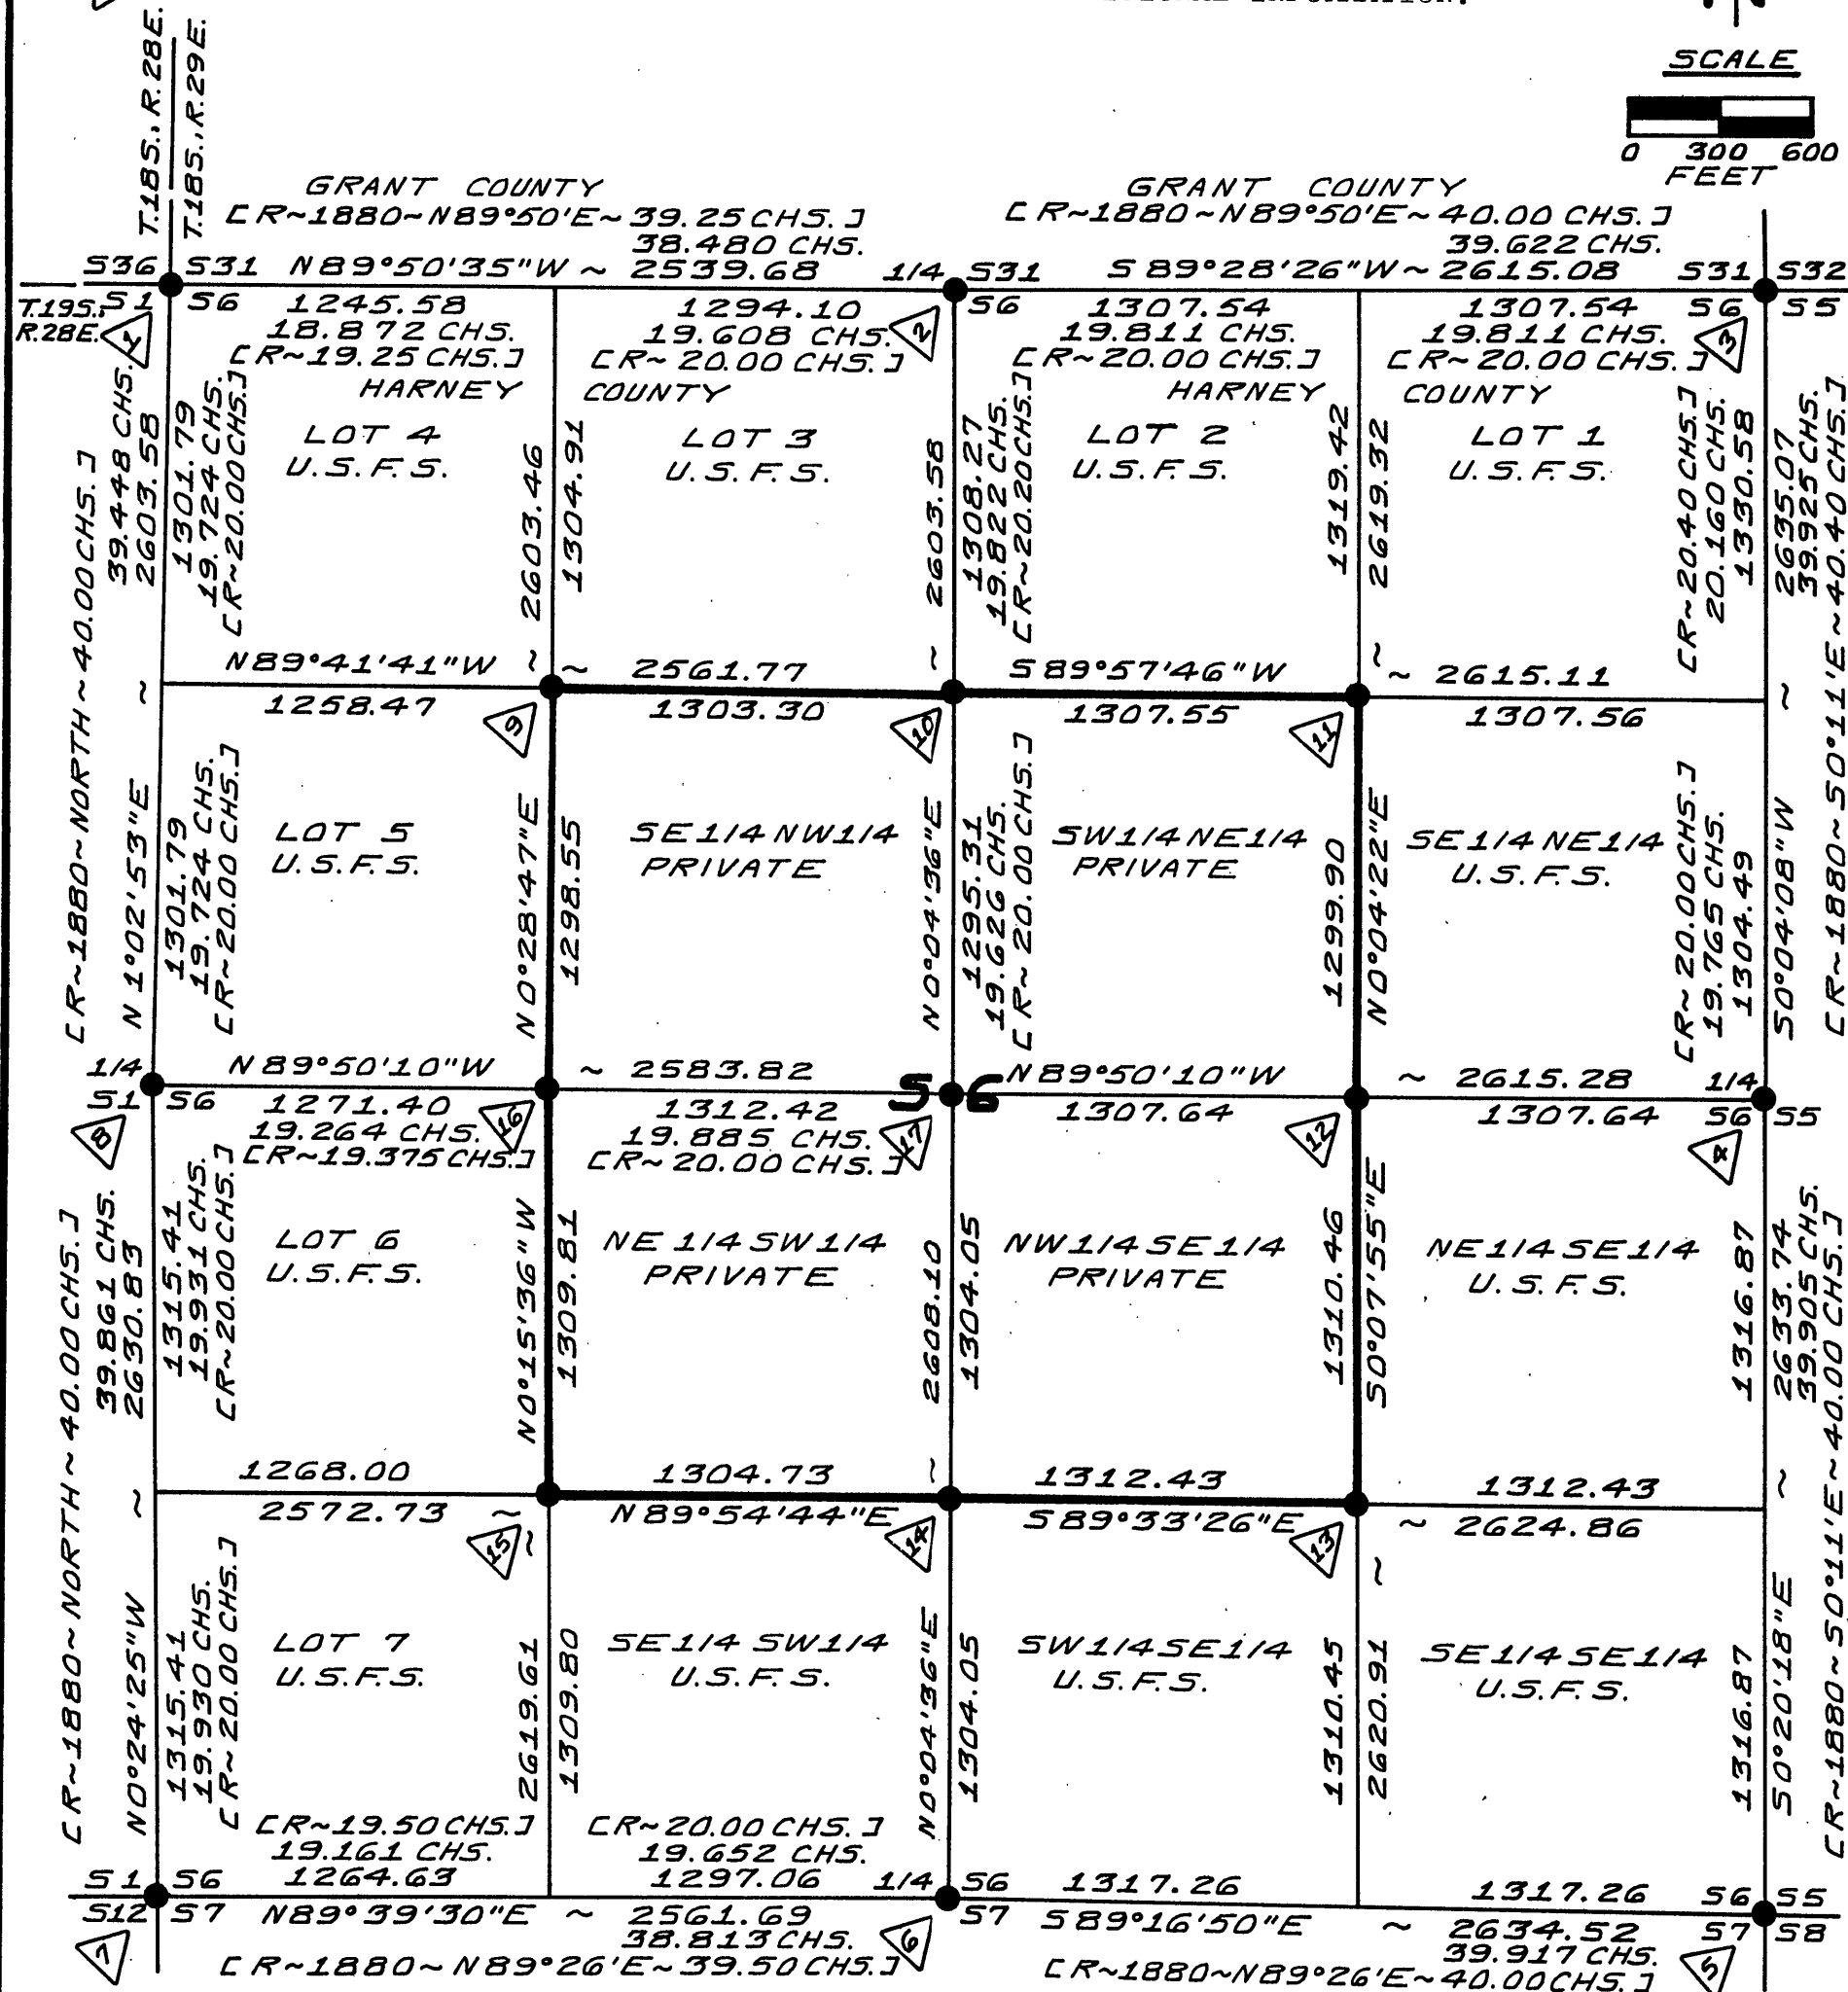

RECORDATION
OFFICE OF COUNTY SURVEYOR,
COUNTY OF Grant,
STATE OF OREGON. I HEREBY
CERTIFY THAT THE WITHIN IN-
STRUMENT WAS FILED FOR RECORD
ON THE 18 DAY OF Jan,
1985.
Robert D. Dwyer
COUNTY SURVEYOR

SURVEY FOR SUBDIVISION OF SECTION 6, TOWNSHIP
19 SOUTH, RANGE 29 EAST, W.M., HARNEY COUNTY,
OREGON
MALHEUR NATIONAL FOREST
DON CADASTRAL SURVEY-BURNS RANGER DISTRICT
CONTRACT NO. 53-04H1-3-9357N

ARMSTRONG SURVEYING & ENGINEERING, INC.
378 EAST SECOND STREET
PRINEVILLE, OREGON 97754
503/447-7791

SHEET 1 OF 4

REGISTERED
PROFESSIONAL
LAND SURVEYOR
David B. Armstrong
1/9/85 CHS 111
AUGUST 22, 1975
DAVID B. ARMSTRONG
1023
W.O.83-414 A

MAP OF SURVEY NO. 854