


LEGEND

- SET A 2 1/2" O.D. X 30" LONG ALUMINUM PIPE WITH 3 1/4" ALUMINUM CAP MARKED AS PER CORNER DIAGRAM SHOWN ON CORNER SUMMARY.
- INDICATES U.S.F.S. PROPERTY BOUNDARY POSTED UNDER THIS CONTRACT WITH 6 FOOT LONG STEEL FENCE POSTS WITH U.S.F.S. PROPERTY BOUNDARY SIGNS ATTACHED (54-2).
- [J RECORD SURVEY INFORMATION BY JAMES P. CURRIN, DEPUTY SURVEYOR, UNDER GENERAL LAND OFFICE CONTRACT NO. 348 DATED JANUARY 22, 1880.
- 1 CORNER MONUMENT NUMBER-SEE CORNER SUMMARY FOR ADDITIONAL INFORMATION.

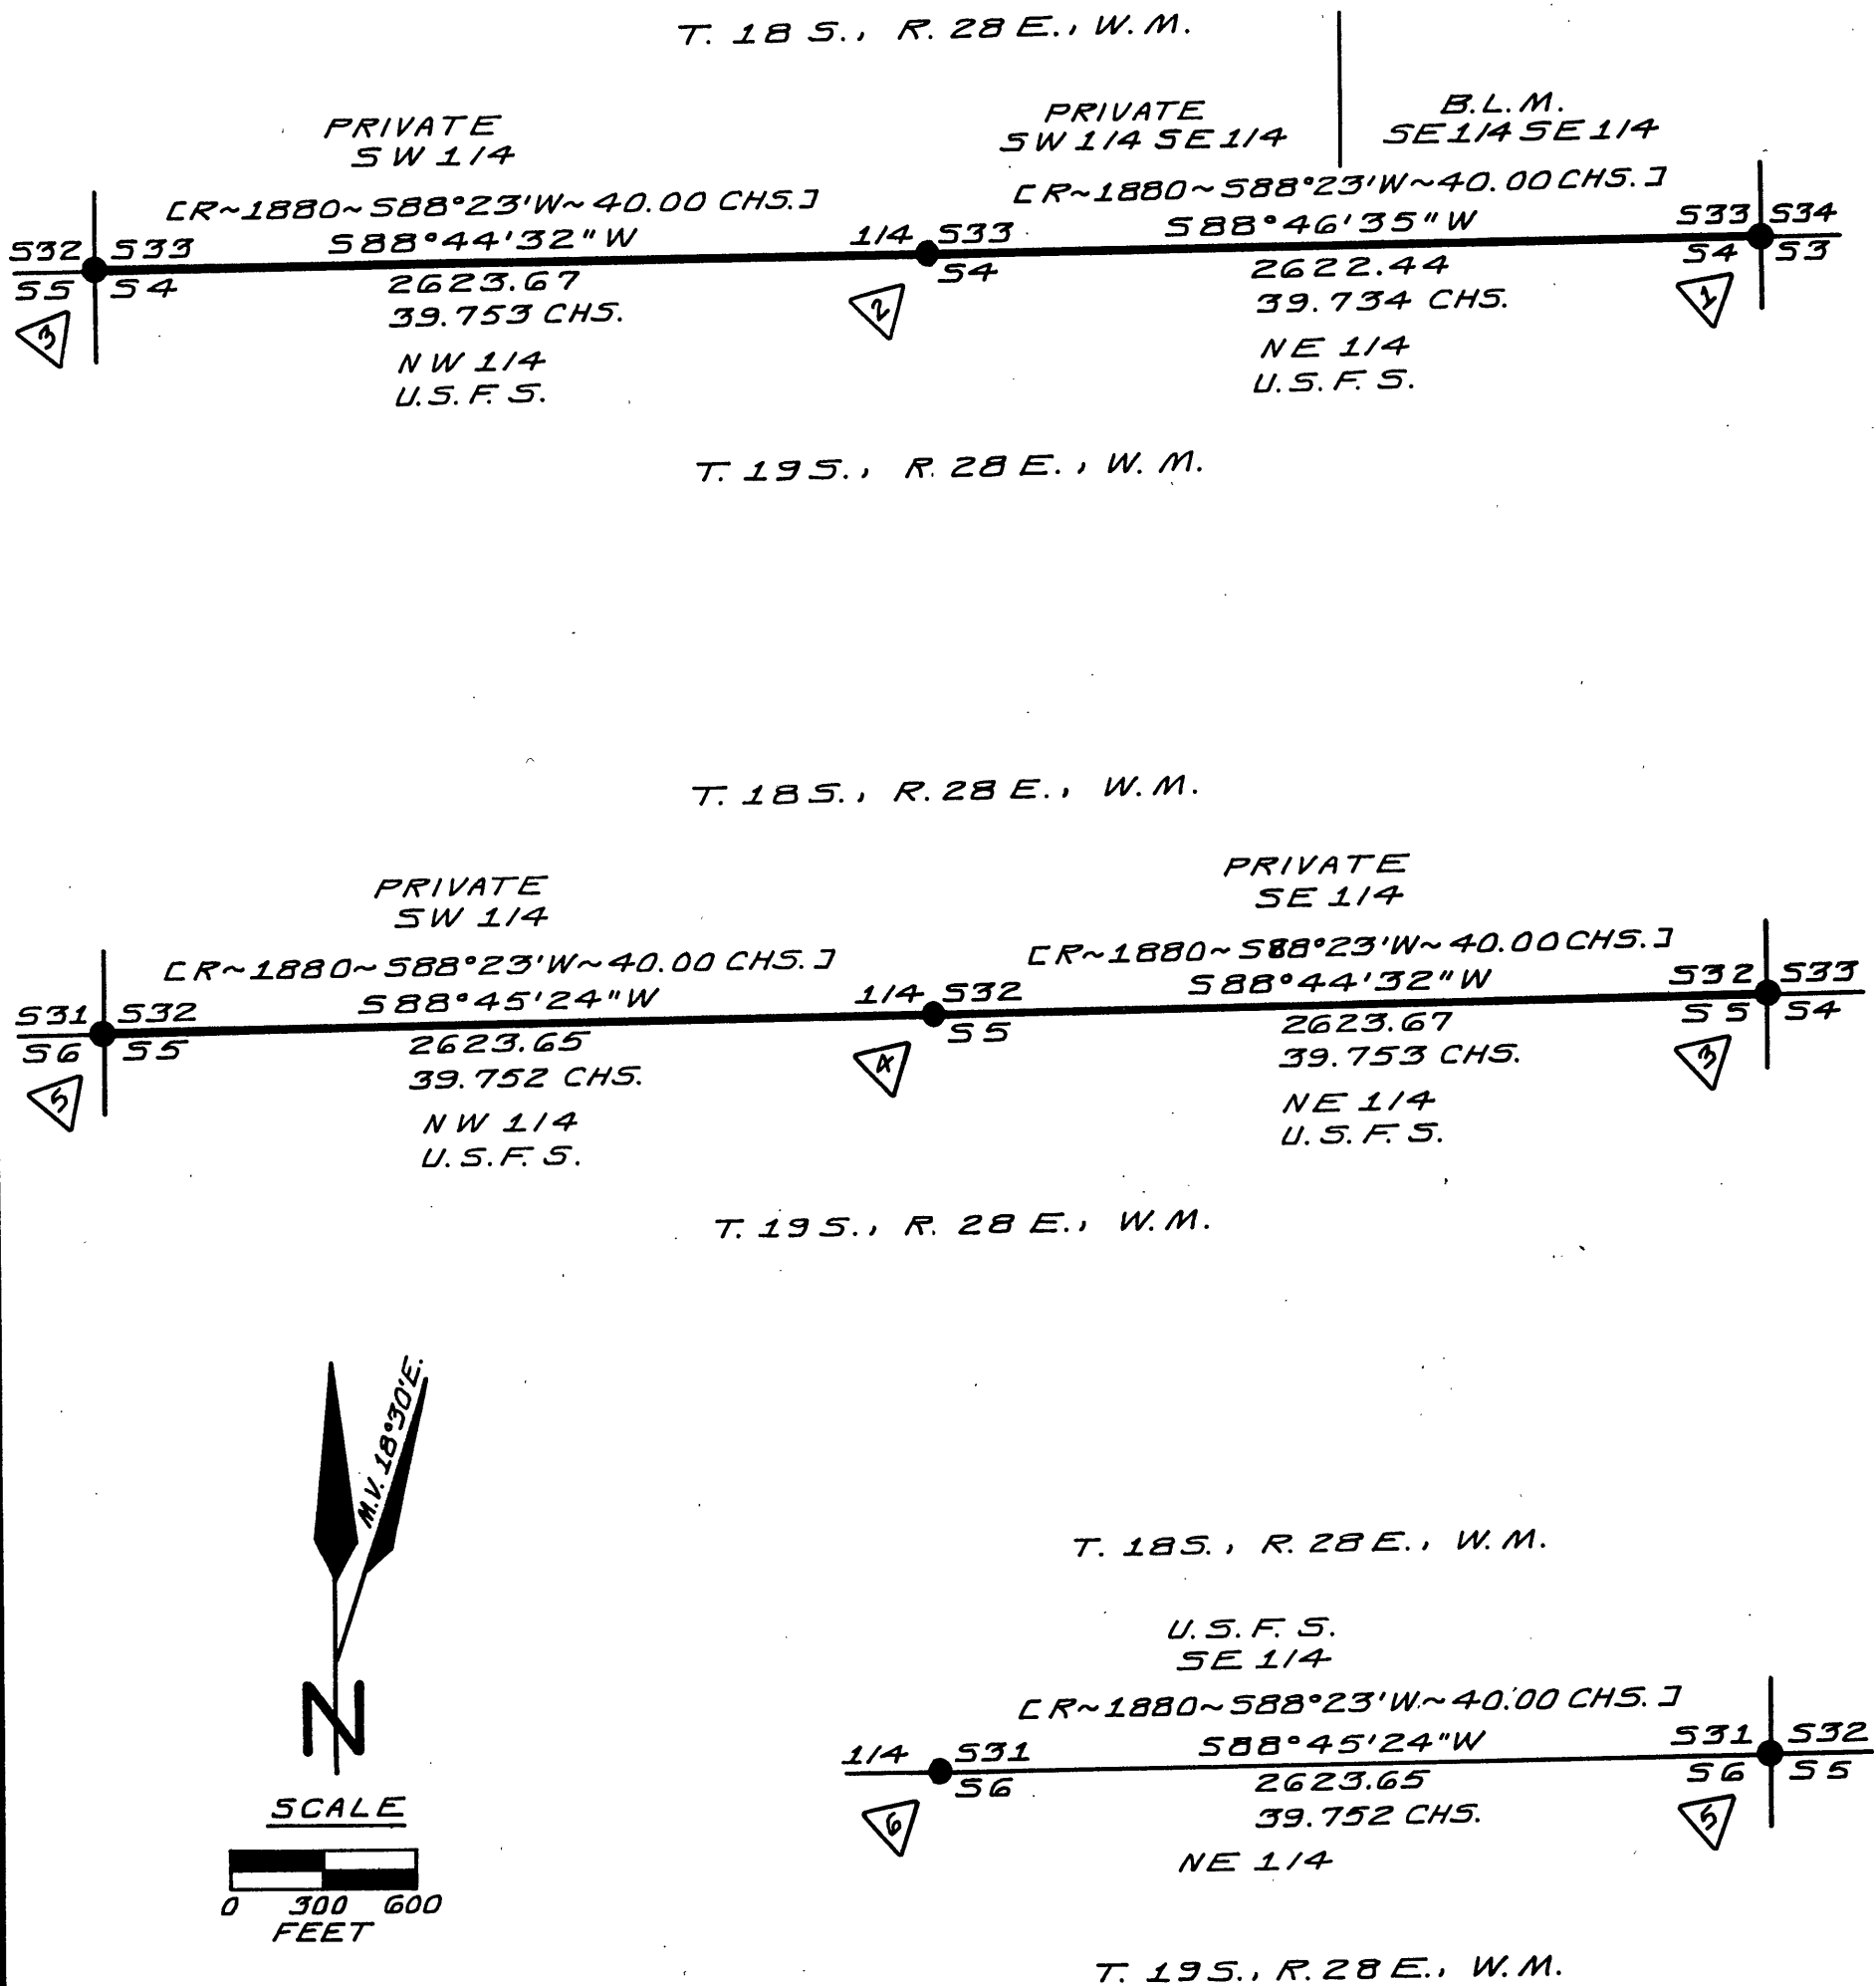

RECORDATION
OFFICE OF COUNTY SURVEYOR,
COUNTY OF Grant,
STATE OF OREGON. I HEREBY
CERTIFY THAT THE WITHIN IN-
STRUMENT WAS FILED FOR RECORD
ON THE 18 DAY OF Jan,
1985.

Robert D. Day
COUNTY SURVEYOR

SURVEY RETRACEMENT OF TOWNSHIP LINE COMMON TO
SECTIONS 4, 5 AND 6, T.19S., R.28E., W.M., AND
SECTIONS 31, 32 AND 33, T.18S., R.28E., W.M.,
HARNEY AND GRANT COUNTIES, OREGON
MALHEUR NATIONAL FOREST
DON CADASTRAL SURVEY-BURNS RANGER DISTRICT
CONTRACT NO. 53-04H1-3-9357N

ARMSTRONG SURVEYING & ENGINEERING, INC.
378 EAST SECOND STREET
PRINEVILLE, OREGON 97754
503/447-7791

SHEET 1 OF 3

REGISTERED
PROFESSIONAL
LAND SURVEYOR

David B. Armstrong

1/9/85 OREGON
AUGUST 22, 1973
DAVID B. ARMSTRONG
1023

W.O. 83-414 D

MAP OF SURVEY NO. 856