


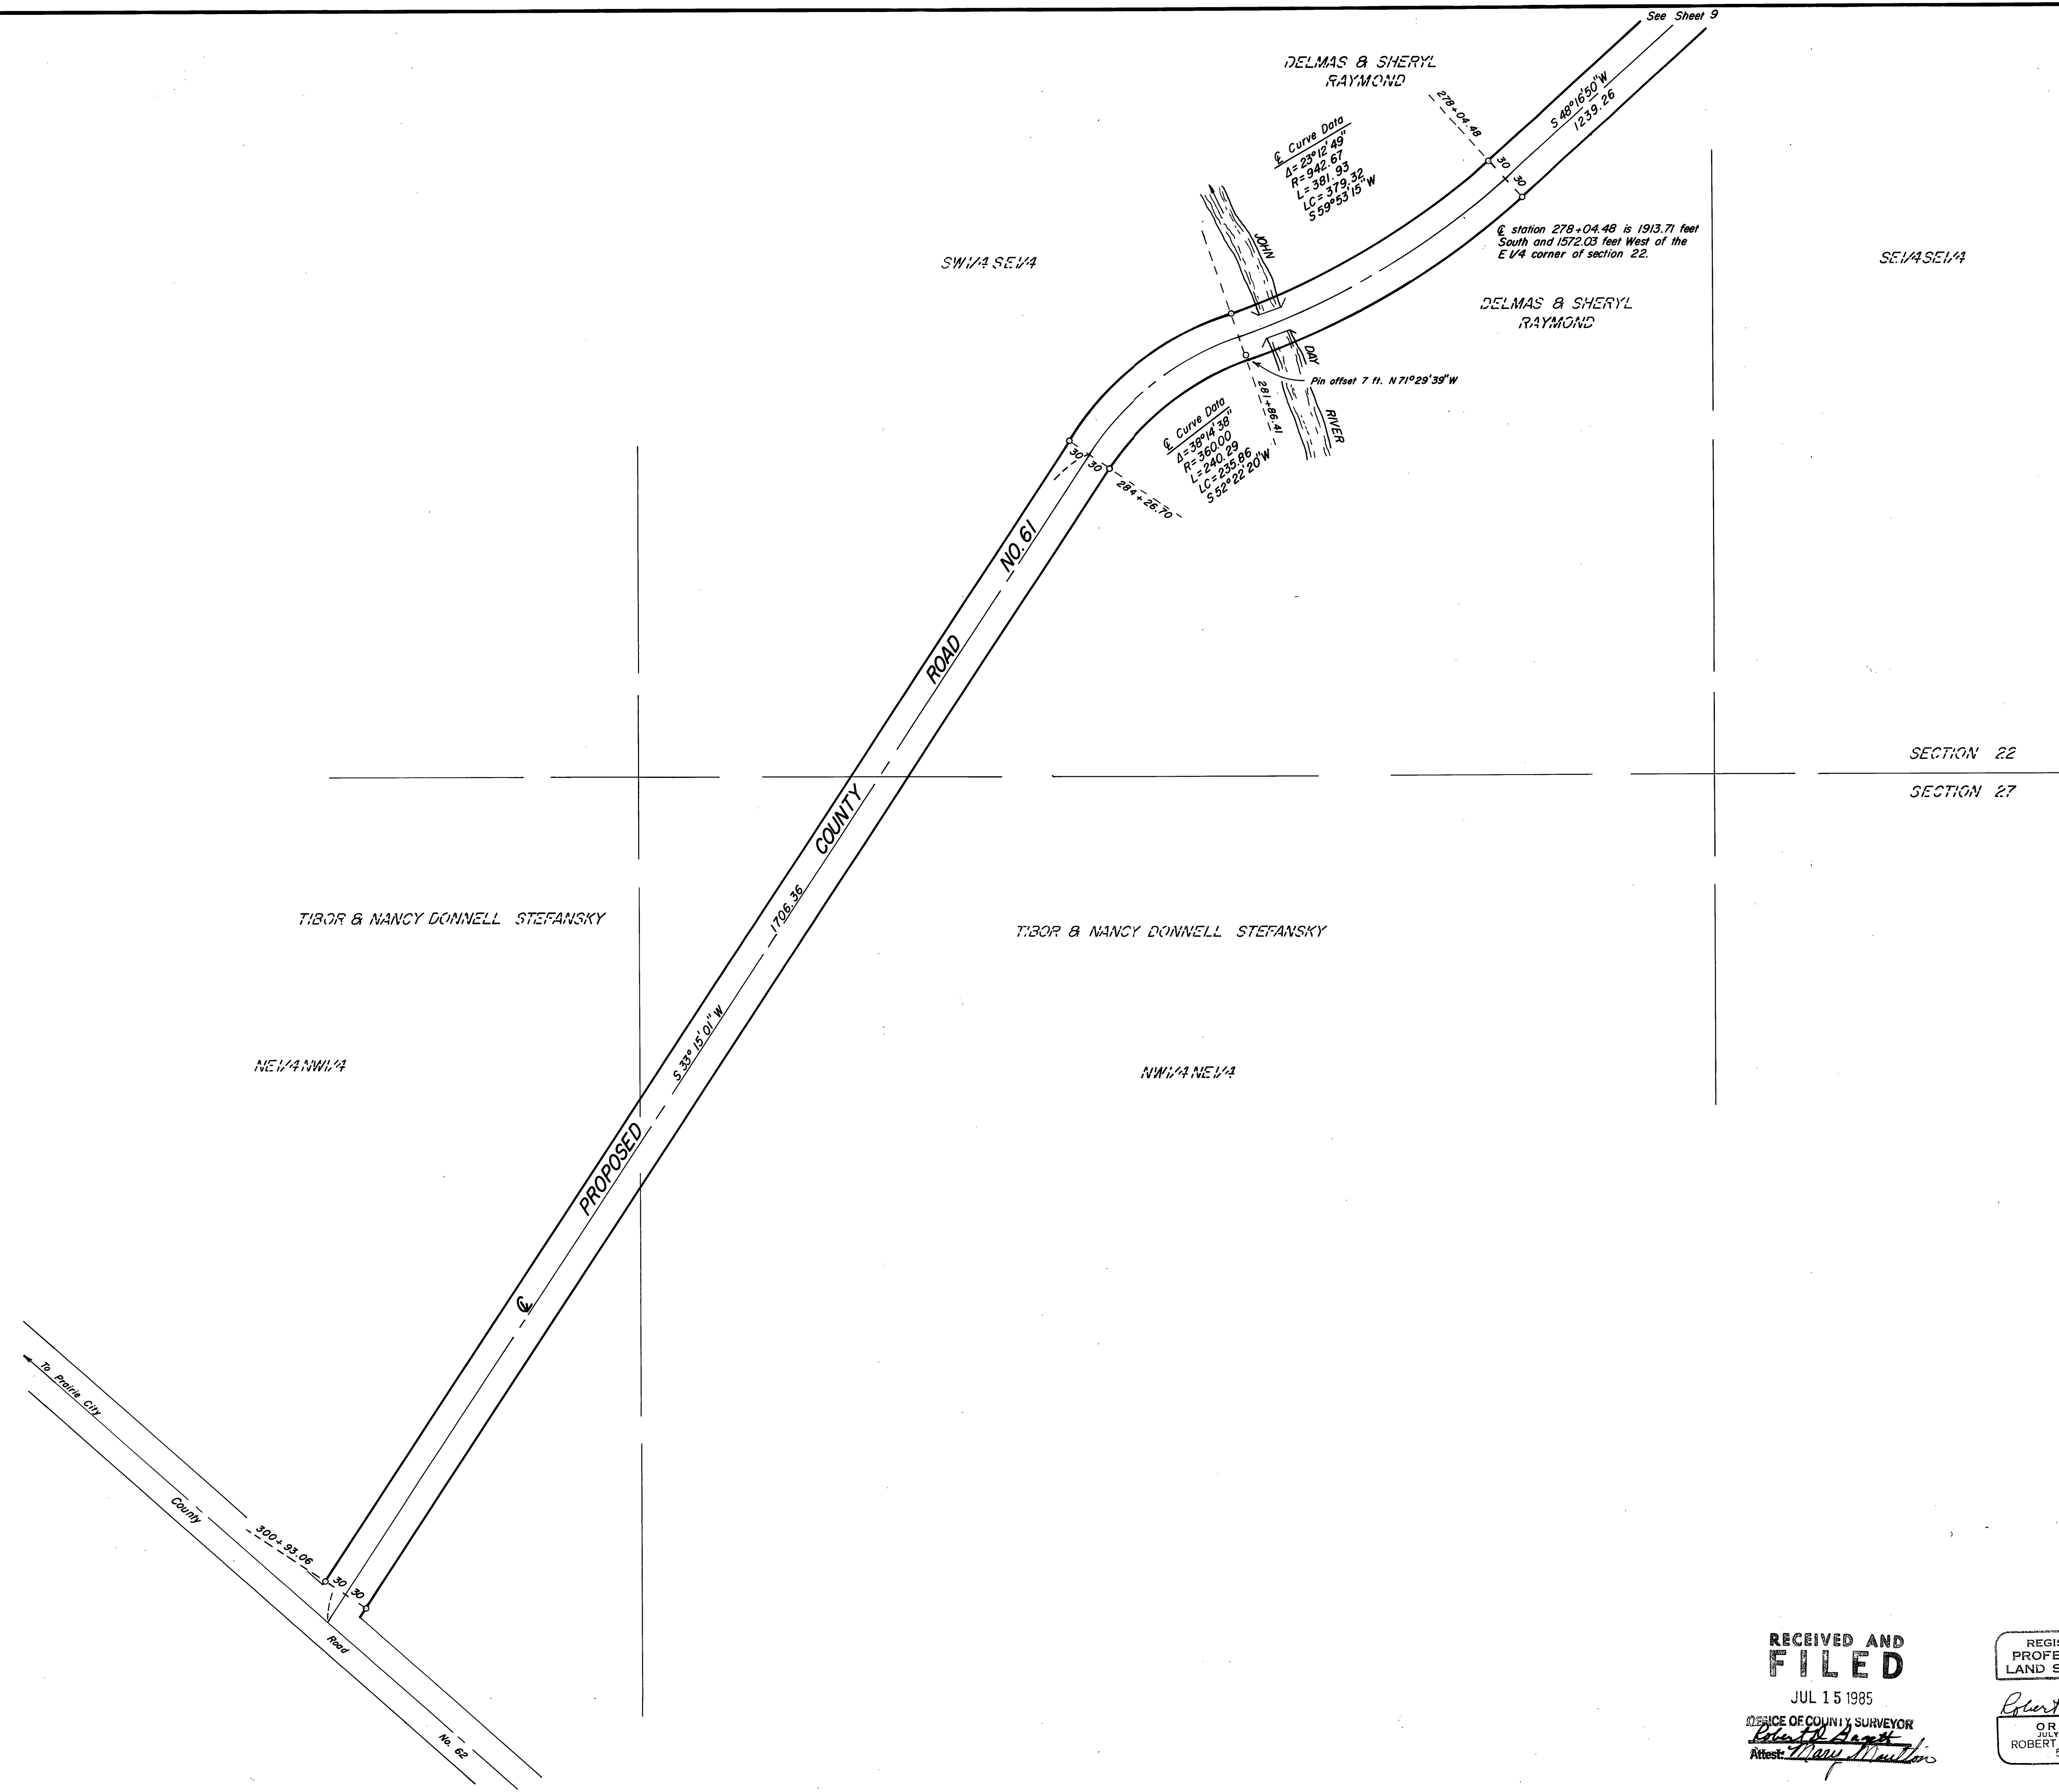

RECEIVED AND
FILED
JUL 15 1985
OFFICE OF COUNTY SURVEYOR
Robert D. Baggett
Attest: Mary Newton

REGISTERED
PROFESSIONAL
LAND SURVEYOR
ROBERT D. BAGGETT
598

SHEET 10 OF 10		
BAGETT, GRIFFITH & ASSOCIATES John Day, Oregon		
PROPOSED COUNTY ROAD NO. 61		
GRANT COUNTY OREGON		
Surveyed For	GRANT COUNTY ROAD DEPARTMENT	
Surveyed By	R.D.B. & J.L.W. & T.O.S.	Feb-June '85
Scale: 1"=100'	Drawn by: J.L.W.	June '85