
TIIS R26E PAUL HOFFMAN NEI/ANWI/A NW 1/4 NW 1/4 SEC. 19 | SEC. 20 ROB MUNRO SWIM NWIM SEV4NWI/4 Monuments referencing Q were set on the bisect line of each angle point so as to produce 15 ft. offset lines on each side of the surveyed centerline. Dimensions shown are along the surveyed centerline. Section and section subdivisional lines shown are protracted for general information only. The width of the original roadway varies from 8 to 12 feet.

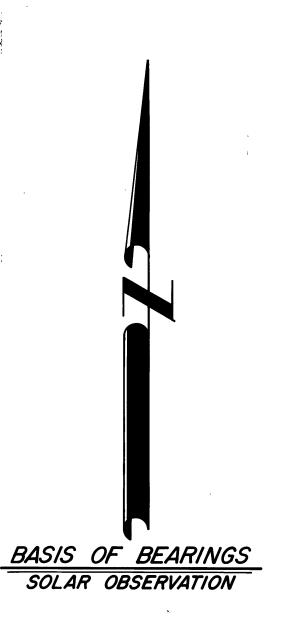

LEGEND

- Set 5/8"x 30' iron pin with attached yellow plastic cap marked B·G·A SURVEY MARKER
- Set pk nail

REFERENCES

Record Map of Survey No. 571

NARRATIVE: This survey was performed at the request of Lorene Allen, Grant County Judge. The purpose of this survey was to locate and describe the lower portion of the Dick Creek Road in its historic location.

I began by asking Rob Roy Munro, a local rancher who had been raised on, and had once owned the land that this road is located on, to point out to me the old location of the road. Mr. Munro came with us and showed us the original location of the road. Once Mr. Munro pointed out the original road location to us, we could identify the old cuts, fills, ruts, and general route of the road. Some of the old juniper logs still exist at the original lower crossing of Dick Creek.

We located, by survey, the center of this road and set monuments along the way, 15 feet on each side of the centerline of the road as described and shown hereon. 40d nails were set at the & angle points.

I found no prior record of this road having been located by survey.

REGISTERED
PROFESSIONAL
LAND SURVEYOR

OREGON
JULY 12, 1983
ROBERT D. BAGETT.
5 9 8

JUL 15 1985

JUL 15 1985

GEOGRAPHICA OF COUNTY SURVEYOR

Affect Hary Harden

BAGETT, GRIFFITH & ASSOCIATES

John Day, Oregon

MAP OF A SURVEY SITUATED IN THE SI/2 NWI/4 OF SECTION 20 TIIS, R 26 E, W.M.

SURVEYED FOR GRANT COUNTY ROAD DEPARTMENT
SURVEYED BY
R.D.B. & J.L.W. & T.O.S. Jan. & June'85
Scale: I"= 100' Drawn by J.L.W. 7/1/85