

CORNER ACCESSORIES

14	13	Orig. BT's
23	24	A pine bears N 75°W, 17.1 feet A pine bears S 54°W, 28.9 feet A pine bears N 45°E, 18.5 feet
		New BT
		A pine bears S 9°E, 47.0 feet
23	24	New Reference monuments
26	25	A 5/8" x 30" rebar bears N 45°E, 25.0 feet A 5/8" x 30" rebar bears S 45°E, 25.0 feet
		New BT's
		A pine bears S 45°W, 114.0 feet A pine bears N 87°W, 198.6 feet
1/4	24	Orig. BT's
	25	A pine stump bears N 63°E, 4.6 feet A pine stump bears South, 33.6 feet
		New BT's
		A pine bears N 17°E, 15.8 feet A pine bears S 20°E, 15.4 feet
23		New BT's
E 1/16		A pine bears N 42°E, 97.7 feet A pine bears S 37°E, 93.4 feet

NOTE: For corner accessory details see recorded monumentation sheets filed separately.

HISTORY OF SURVEYS

The subdivision of T15S, R30E, W.M. was originally surveyed by Samuel Lackland under contract no. 357 dated 1880.

The NW 1/4 cor. & E 1/4 cor. sec. 26 remonumented from original evidence by Robert D. Bagett as recorded on map of survey no. 444, dated April 1977.

NARRATIVE

This survey was performed under contract for the Malheur National Forest. The purpose of this survey was to establish the E 1/16 corner between sections 23 and 26 also to mark the National Forest Boundary line along the NW 1/2 E 1/2 of the south line of section 23. A search was made of the available records pertaining to this survey. Field measurements were made to locate existing monuments. New monuments were set in accordance with the evidence found as shown hereon. This survey involved locating the SE corner of section 23. A search was made of the area but no reliable corner evidence was found. The original monument was a wood post. I find no record of any subsequent remonumentation of this corner. The corner position falls in a grassy glade which has been used for cattle pasture for many years. There were no corner accessories referencing this corner. The 1/4 corners 1/2 mile south, east, and west were found and tied. No evidence of the E 1/4 corner of section 23 was found. The original monument being a wood post with two aspen bearing trees. The area of this 1/4 corner is in an old beaver colony. If the aspen BT's did survive the elements of time, which I doubt, then the beavers did fall them for their dams. We traversed a 1/2 mile north and tied the NE corner of section 23. We then returned to search again for the E 1/4 corner and the SE section corner at proportionate measure but found no evidence of either one. I established the SE corner of section 23 at double proportionate measure from the found NE corner of section 23; the found S 1/4 corner of section 24; the found S 1/4 corner of section 23; and the found E 1/4 corner of section 26. We then set the E 1/16 corner between sections 23 and 26 on line at the midpoint between the S 1/4 corner of section 23 and the proportionate SE corner of section 23 and marked the forest boundary line as shown hereon with 6 foot steel fence posts and attached National Forest Boundary signs. I found no unusual conditions with this survey.

SURVEYOR'S STATEMENT

I, Robert D. Bagett, registered land surveyor in the State of Oregon, hereby certify that this plot and the notes hereon, or attached are a true and correct representation of the survey I made in July - August 1985, at the request of the USDA Forest Service, in accordance with the statutes of the State of Oregon and the articles of my contract.

RECEIVED AND
FILED
SEP 14 1985
OFFICE OF COUNTY SURVEYOR
Robert D. Bagett
Attest: Ellen S. Felton

Robert D. Bagett
Robert D. Bagett
OPLS 598

REGISTERED
PROFESSIONAL
LAND SURVEYOR
ROBERT D. BAGETT
598


BASIS OF BEARINGS

SOLAR OBSERVATION
TAKEN AT THE NW CORNER SECTION 15
T15S R30E W.M.

MAGNETIC DECLINATION 20°E

LEGEND

- Found Grant County Surveyor Brass Cap
- Found original evidence, Set 2-1/2" x 30" aluminum pipe with attached aluminum cap.
- Set 2-1/2" x 30" aluminum pipe with attached aluminum cap.
- x — x Fence line
- () Record G.L.O. bearing and distance
- SFNF Searched for not found
- Posted national forest boundary line

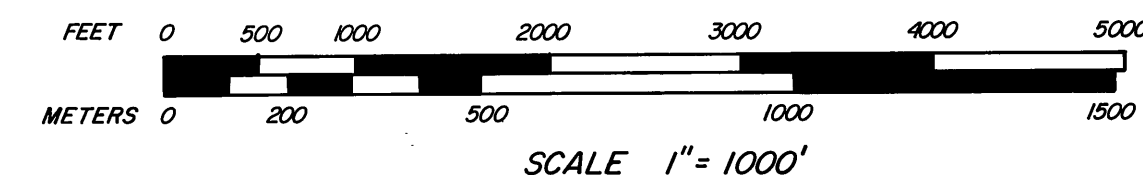

BAGETT - GRIFFITH & ASSOCIATES John Day, Oregon		
MAP OF SURVEY DEPENDENT RESURVEY SITUATED IN SECTIONS 23, 24, 25 & 26, T15S, R30E, W.M.		
GRANT COUNTY, OREGON		
SURVEYED FOR	MALHEUR NATIONAL FOREST	
SURVEYED BY	R.D.B. & J.L.W. & T.R.S.	July-Aug '85
Scale: 1" = 1000'	Drawn by: J.L.W.	Aug '85