

Narrative

This survey was requested by Wes Johnson for the purpose of dividing a single parcel of land into two parcels. The line surveyed was established by a panel of three referees appointed by the court. Because of the property being in the same ownership on both sides of the surveyed line, the only problem encountered was the difficult access to the south line of section 2. No other problems were encountered and the survey was completed as shown.

Basis of Bearing

C.S. 248 establishing the South line of section 2 as N 85° 31' W as shown

References

C.S. 339
C.S. 614
C.S. 248

Deed in Book 130, Page 989 filed in Grant County Court House
(Deed being divided supplied by Wes Johnson)

Legend

- Found 5/8" rebar or as described at location
- Set 5/8" x 30" rebar with cap marked 'L.S. 1952'
- Existing fence
- Newly established line
- () Original survey distance or bearing


Fnd. 2 1/2" B.L.M. Brass Cap
Marked T14S, R31E
1/4 S 2
S 11
1968
C.S. 248

Fnd 2 1/2" B.L.M. Brass Cap
Marked E 1/16 S 2
S 11
1968
C.S. 248

RECEIVED AND
FILED

OCT 17 1985

OFFICE OF COUNTY SURVEYOR
Robert D. Blaylock
Norman J. Paullus Jr.

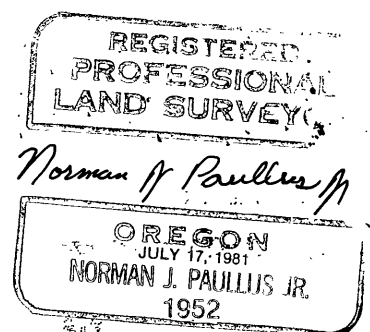

Paullus-Chevalier & Associates

La Grande, Oregon

Location
Located in the S.E. 1/4 of Sec. 2, T.14S., R.31E., W.M. in
Grant County, Oregon

For Owen S. Graham

By: NJP 9/85

Scale 1"=200'

Drawn by NJP 9/85

Page 1 of 1