


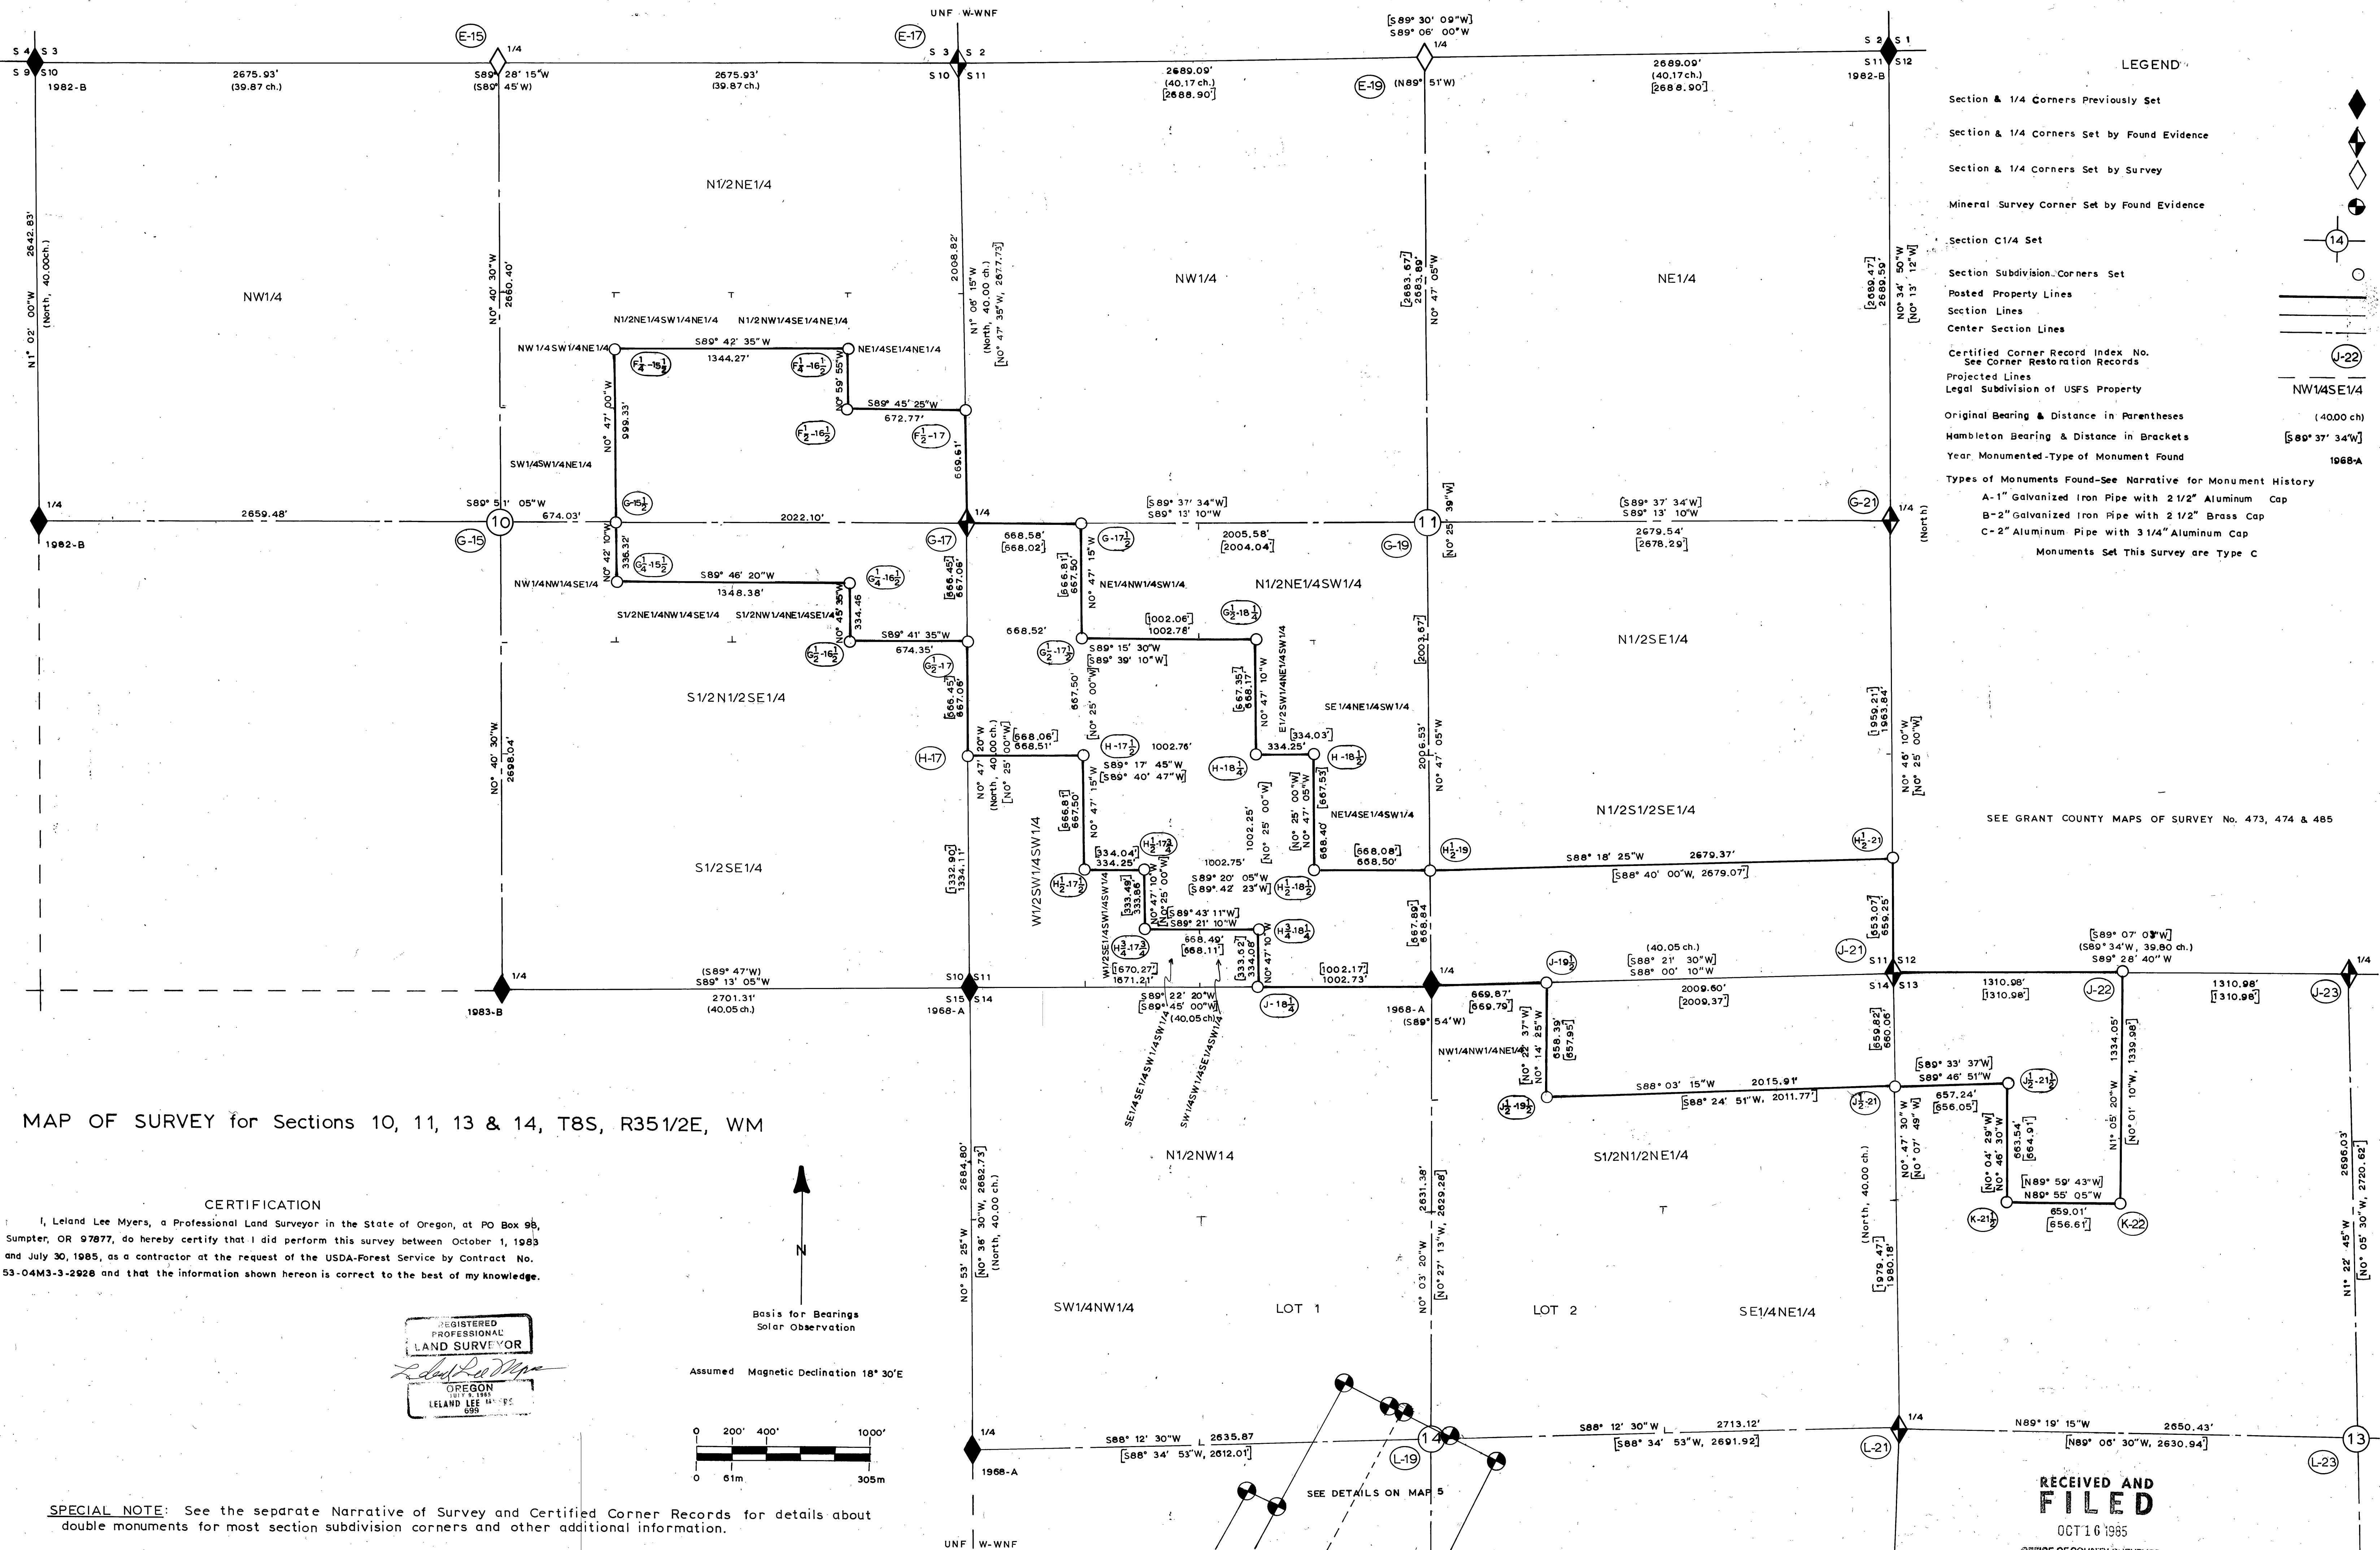

See Map 4

RECEIVED AND
FILED

OCT 16 1985

OFFICE OF COUNTY SURVEYOR

Rohrer & D. Baggett

Map 3 of 6

MAP OF SURVEY NO. 894